WATER WELL REC	CCORD Form WWC-5 Correction Change in Well Ust				Division of Water sources App. No.		Well ID	MW17	
1 LOCATION OF V	VATER WELI	.:	Fraction	CHI V NIII		er Township Nur			
County Johnson 2 WELL OWNER:	14 N		NW ¼ NW ¼ First:	SW ¼ NW	1/4 29	T 12		5 X E W	
Business: Mac's 66,			riist.		own or intersection	•			
Address: 8139 Met	calf Ave.		$ \epsilon $	5921 W 81st St.,	Overland Park, KS				
Address: City Overla	nd Park St	tate: KS	ZIP: 66204						
3 LOCATE WELL	4 D	EPTH OF CON	IPLETED WELL:	10 ft	5 Latitude:	***************************************		cimal degrees)	
WITH "X" IN SECTION BOX:	Depth(s) Groundwater E	ncountered: 1) ft, or 4)I	ft Dry Well	Longitude Horizontal		·······	cimal degrees) 83 NAD 27	
N		STATIC WAT				Latitude/Longitude		7.1.20	
			e, measured on (mo-da		, <u> </u>	unit make/model:	1)	
v NW NE	Pumr	above land surfac test data: Well	e, measured on (mo-day water was	y-yr) fi	· — `	AAS enabled? Survey Topos)	
w	1 1		rs pumping						
"		Wa	ter well was	ft	6 Elevation	1047.29 ft	Ground L	evel X TOC	
SW ——— SE		ated Yield:	rs pumping gpm	gрш	I	Land Survey		Topographic Man	
		Hole Diameter:	7.25 in to	fi, and					
S	_		in to	fi					
7 WELL WATER TO	BE USED AS:				<u> </u>		,,,		
1 Domestic:	=	ublic Water Sup	•			Water Supply: leas	e		
Household Lawn & Garden	_	Dewatering: how Aquifer Recharge			11 Test Hole: well	I ID	Geotechnic	al	
Livestock		Monitoring: well			12 Geothermal: Ho		George inne		
2 Irrigation		onmental Remed	iation: well ID		a) Closed Loc	· ==			
3 Feedlot	=	Air Sparge	Soil Vapor Extracti	ior	b) Open Loop		ischarge	Inj. of Water	
4 Industrial		Lecovery	Injection		Other (spe				
Was a chemical/bacteriolo Water well disinfected?	gical sample sul	omitted to KDF	IE? Yes X	No If yes,	date sample was su	ıbmitted:	·····		
8 TYPE OF CASING		eel X PVC	Other	CASING	IOINTS: Gli	red Clampled	Welded	X Threaded	
Casing diameter 2	in. to 3	ft, Diamet	er in t	o ft,	Diameter	in. to	ft,	1111111111111	
Casing height above land su TYPE OF SCREEN OR	rface -0.39			lbs./ft. W	ell thickness or gau	ge No	••••••		
	ess Steel	NMATERIAL Fiberglass	X PVC		Other (Specify)				
	nized Steel	Concrete tile	None used (ope	n hole)] (- p) /				
SCREEN OR PERFORA	_					<u></u>			
Continuous Slot	X Mill Slot	=	•••		rilled Holes one (Open Hole)	Other (Specif	y)		
Louvered Shutter SCREEN-PERFORATED	Key Punched INTERVALS: I					ft. From	ft. to	ft,	
GRAVEL PACK I		From 2	ft. to 10 ft,	From	ft. to				
9 GROUT MATERIAL:			nent grout X Bent	onite X Ot	her Concrete: 0-1'				
Grout intervals: From			omft. to	ft, F	rom ft.	toft,			
Nearest source of possibl		n: ateral Lines	Pit Privy	Пт	vestock Pens	Insecticid	e Storage		
Sewer Lines		Cess Pool	Sewage Lagoor	=	uel Storage	==	ed Water Well		
Watertight Sewer Lir	=	eepage Pit	Feedyard	=	ertilizer Storage	Oil Well	Gas Well		
Other (Specity)						r.			
Direction from well? S		LITUOLOG	Distance from v	vell? ~420 FRON	1 TO	ft	ent) or BLUCCE	NC INTERMALS	
10 FROM TO 0.3	Topsoil. silty clay	LITHOLOG	ac LOG	rkun	10	LITHU, LUG (C	ont.) of PLUGGI	NG INTERVALS	
0.3 6	Silty clay								
6 9.5 9.5 10	Mudstone/shale Limestone								
				Notes: L	DHE ID: Mac's 66	Service III 646	12100		
					monitoring well is s			was installed at	
	D I (1270 C	INIC CON-	T. T.	the directi	on of KDHE.	<u> </u>			
11 CONTRACTOR'S (CATION: This water v /18 and this record i		of my knowledge a	reconstructed, or and belief. Kansa			
License No 757	This V	Water Well Reco	rd was completed on (m		5/18				
under the business name			di constructed well to Une		Signature Signature	105)	4	
			ch constructed well to: Kan 66612-1367. Mail one to				GWTS Section. 2785-296-5524.		
Visit us at http://www.kc			KSA 82a					7/10/2015	

Johnson 10

SW NW 29-12 251 SE ME 30 - 10 - 22.6

DENNIS L HANDKE

1820 NW 59th Terrace TOPEKA, KANSAS 66618 785-286-4047 Home 785-217-5864 Cell

Jessica Chapman Larsen & Associates 1311 E. 25th Street, Suite B Lawrence, Kansas, 66046

March 2, 2018

RE: Monitor Well Elevation Survey 8139 Metcalf Ave, Overland Park, Kansas Proj. 18-00E Mac's 66 Service U4-046-12100

Bnch Mark: Chiseled Square on North center of Southeast concrete pump island. West 5227

Elev: 1068		North 3404		st 5227	(from SE Cor. Sec. 29-12-25E)
MW-17	rim	1047.6 8	North	3809	NW1/4,NW1/4,SW1/4,NW1/4
	top pipe	1047.29	West	5105	Lat= 38.98173 Long = 94.66699
MW-18	rim	1046.41	North	3823	NE1/4,NW1/4,SW1/4,NW1/4
	top pipe	1046.20	West	4819	Lat= 38.98177 Long = 94.66700
MW-19	rim	1026.64	North	3947	NW1/4,NE1/4,SW1/4,NW1/4
	top pipe	1026.37	West	4305	Lat= 38.98212 Long = 94.66419
MW-20	rim	1041.97	North	3519	SE1/4,NE1/4,SW1/4,NW1/4
	top pipe	1041.71	West	4301	Lat= 38.98094 Long = 94.66417
MW-21	rim	1071.37	North	3505	SE1/4,NE1/4,SE1/4,NE1/4 (Sec. 30-12-25E)
	top pipe	1070.96	West	5546	Lat= 38.98089 Long = 94.66855


Old bench mark destroyed.

Elevation derived from existing project.

Lat & Long derived from Lenexa 7.5 Quad Map

y questions, please feel free to call me. Thank you for the opportunity to be

APR 0 6 2018 ATTENDED TO WATER

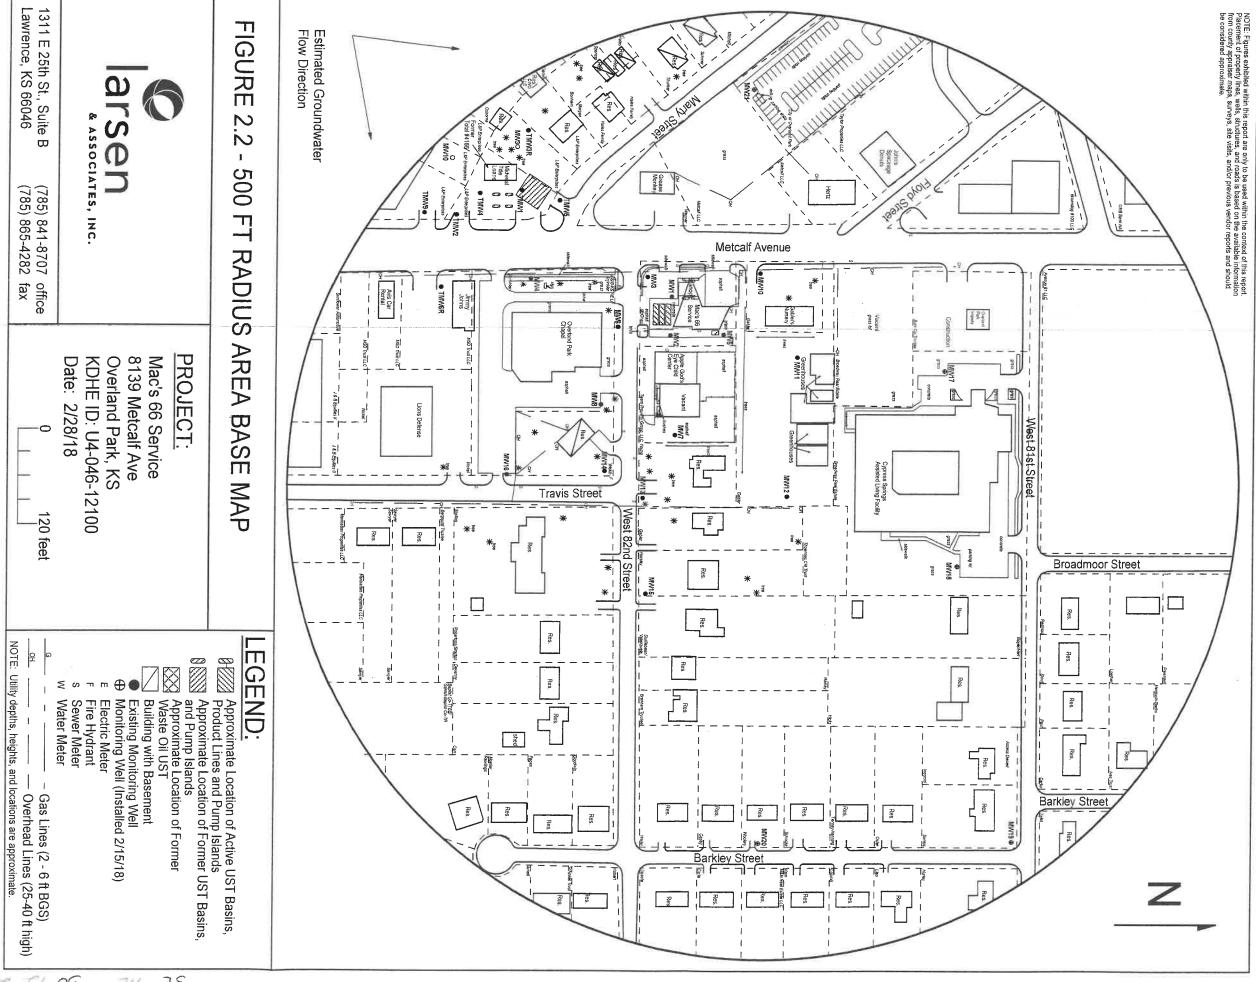

356-61-68 MN MS

BUREAU OF WATER

RECEIVED

Johnson