WATER WELL RECORD Form WWC-5	Divis	ion of Water]			
X Original Record Correction Change in Well Ust		rces App. No.		Well ID	MW22		
1 LOCATION OF WATER WELL: Fraction			er Township Nun				
County Johnson SE ¼ SW ¼ NW ¼ WELL OWNER: Last Name: First: Street of		30	T 12		5 X E W		
	or Kural Ad learest town	ldress where we or intersection	Il is located (if unk If at owner's ac	nown, distance	and direction		
Address: 200 S. Wilcox, No. 131 8087 Robin	inson St., O	verland Park, K	S 66204	idiess, elicek ile	.ic		
Address: City Castle Rock State: CO ZIP: 80104							
3 LOCATE WELL 4 DEPTH OF COMPLETED WELL: 16.5	ft 5	Latitude:	38.982	222 (de	cimal degrees)		
Depth(s) Groundwater Encountered: 1)	ft	Longitude	94.675	550 (de	cimal degrees)		
SECTION BOX: 2) ft 3) ft, or 4) Dry Well WELL'S STATIC WATER LEVEL: 5.55 ft.			Datum X WGS Latitude/Longitude		33 NAD 27		
X below land surface, measured on (mo-day-yr) 10,)/31/19		nit make/model:	:)		
NW X NE above land surface, measured on (mo-day-yr)		(W	AAS enabled?	Yes No)		
Pump test data: Well water was ft after hours pumping enm			urvey Topog	raphic Map			
W after hours pumping gpm Water well was ft		Online	Mapper				
sw se afterhours pumping gpm	6	Elevation	1061.10 ft	Ground Le	vel X TOC		
Estimated Yield: gpm		Source X	Land Survey	GPS	Topographic Map		
Bore Hole Diameter: 7.25 in to ft, and in to ft			Other				
7 WELL WATER TO BE USED AS:							
1 Domestic: 5 Public Water Supply: well ID	امر	Oil Eigld V	Vater Supply: leaso				
Household 6 Dewatering: how many wells?		Test Hole: well					
Lawn & Garden 7 Aquifer Recharge: well ID	[Cased [Uncased	Geotechnica	ıl		
Livestock 8 X Monitoring: well ID MW22 2 Irrigation 9 Environmental Remediation: well ID		Geothermal: Hov					
3 Feedlot Air Sparge Soil Vapor Extraction		a) Closed Loopb) Open Loop	·	Vertica ischarge			
4 Industrial Recovery Injection	[Other (spec		iseniinge	ing. or water		
Was a chemical/bacteriological sample submitted to KDHE? Yes X No	If ves. date	sample was sub	omitted:				
Water well disinfected? Yes X No			***************************************		•••••		
8 TYPE OF CASING USED: Steel X PVC Other CAS Casing diameter 2 in to 3 ft Diameter in to	SING JOIN	ITS: Glue	ed Clampled [Welded [X Threaded		
Casing height above land surface -0.26 in. Weight lbs/ft	II.	Diameterickness or gauge	ın. to	ft,			
TIPE OF SCREEN OR PERFORATION MATERIAL:				******			
Steel Stainless Steel Fiberglass X PVC	Oth	ner (Specify)					
Brass Galvanized Steel Concrete tile None used (open hole) SCREEN OR PERFORATION OPENINGS ARE:							
Continuous Stat. N. ACHOL.							
Louvered Shutter Key Punched Wire Wranned Saw Cut None (Open Hele)							
SCREEN-PERFORATED INTERVALS: From 3 ft. to 16.5 ft, From ft. to ft, From ft. to ft,							
The state of the s	11. I	tot	t, From	ft. to	ſt,		
9 GROUT MATERIAL: Neat cement Cement grout X Bentonite 2 Grout intervals: From 0.7 ft. to 2 ft, From ft. to ft	X Other (Concrete: 0-0.7'					
Nearest source of possible contamination:	n, From		o ft,				
Septic Tank Lateral Lines Pit Privy	Livesto	ck Pens	Insecticide	Storage			
Sewer Lines Cess Pool Sewage Lagoon	X Fuel Sto	orage		Water Well			
Watertight Sewer Lines Seepage Pit Feedyard Other (Specity)	Fertilize	er Storage	Oil Well / (Gas Well			
Direction from well? S Distance from well? ~400	n		ft				
10 EDOM TO	ROM	ТО	LITHO. LOG (con	t) or DLUCCING	2 INTERNALE		
0 1.5 Silty clay			ETTIO: EOG (COII	i.) oi FLOGGING	JINTERVALS		
1.5 2 Limestone fill 2 11 Silty clay							
11 14.5 Shale							
14.5 16.5 Limestone							
Not	os. Toxoco	8130 Santa E-	; U4-046-00490				
			; U4-046-00490 Illow groundwater,	<20' of grout w	as installed at		
the direction of KDHE.							
TONTRACTOR'S OR LANDOWNER'S CERTIFICATION: This water well was X constructed, reconstructed, or plugged under my jurisdiction and was completed on (mo-day-year) 10/2/19 and this record is true to the best of my knowledge and belief. Kansas Water 11/19 contractor's							
License No 757 This Water Well Record was completed on (mo-day-year) 11/19/19							
under the business name of Larsen & Associates, Inc. Mail 1 white copy along with a fee of \$5.00 for each constructed well to: Kansas Department	S	Signature		abla abl	-		
1000 SW Jackson St., Suite 420, Topeka, Kansas 66612-1367. Mail one to Water Well C	ent of Health Dwner and re	i and Environmen etain one for voir	i, Bureau of Water, Orecords, Telephone 7	385-296-5524	افي		
Visit us at http://www.kdheks.gov/waterwell/index.html KSA 82a-1212				Revised 7	7/10/2015		

DENNIS L HANDKE

1820 NW 59th Terrace TOPEKA, KANSAS 66618 785-286-4047 Home 785-217-5864 Cell

Jess Chapman Larsen & Associates 1311 E. 25th Street, Suite B Lawrence, Kansas, 66046 October 30, 2019

RE: Monitor Well Elevation Survey 8130 Santa Fe, Overland Park, Kansas

Proj. 19-00FF Texaco 8130 Santa Fe U4-046-00490

Bnch Mark: Square cut on SW corner of concrete electrical box base at Northwest corner of property.

Elev: 1074.95	North 3602.76	W	est 2301.57	(from SE Cor. Sec. 30-12-25E)
MW-22 rim	1061.36	North	3813.21	SE1/4,SW1/4,NW1/4,NE1/4
top p	ipe 1061.10	West	2372.12	Lat= 38.98222 Long = 94.67550
MW-23 rim	1076.44	North	3725.05	SE1/4,NW1/4,SW1/4,NE1/4
top p	ipe 1076.18	West	2155.68	Lat= 38.98148 Long = 94.67528
MW-24 rim	1080.53	North	3390.25	SE1/4,NW1/4,SW1/4,NE1/4
top p	ipe 1080.27	West	2236.80	Lat= 38.98056 Long = 94.67556

Elevation derived from existing project.


Lat & Long derived from Lenexa 7.5' Quad Maps WGS 84.

If you have any questions, please feel free to call me. Thank you for the opportunity to be

RECEIVED

DEC .0 2 2019

BUREAU OF WATER

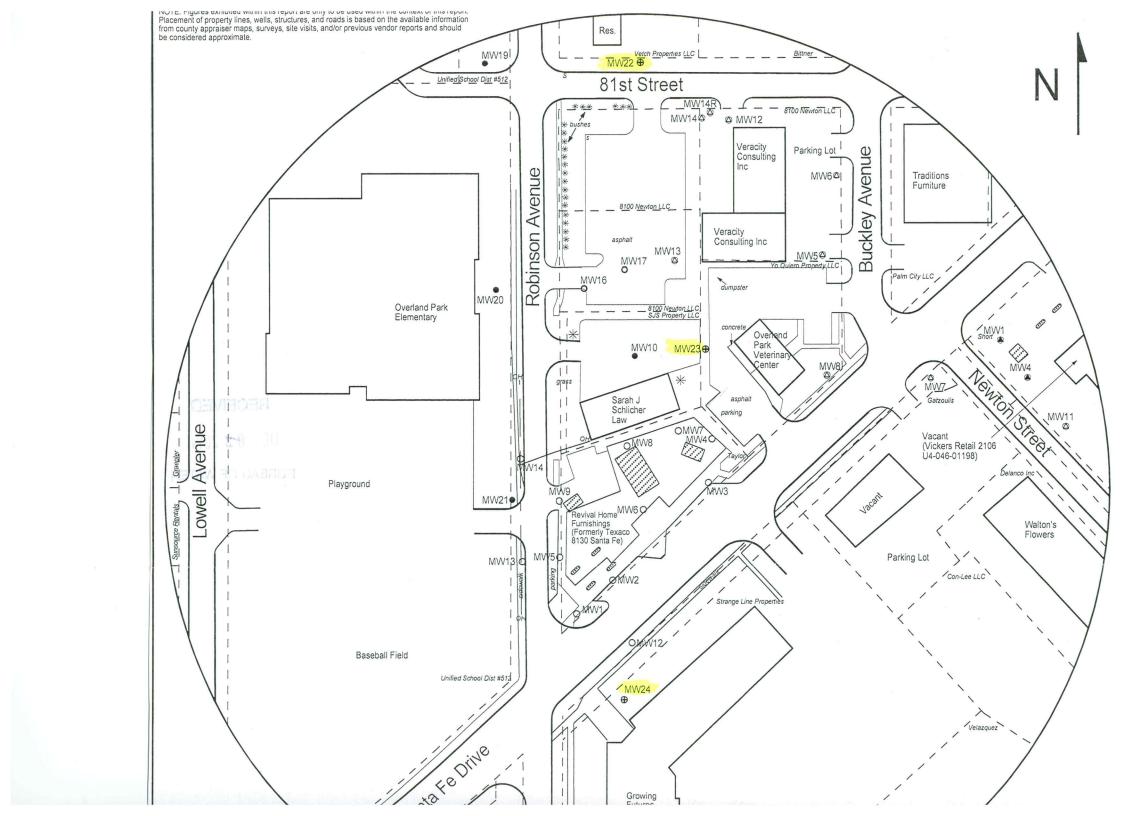

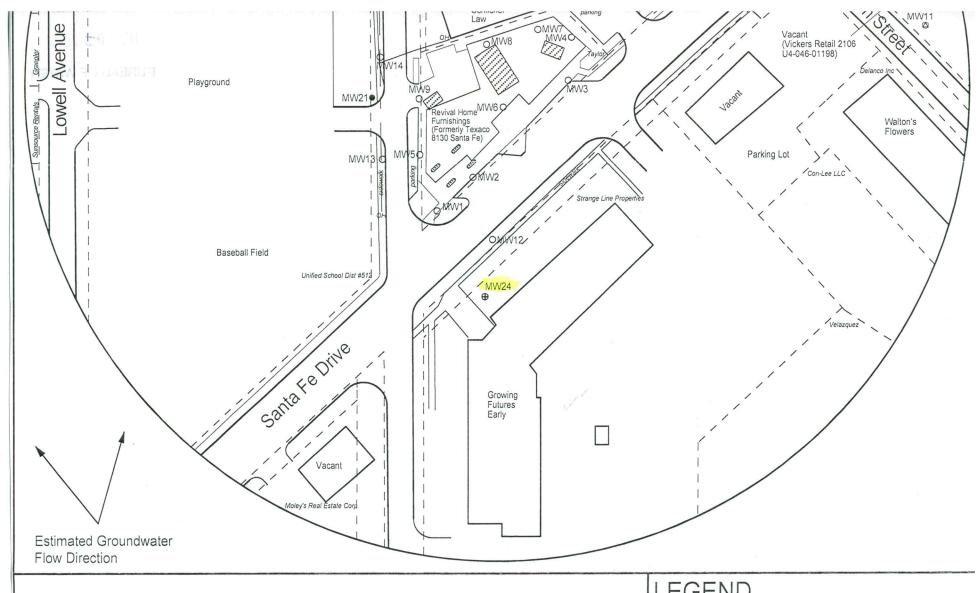


FIGURE 1 - 500 FT RADIUS AREA BASE MAP



1311 E 25th St., Suite B 785-841-8707 office

PROJECT:

Texaco 8130 Santa Fe 8130 Santa Fe Overland Park, KS KDHE ID: U4-046-00490 Date: 10/2/19

100 ft

LEGEND

Approximate Location of Former UST Basin, Pump Islands

Approximate Location of Property Line

Existing Monitoring Well

⊕ Monitoring Well Installed 10/2/19

O Plugged Well

Vickers Retail #2106 (U4-046-01198)

Plugged Well (Vickers Retail #2106)