

WATER WELL RECORD Form WWC-5

Division of Water Resources App. No.

MW-5

Original Record Correction Change in Well Use

Well ID

1 LOCATION OF WATER WELL: County: Johnson	Fraction ¼ NW ¼ NW ¼ NW ¼	Section Number 29	Township Number T 12S S	Range Number R 25 <input checked="" type="checkbox"/> E <input type="checkbox"/> W
---	------------------------------	----------------------	----------------------------	---

2 WELL OWNER: Last Name: _____ First: _____ Business: Former O'Neill Honda Dealership Address: 7979 Metcalf Avenue Address: _____ City: Overland Park State: KS ZIP: 66204	Street or Rural Address where well is located (if unknown, distance and direction from nearest town or intersection): If at owner's address, check here: <input checked="" type="checkbox"/>
---	--

3 LOCATE WELL WITH "X" IN SECTION BOX:

N

NW	NE
SW	SE

S

-----1 mile-----

4 DEPTH OF COMPLETED WELL: 19.5 ft.

Depth(s) Groundwater Encountered: 1) _____ ft.
2) _____ ft. 3) _____ ft., or 4) Dry Well

WELL'S STATIC WATER LEVEL: 10.41 ft.
 below land surface, measured on (mo-day-yr) 3/26/21
 above land surface, measured on (mo-day-yr) _____

Pump test data: Well water was _____ ft.
after _____ hours pumping _____ gpm
Well water was _____ ft.
after _____ hours pumping _____ gpm

Estimated Yield: _____ gpm
Bore Hole Diameter: 8.25 in. to 19.5 ft. and _____ in. to _____ ft.

5 Latitude: 38.98443 (decimal degrees)
Longitude: -94.66641 (decimal degrees)
Horizontal Datum: WGS 84 NAD 83 NAD 27
Source for Latitude/Longitude:
 GPS (unit make/model: _____) (WAAS enabled? Yes No)
 Land Survey Topographic Map
 Online Mapper: Google Earth

6 Elevation: 1064 ft. Ground Level TOC
Source: Land Survey GPS Topographic Map
 Other Google Earth

7 WELL WATER TO BE USED AS:

1. Domestic: <input type="checkbox"/> Household <input type="checkbox"/> Lawn & Garden <input type="checkbox"/> Livestock	5. <input type="checkbox"/> Public Water Supply: well ID _____ 6. <input type="checkbox"/> Dewatering: how many wells? _____ 7. <input type="checkbox"/> Aquifer Recharge: well ID _____ 8. <input checked="" type="checkbox"/> Monitoring: well ID MW-5	10. <input type="checkbox"/> Oil Field Water Supply: lease _____ 11. Test Hole: well ID _____ <input type="checkbox"/> Cased <input type="checkbox"/> Uncased <input type="checkbox"/> Geotechnical
2. <input type="checkbox"/> Irrigation 3. <input type="checkbox"/> Feedlot 4. <input type="checkbox"/> Industrial	9. Environmental Remediation: well ID _____ <input type="checkbox"/> Air Sparge <input type="checkbox"/> Soil Vapor Extraction <input type="checkbox"/> Recovery <input type="checkbox"/> Injection	12. Geothermal: how many bores? _____ a) Closed Loop <input type="checkbox"/> Horizontal <input type="checkbox"/> Vertical b) Open Loop <input type="checkbox"/> Surface Discharge <input type="checkbox"/> Inj. of Water
		13. <input type="checkbox"/> Other (specify): _____

Was a chemical/bacteriological sample submitted to KDHE? Yes No If yes, date sample was submitted: _____
Water well disinfected? Yes No

8 TYPE OF CASING USED: Steel PVC Other _____ CASING JOINTS: Glued Clamped Welded Threaded
Casing diameter 2 in. to 19.5 ft., Diameter _____ in. to _____ ft., Diameter _____ in. to _____ ft.
Casing height above land surface 0 in. Weight _____ lbs./ft. Wall thickness or gauge No. Sch. 40

TYPE OF SCREEN OR PERFORATION MATERIAL:
 Steel Stainless Steel Fiberglass PVC Other (Specify) _____
 Brass Galvanized Steel Concrete tile None used (open hole)

SCREEN OR PERFORATION OPENINGS ARE:
 Continuous Slot Mill Slot Gauze Wrapped Torch Cut Drilled Holes Other (Specify) _____
 Louvered Shutter Key Punched Wire Wrapped Saw Cut None (Open Hole)

SCREEN-PERFORATED INTERVALS: From 9.5 ft. to 19.5 ft., From _____ ft. to _____ ft., From _____ ft. to _____ ft.
GRAVEL PACK INTERVALS: From 7.5 ft. to 19.5 ft., From _____ ft. to _____ ft., From _____ ft. to _____ ft.


9 GROUT MATERIAL: Neat cement Cement grout Bentonite Other Concrete 0-2 feet
Grout Intervals: From 2 ft. to 7.5 ft., From _____ ft. to _____ ft., From _____ ft. to _____ ft.

Nearest source of possible contamination:
 Septic Tank Lateral Lines Pit Privy Livestock Pens Insecticide Storage
 Sewer Lines Cess Pool Sewage Lagoon Fuel Storage Abandoned Water Well
 Watertight Sewer Lines Seepage Pit Feedyard Fertilizer Storage Oil Well/Gas Well
 Other (Specify) _____

Direction from well? SE Distance from well? 73 ft.

10 FROM	TO	LITHOLOGIC LOG	FROM	TO	LITHO. LOG (cont.) or PLUGGING INTERVALS
1	9	Silty clay			
9	10	NR			
10	14.5	Silty clay			
14.5	15	Limestone gravel layer			
15	17	Silty clay			
17	19.5	Silty shale			
Notes:					

11 CONTRACTOR'S OR LANDOWNER'S CERTIFICATION: This water well was constructed, reconstructed, or plugged under my jurisdiction and was completed on (mo-day-year) 3/16/2021 and this record is true to the best of my knowledge and belief. Kansas Water Well Contractor's License No. 759 This Water Well Record was completed on (mo-day-year) 4/4/2021 under the business name of RAZEK Environmental, LLC Signature _____

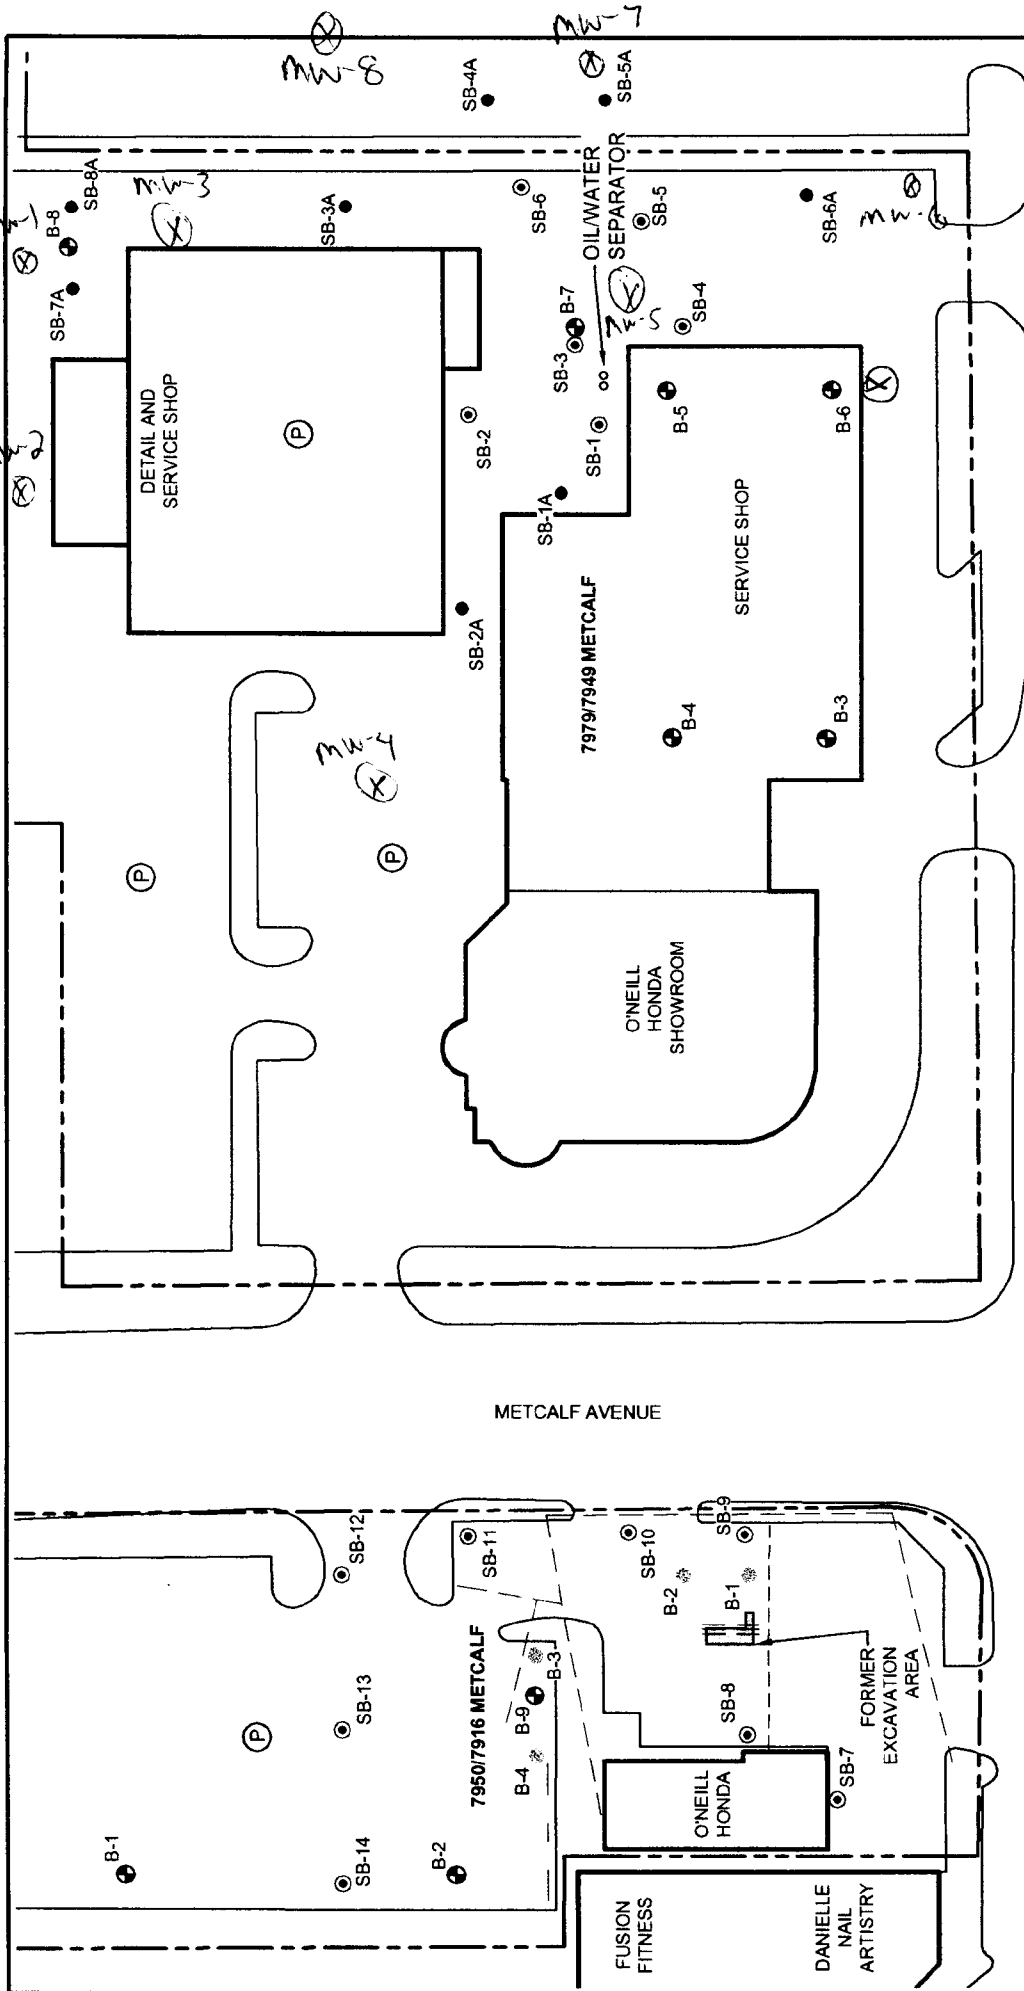

--- PRODUCT LINES
 --- ELECTRIC POWER LINES, CABLES CONDUIT AND LIGHTING CABLES
 --- SEWERS AND DRAIN LINES
 --- POTABLE WATER

W 80TH STREET

METCALF AVENUE

- LEGEND**
- APPROXIMATE SITE BOUNDARY
 - ⊕ PARKING AREA
 - ⊙ PREVIOUS BORING BY OTHERS (MARCH 2020)
 - ⊙ PREVIOUS BORING LOCATION (TERRACON LSI)
 - ⊙ BORING LOCATION
 - PROPOSED SAMPLE LOCATION

DIAGRAM IS INTENDED FOR GENERAL USE ONLY, AND IS NOT FOR CONSTRUCTION PURPOSES. LOCATIONS ARE APPROXIMATE.

EXHIBIT 2

SAMPLE LOCATION DIAGRAM
 MADMAR VCP
 7950 & 7979 METCALF AVENUE
 OVERLAND PARK, KANSAS

Terracon
 Consulting Engineers and Scientists
 15520 W. 113TH STREET
 PH. (913) 482-7777
 LEHEKA KS 66219
 FAX (913) 482-7443

Project Mgr	KRC	Project No	PO2207207
Approved By	KRC	Scale	1" = 60'
Checked By	KRC	Date	8/10/2020
Drawn By	DBM	File No	PO2207207E1.DWG