

WATER WELL RECORD Form WWC-5

Division of Water Resources App. No.

MW-6

Original Record Correction Change in Well Use

Well ID

1 LOCATION OF WATER WELL: County: Johnson Fraction 1/4 NW 1/4 NW 1/4 NW 1/4 Section Number 29 Township Number T 12S S Range Number R 25 E W

2 WELL OWNER: Last Name: First: Business: Former O'Neill Honda Dealership Address: 7979 Metcalf Avenue City: Overland Park State: KS ZIP: 66204 Street or Rural Address where well is located (if unknown, distance and direction from nearest town or intersection):

3 LOCATE WELL WITH "X" IN SECTION BOX: NW NE SW SE S

4 DEPTH OF COMPLETED WELL: 11.5 ft. Depth(s) Groundwater Encountered: 1) 7.63 ft. 2) ... 3) ... 4) Dry Well WELL'S STATIC WATER LEVEL: 7.63 ft. below land surface, measured on (mo-day-yr) 3/26/21

5 Latitude: 38.98416 Longitude: -94.66628 Horizontal Datum: WGS 84 Source for Latitude/Longitude: GPS Land Survey Topographic Map Online Mapper: Google Earth

7 WELL WATER TO BE USED AS: 1. Domestic: Household Lawn & Garden Livestock 2. Irrigation 3. Feedlot 4. Industrial 5. Public Water Supply: well ID 6. Dewatering: how many wells? 7. Aquifer Recharge: well ID 8. Monitoring: well ID MW-6 9. Environmental Remediation: well ID Air Sparge Soil Vapor Extraction Recovery Injection 10. Oil Field Water Supply: lease 11. Test Hole: well ID Cased Uncased Geotechnical 12. Geothermal: how many bores? a) Closed Loop Horizontal Vertical b) Open Loop Surface Discharge Inj. of Water 13. Other (specify):

Was a chemical/bacteriological sample submitted to KDHE? Water well disinfected? Yes No If yes, date sample was submitted:


8 TYPE OF CASING USED: Steel PVC Other CASING JOINTS: Glued Clamped Welded Threaded Casing diameter 2 in. to 11.5 ft., Diameter in. to ft., Diameter in. to ft. Casing height above land surface 0 in. Weight lbs./ft. Wall thickness or gauge No. Sch. 40 TYPE OF SCREEN OR PERFORATION MATERIAL: Steel Stainless Steel Fiberglass PVC Other (Specify) Brass Galvanized Steel Concrete tile None used (open hole) SCREEN OR PERFORATION OPENINGS ARE: Continuous Slot Mill Slot Gauze Wrapped Torch Cut Drilled Holes Other (Specify) Louvered Shutter Key Punched Wire Wrapped Saw Cut None (Open Hole) SCREEN-PERFORATED INTERVALS: From 4 ft. to 11.5 ft., From ft. to ft., From ft. to ft. GRAVEL PACK INTERVALS: From 3 ft. to 11.5 ft., From ft. to ft., From ft. to ft.

9 GROUT MATERIAL: Neat cement Cement grout Bentonite Other Concrete 0-2 feet Grout Intervals: From 2 ft. to 3 ft., From ft. to ft., From ft. to ft. Nearest source of possible contamination: Septic Tank Lateral Lines Pit Privy Livestock Pens Insecticide Storage Sewer Lines Cess Pool Sewage Lagoon Fuel Storage Abandoned Water Well Watertight Sewer Lines Seepage Pit Feedyard Fertilizer Storage Oil Well/Gas Well Other (Specify) Direction from well? NW Distance from well? 132 ft.

10 FROM TO LITHOLOGIC LOG FROM TO LITHO. LOG (cont.) or PLUGGING INTERVALS

1	11	Silty clay			
11	11.5	Limestone gravel layer			
11.5	12	Silty shale			

11 CONTRACTOR'S OR LANDOWNER'S CERTIFICATION: This water well was constructed, reconstructed, or plugged under my jurisdiction and was completed on (mo-day-year) 3/16/2021 and this record is true to the best of my knowledge and belief. Kansas Water Well Contractor's License No. 759 This Water Well Record was completed on (mo-day-year) 4/4/2021 under the business name of RAZEK Environmental, LLC Signature

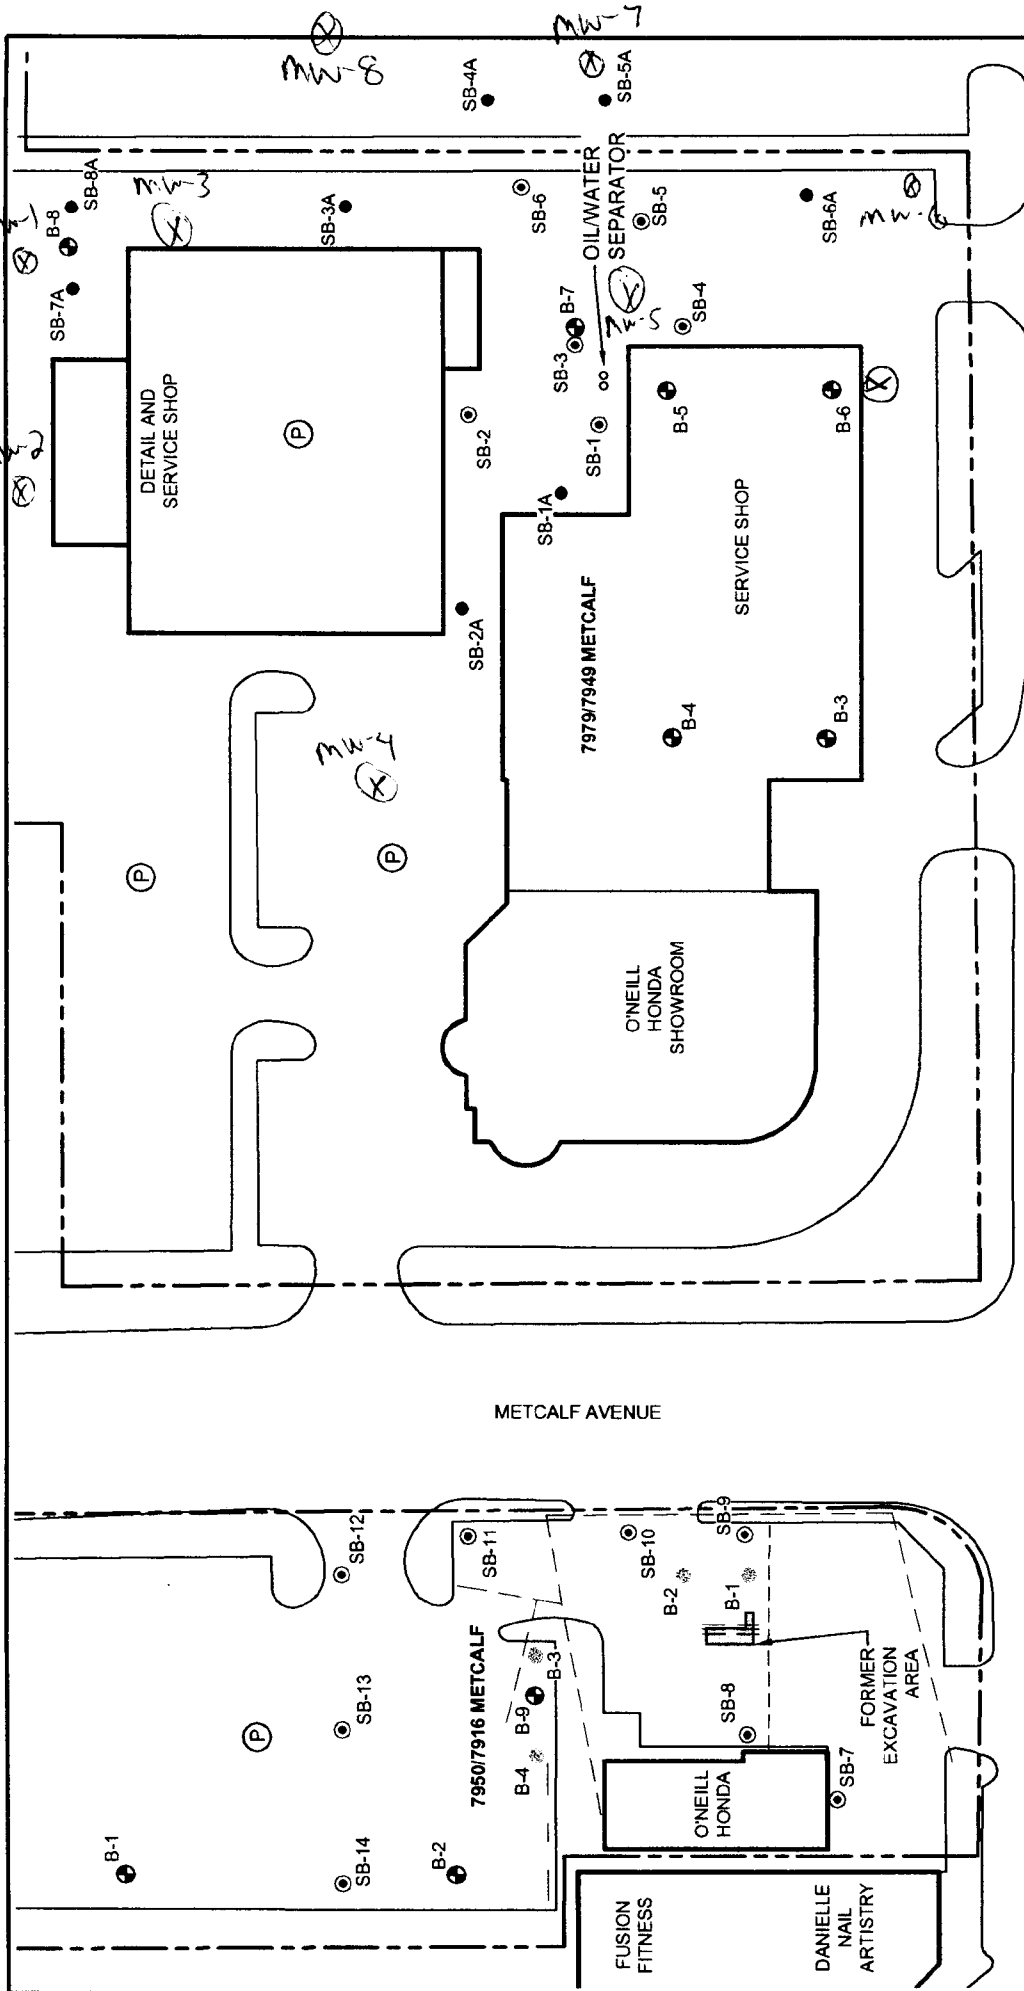

- PRODUCT LINES
- ELECTRIC POWER LINES, CABLES CONDUIT AND LIGHTING CABLES
- SEWERS AND DRAIN LINES
- POTABLE WATER

W 80TH STREET

METCALF AVENUE

- LEGEND**
- APPROXIMATE SITE BOUNDARY
  - Ⓟ PARKING AREA
  - ⊕ PREVIOUS BORING BY OTHERS (MARCH 2020)
  - ⊕ PREVIOUS BORING LOCATION (TERRACON LSI)
  - ⊙ BORING LOCATION
  - PROPOSED SAMPLE LOCATION

DIAGRAM IS INTENDED FOR GENERAL USE ONLY, AND IS NOT FOR CONSTRUCTION PURPOSES. LOCATIONS ARE APPROXIMATE.

EXHIBIT 2

**SAMPLE LOCATION DIAGRAM**  
 MADMAR VCP  
 7950 & 7979 METCALF AVENUE  
 OVERLAND PARK, KANSAS

**Terracon**  
 Consulting Engineers and Scientists  
 15520 W. 113TH STREET  
 PH. (913) 482-7777  
 LEHEKA KS 66219  
 FAX (913) 482-7443

Project Mgr	KRC	Project No	PO2207207
Approved By	KRC	Scale	1" = 60'
Checked By	KRC	Date	8/10/2020
Drawn By	DBM	File No	PO2207207E1.DWG