

WATER WELL RECORD Form WWC-5

Division of Water Resources App. No.

MW-7

Original Record Correction Change in Well Use

Well ID

1 LOCATION OF WATER WELL: County: Johnson	Fraction ¼ NW ¼ NW ¼ NW ¼	Section Number 29	Township Number T 12S S	Range Number R 25 <input checked="" type="checkbox"/> E <input type="checkbox"/> W
--	------------------------------	-----------------------------	-----------------------------------	--

2 WELL OWNER: Last Name: _____ First: _____ Business: Former O'Neill Honda Dealership Address: 7979 Metcalf Avenue Address: _____ City: Overland Park State: KS ZIP: 66204	Street or Rural Address where well is located (if unknown, distance and direction from nearest town or intersection): If at owner's address, check here: <input checked="" type="checkbox"/>
--	--

3 LOCATE WELL WITH "X" IN SECTION BOX:

N

NW	NE
SW	SE

S

-----1 mile-----

4 DEPTH OF COMPLETED WELL: **12** ft.

Depth(s) Groundwater Encountered: 1) ft.
 2) ft. 3) ft., or 4) Dry Well

WELL'S STATIC WATER LEVEL: **3.54** ft.
 below land surface, measured on (mo-day-yr) **3/26/21**
 above land surface, measured on (mo-day-yr)

Pump test data: Well water was ft.
 after hours pumping gpm
 Well water was ft.
 after hours pumping gpm

Estimated Yield: gpm

Bore Hole Diameter: **8.25** in. to **12** ft. and
 in. to ft.

5 Latitude: **38.98440** (decimal degrees)
Longitude: **-94.66619** (decimal degrees)
 Horizontal Datum: WGS 84 NAD 83 NAD 27
 Source for Latitude/Longitude:
 GPS (unit make/model:)
 (WAAS enabled? Yes No)
 Land Survey Topographic Map
 Online Mapper: **Google Earth**

6 Elevation: **1034** ft. Ground Level TOC
 Source: Land Survey GPS Topographic Map
 Other **Google Earth**

7 WELL WATER TO BE USED AS:

1. Domestic: <input type="checkbox"/> Household <input type="checkbox"/> Lawn & Garden <input type="checkbox"/> Livestock 2. <input type="checkbox"/> Irrigation 3. <input type="checkbox"/> Feedlot 4. <input type="checkbox"/> Industrial	5. <input type="checkbox"/> Public Water Supply: well ID	10. <input type="checkbox"/> Oil Field Water Supply: lease
6. <input type="checkbox"/> Dewatering: how many wells?	7. <input type="checkbox"/> Aquifer Recharge: well ID	11. Test Hole: well ID
8. <input checked="" type="checkbox"/> Monitoring: well ID MW-7	9. Environmental Remediation: well ID	12. Geothermal: how many bores?
<input type="checkbox"/> Air Sparge <input type="checkbox"/> Soil Vapor Extraction <input type="checkbox"/> Recovery <input type="checkbox"/> Injection	13. <input type="checkbox"/> Other (specify):	a) Closed Loop <input type="checkbox"/> Horizontal <input type="checkbox"/> Vertical b) Open Loop <input type="checkbox"/> Surface Discharge <input type="checkbox"/> Inj. of Water

Was a chemical/bacteriological sample submitted to KDHE? Yes No If yes, date sample was submitted:

Water well disinfected? Yes No

8 TYPE OF CASING USED: Steel PVC Other CASING JOINTS: Glued Clamped Welded Threaded

Casing diameter **2** in. to **12** ft., Diameter in. to ft., Diameter in. to ft.
 Casing height above land surface **0** in. Weight lbs./ft. Wall thickness or gauge No. **Sch. 40**

TYPE OF SCREEN OR PERFORATION MATERIAL:
 Steel Stainless Steel Fiberglass PVC Other (Specify)

Brass Galvanized Steel Concrete tile None used (open hole)

SCREEN OR PERFORATION OPENINGS ARE:
 Continuous Slot Mill Slot Gauze Wrapped Torch Cut Drilled Holes Other (Specify)

Louvered Shutter Key Punched Wire Wrapped Saw Cut None (Open Hole)

SCREEN-PERFORATED INTERVALS: From **4** ft. to **12** ft., From ft. to ft., From ft. to ft.
 GRAVEL PACK INTERVALS: From **3** ft. to **12** ft., From ft. to ft., From ft. to ft.

9 GROUT MATERIAL: Neat cement Cement grout Bentonite Other **Concrete 0-2 feet**


Grout Intervals: From **2** ft. to **3** ft., From ft. to ft., From ft. to ft.

Nearest source of possible contamination:
 Septic Tank Lateral Lines Pit Privy Livestock Pens Insecticide Storage
 Sewer Lines Cess Pool Sewage Lagoon Fuel Storage Abandoned Water Well
 Watertight Sewer Lines Seepage Pit Feedyard Fertilizer Storage Oil Well/Gas Well
 Other (Specify)

Direction from well? **NW** Distance from well? **94** ft.

10 FROM	TO	LITHOLOGIC LOG	FROM	TO	LITHO. LOG (cont.) or PLUGGING INTERVALS
1	7	Silty clay			
7	7.5	Limestone gravel layer			
7.5	12.5	Silty shale			

11 CONTRACTOR'S OR LANDOWNER'S CERTIFICATION: This water well was constructed, reconstructed, or plugged under my jurisdiction and was completed on (mo-day-year) **3/16/2021** and this record is true to the best of my knowledge and belief. Kansas Water Well Contractor's License No. **759** This Water Well Record was completed on (mo-day-year) **4/4/2021** under the business name of **RAZEK Environmental, LLC** Signature *[Signature]*

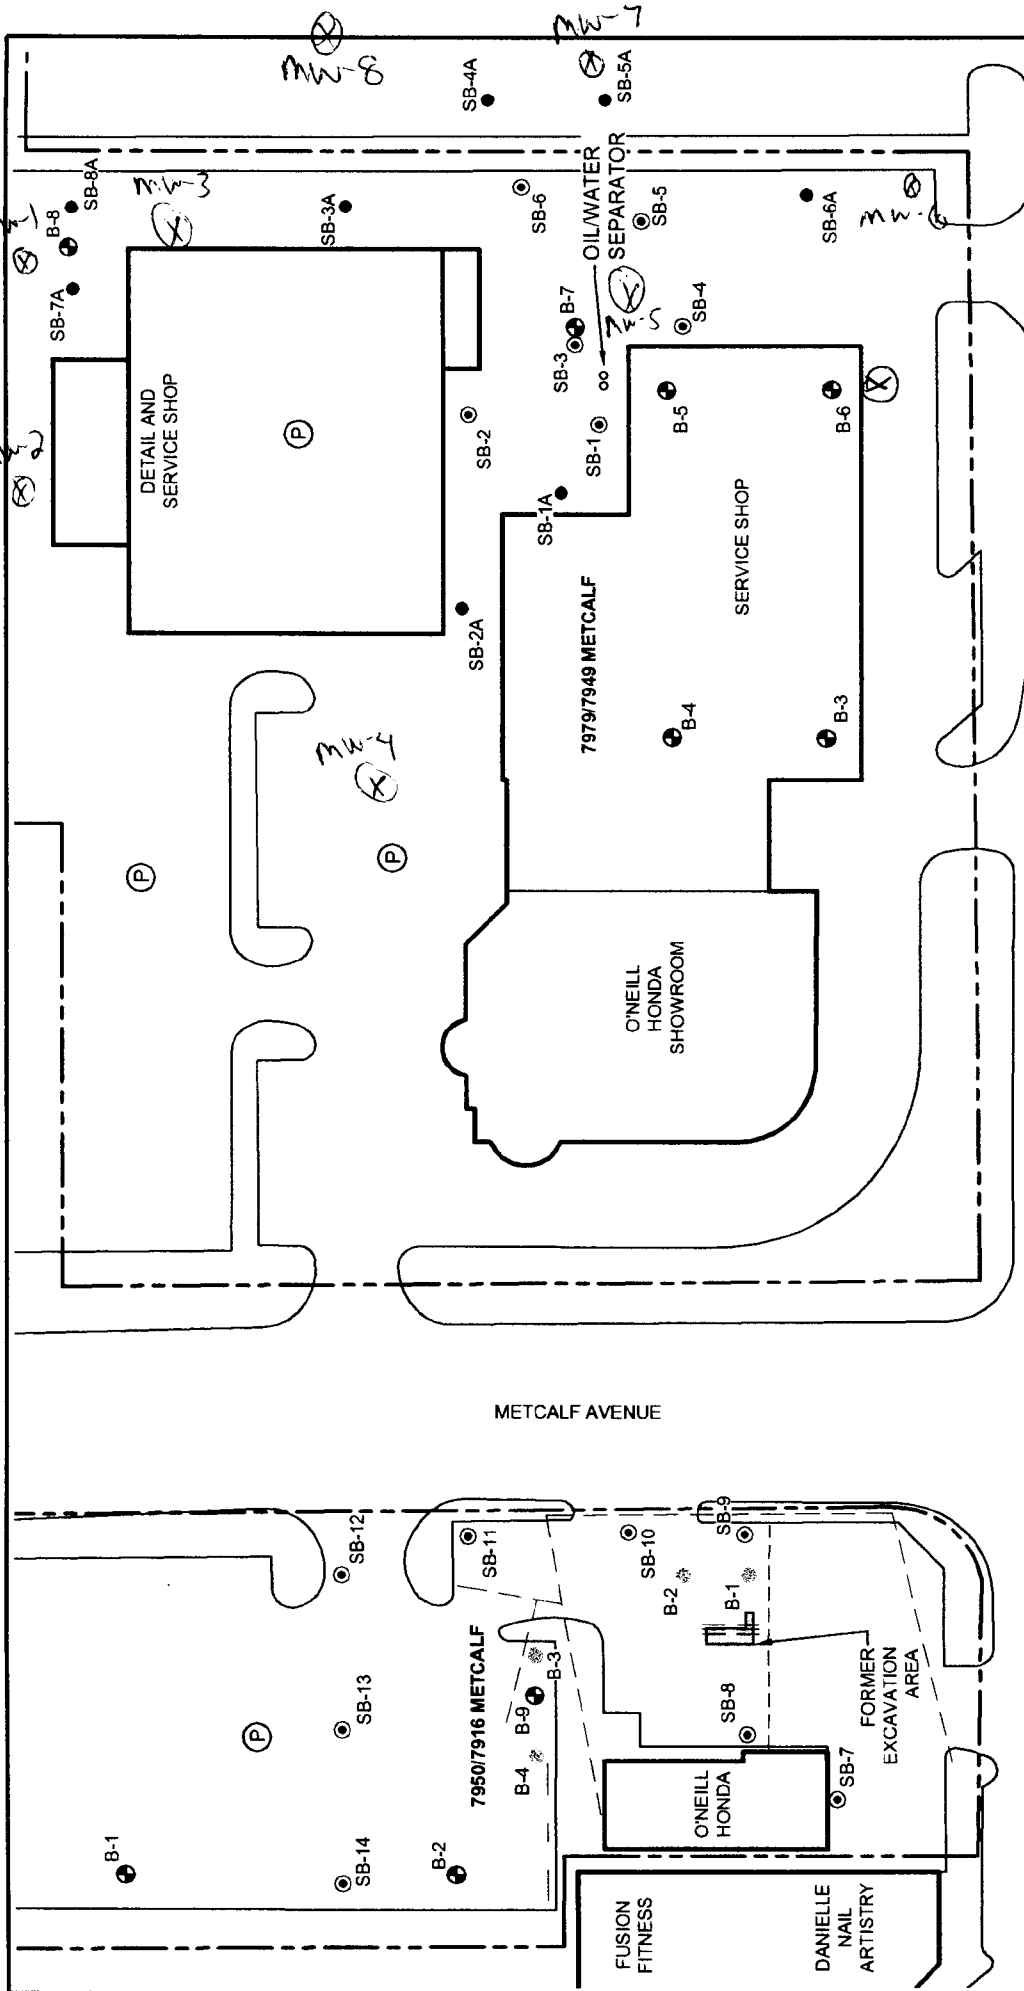

--- PRODUCT LINES
 --- ELECTRIC POWER LINES, CABLES CONDUIT AND LIGHTING CABLES
 --- SEWERS AND DRAIN LINES
 --- POTABLE WATER

W 80TH STREET

METCALF AVENUE

- LEGEND**
- APPROXIMATE SITE BOUNDARY
 - Ⓟ PARKING AREA
 - ⊙ PREVIOUS BORING BY OTHERS (MARCH 2020)
 - ⊙ PREVIOUS BORING LOCATION (TERRACON LSI)
 - ⊙ BORING LOCATION
 - PROPOSED SAMPLE LOCATION

DIAGRAM IS INTENDED FOR GENERAL USE ONLY, AND IS NOT FOR CONSTRUCTION PURPOSES. LOCATIONS ARE APPROXIMATE.

EXHIBIT 2

SAMPLE LOCATION DIAGRAM
 MADMAR VCP
 7950 & 7979 METCALF AVENUE
 OVERLAND PARK, KANSAS

Terracon
 Consulting Engineers and Scientists
 15520 W. 113TH STREET
 PH. (913) 482-7777
 LEHEKA KS 66219
 FAX (913) 482-7443

Project No.	P02207207
Scale	1" = 60'
Date	8/10/2020
File No.	P02207207E1.DWG
Project Mgr.	KRC
Approved By	KRC
Checked By	KRC
Drawn By	DBM