
WATER WELL RECORD Form WWC-5						Division of Water						
X Origin	al Record	Correcti	on Change	in Well Ust		Re	sources App. No.		Well ID	MW17		
1 LOCA County	ATION OF V	VATER W	ELL:	Fraction SW 1/4 S	SW ¼ SW	¼ SW		Township Nut	nber Range S R 2	Number 25 X E W		
2 WELI	L OWNER: 1	Last Name:		First:				ell is located (if unl				
	ss: KDHE				fro	om nearest to	own or intersection	): If at owner's a				
Addres Addres	s: 1000 SW.	Jackson Blvd			9475	Metcalf Ave	, Overland Park, K	.S				
City		peka	State: KS	ZIP: 66612								
	TE WELL	4	DEPTH OF CO	MPLETED W	'ELL: 30	ft	5 Latitude:	38.95	740 (de	cimal degrees)		
1	"X" IN	Dep	oth(s) Groundwater	Encountered:	1) <u></u>	П	Longitude	e 94.96	718 (de	cimal degrees)		
SECT	ION BOX:	11/17	2) ft :	3) ft, or	4) Dry W	/ell Horizontal Datum X   WGS 84   NAD 83   NAD 27						
	N I		LL'S STATIC WA below land sur		11.19	ft.		Latitude/Longitude unit make/model:				
1	j.			face, measured o			'	AAS enabled?	Yes No	)		
NW .	NE NE	-   F	ump test data: We	il water was	ftft	***************************************		Survey Topos		,		
w L		F	afterh			m		e Mapper				
1 1	Water well was									- 11-11-11		
sw	sw se after hours pumping						6 Elevation	***************************************				
x	Estimated Yield:gpm  Bore Hole Diameter:7.25 in to						Source X Land Survey GPS Topographic Man					
	S		sore Flore Diameter	in	to fi	and	L.	] Other				
	I mile			***************************************	***************************************							
	WATER TO			1 1115			10 0 1 5 1 1					
1 Domestic:	hold	5 <u> </u>	Public Water St Dewatering: ho				11 Test Hole: we	Water Supply: leas	е			
	& Garden		Aquifer Rechar			Cased Uncased Geotechnical						
Livesto		_	Monitoring: we	_		12 Geothermal: How many bores?						
2 Irrigati	ion	_	Environmental Rem		)		a) Closed Lo	op 📋 Horizonta	l Vertic	al		
3 Feedlo	ot		Air Sparge	Soil Vapo	or Extractior	b) Open Loop Surface Discharge Inj. of Water						
4 Indust	rial	L	Recovery	Injection			Other (sp	ecify):				
Was a chemical/bacteriological sample submitted to KDHE? Yes X No If yes, date sample was submitted:  Water well disinfected? Yes X No												
		•		Code and		CACINIC	ODUTE. DOL	1 0 11	<b></b>			
Casing diame	eter 2	in. to 1	Steel X PVC	Other	in to	"CASING 1 "B	Diameter	ued Clampled	Welded	X Threaded		
Casing height	t above land su	rface -0	.25 in. V	Veight	Ibs	s./ft. We	ell thickness or gau	in. to				
l —			TION MATERIA	.L:								
Steel		ess Steel	Fiberglass	X PVC			Other (Specify)					
Brass		nized Steel		e None	used (open hole	e)						
		X Mill Slo		ze Wrapped	Torch Cu	. E	illed Holes	Other (Specia	۸			
			nched Wire					Other (Specify	()			
SCREEN-PE	RFORATED	INTERVAL	S: From 15	ft. to 30	ft, From		ft. to	ft, From	ft. to	ft,		
GRAV	EL PACK II	NTERVALS	S: From 13	ft. to 30	ft, Fron	l	ft. to	ft, From	ft. to	ft,		
9 GROUT	MATERIAL:	Neat	cement C	Cement grout	X Bentonite	X Oil	ner Concrete: 0-0.	5'				
Grout interva	*******	0.5 ft. to	o 13 ft,	From	_ ft. to	ft, F	romft.	toft,				
Nearest sour		e contamin	_	□ n: n	•				_			
Septic Sewer		<u> </u>	Lateral Lines Cess Pool	Pit Pr	-		vestock Pens el Storage	Insecticid	•			
	Lines tight Sewer Lin	LOS . [	Seepage Pit	Feedy	ge Lagoon		ci Storage rtilizer Storage	Oil Well /	d Water Well			
	(Casaita)						runzer Storage	On wen/	Cas well			
Direction from				Distan	ice from well?	~275	***************************************	ft				
10 FROM	ТО		LITHOLO	GIC LOG		FROM		LITHO. LOG (co	ont.) or PLUGGIN	G INTERVALS		
0	0.5		gravel and sand									
0.5	7	Clay, sand, and gravel										
7	7.5	Sand, gravel, silt, and clay Asphalt and gravel										
7.5	15	Silty clay										
15	21	Clay Clay, some silt and very fine sand N					Notes: KDHE ID: Jiffy Lube; U4-046-12211					
21	30			nd					r <20' of arout	was installed at		
23 30 Silt and clay, shale/siltstone Target of monitoring well is shallow groundwater, <20' of grout was installed at the direction of KDHE.												
11 CONTRACTOR'S OR LANDOWNER'S CERTIFICATION: This water well was X constructed, plugged under my												
jurisdiction and was completed on (mo-day-year) 9/16/21 and this record is true to the best of my knowledge and belief. Kansas Water Well Contractor's												
License No. 757 This Water Well Record was completed on (mo-day-year) 11/10/21 under the business name of Larsen & Associates, Inc. Signature												
andoi int t	Mail I white	copy along w	ith a fee of \$5.00 for	each constructed v	vell to: Kansas D	epartment of	Health and Environm	nent, Bureau of Water	GWTS Section			
								ur records. Telephone				
Visit us	at http://www.kd	lheks.gov/wate	rwell/index.html		KSA 82a-1212	2			Revised	17/10/2015		

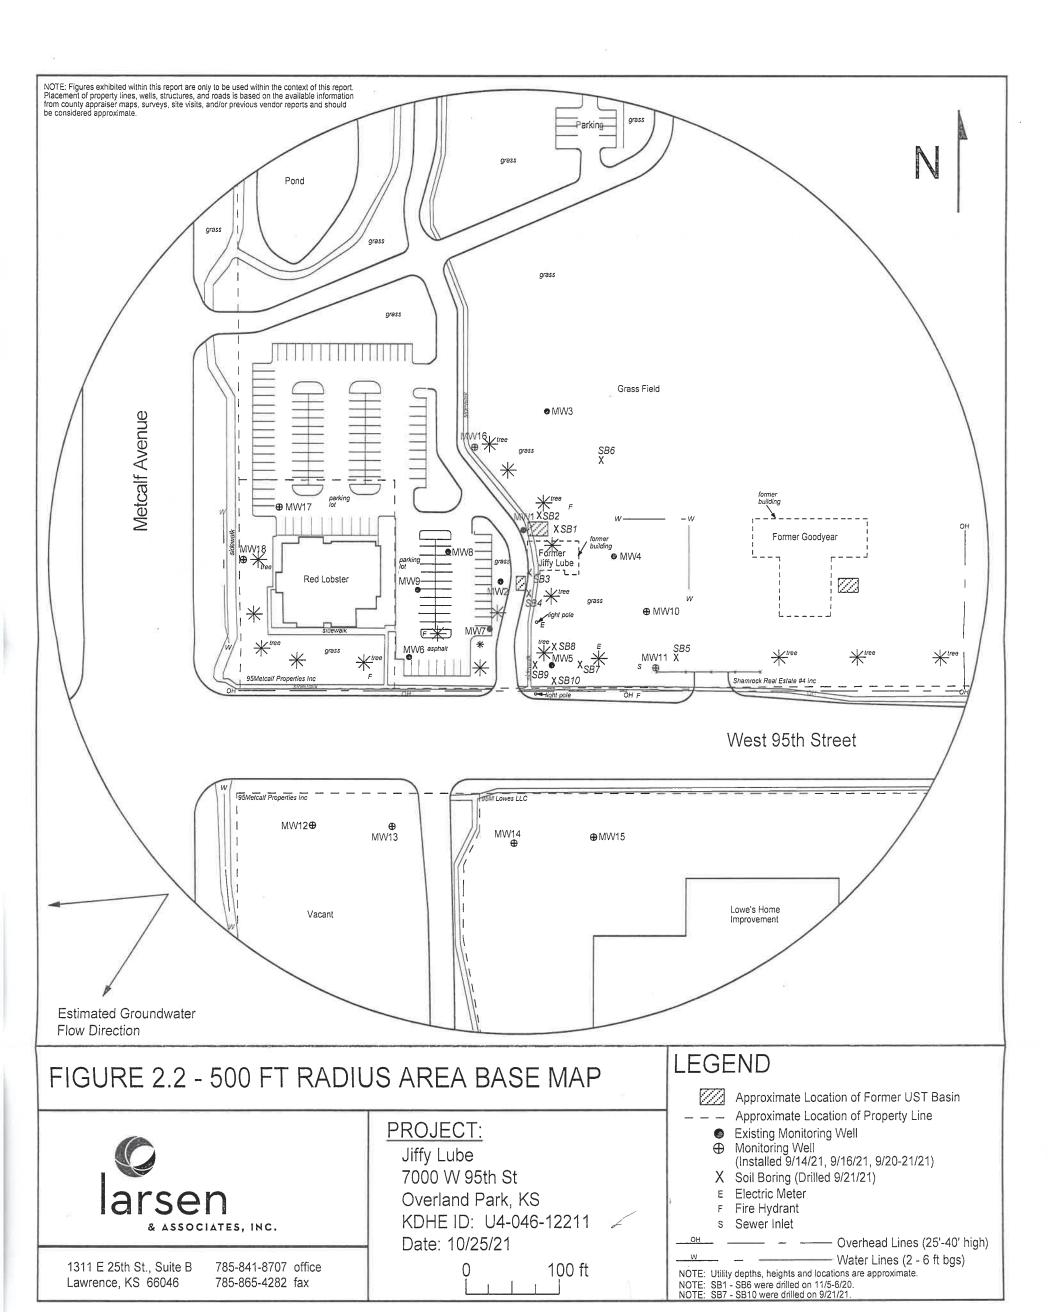

## **DENNIS L HANDKE**

## 1820 NW 59th Terrace TOPEKA, KANSAS 66618 785-286-4047 Home

Jess Chapman Larsen & Associates 1311 E. 25<sup>th</sup> Street, Suite B Lawrence, Kansas, 66046 November 1, 2021

RE: Monitor Well Elevation Survey 7000 W. 95<sup>th</sup> St., Overland Park, Kansas

Proj. 21-00II Jiffy Lube U4-046-12211

Bench Mark: Square Elev: 964.21		cut on N North	orth center of 81.06	of concrete street West 4879.16	light base near Southwest corner of property. (from SE Cor. Sec. 32-12-25E)
MW-10	rim top pipe	969.62 969.25	North West		SE1/4,SW1/4,SW1/4,SW1/4 Lat= 38.95710 Long = 94.66580
MW-11	rim top pipe	968.26 967.90	North West		SE1/4,SW1/4,SW1/4,SW1/4 Lat= 38.95692 Long = 94.66578
MW-12	rim top pipe	951.48 951.13	South West		NW1/4,NW1/4,NW1/4,NW1/4 (Sec. 5-13-25E) Lat= 38.95647 Long = 94.66705
MW-13	rim top pipe	954.07 953.76	South West		NW1/4,NW1/4,NW1/4,NW1/4 (Sec. 5-13-25E) Lat= 38.95647 Long = 94.66676
MW-14	rim	946.05	South	133.17	NE1/4,NW1/4,NW1/4,NW1/4 (Sec. 5-13-25E)
	top pipe	945.62	West	4911.93	Lat= 38.95642 Long = 94.6631
MW-15	rim	944.91	South	127.44	NE1/4,NW1/4,NW1/4,NW1/4 (Sec. 5-13-25E)
	top pipe	944.52	West	4824.81	Lat= 38.95643 Long = 94.96600
MW-16	rim	967.71	North	290.13	SE1/4,SW1/4,SW1/4,SW1/4
	top pipe	967.39	West	4953.52	Lat= 38.95758 Long = 94.96645
MW-17	rim	957.75	North	224.81	SW1/4,SW1/4,SW1/4,SW1/4
	top pipe	957.50	West	5160.10	Lat= 38.95740 Long = 94.96718
MW-18	rim	949.08	North	169.16	SW1/4,SW1/4,SW1/4,SW1/4
	top pipe	948.77	West	5197.25	Lat= 38.95725 Long = 94.66731

Lat & Long derived from Lenexa 7.5 quad map. WGS84.

Elevation established from existing project. NAVD 88

If you have any questions, please feel free to call me. Thank you for the opportunity to be

Dennish Handke RLS