

WATER WELL RECORD Form WWC-5


Division of Water Resources App. No.

Well ID MW-10

Original Record Correction Change in Well Use

1 LOCATION OF WATER WELL: County: Johnson	Fraction ¼ NW ¼ NW ¼ NW ¼	Section Number 29	Township Number T 12S S	Range Number R 25 <input checked="" type="checkbox"/> E <input type="checkbox"/> W
---	------------------------------	----------------------	----------------------------	---

2 WELL OWNER: Last Name: <u>Former O'Neill Honda Dealership</u> Address: <u>7979 Metcalf Avenue</u> City: <u>Overland Park</u> State: <u>KS</u> ZIP: <u>66204</u>	Street or Rural Address where well is located (if unknown, distance and direction from nearest town or intersection): If at owner's address, check here: <input checked="" type="checkbox"/>
--	--

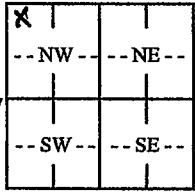3 LOCATE WELL WITH "X" IN SECTION BOX: N W E S  1 mile	4 DEPTH OF COMPLETED WELL:16.5..... ft. Depth(s) Groundwater Encountered: 1) ft. 2) ft. 3) ft., or 4) <input type="checkbox"/> Dry Well WELL'S STATIC WATER LEVEL: ft. <input checked="" type="checkbox"/> below land surface, measured on (mo-day-yr)..... <input type="checkbox"/> above land surface, measured on (mo-day-yr)..... Pump test data: Well water was ft. after..... hours pumping gpm Well water was ft. after..... hours pumping gpm Estimated Yield: gpm Bore Hole Diameter: 8.25 in. to 16.5 ft. and in. to ft.	5 Latitude: 38.98456(decimal degrees) Longitude: -94.66587(decimal degrees) Horizontal Datum: <input checked="" type="checkbox"/> WGS 84 <input type="checkbox"/> NAD 83 <input type="checkbox"/> NAD 27 Source for Latitude/Longitude: <input type="checkbox"/> GPS (unit make/model:) (WAAS enabled? <input type="checkbox"/> Yes <input type="checkbox"/> No) <input type="checkbox"/> Land Survey <input type="checkbox"/> Topographic Map <input checked="" type="checkbox"/> Online Mapper: <u>Google Earth</u>
		6 Elevation: 1031ft. <input checked="" type="checkbox"/> Ground Level <input type="checkbox"/> TOC Source: <input type="checkbox"/> Land Survey <input type="checkbox"/> GPS <input type="checkbox"/> Topographic Map <input checked="" type="checkbox"/> Other <u>Google Earth</u>

7 WELL WATER TO BE USED AS:

1. Domestic: <input type="checkbox"/> Household <input type="checkbox"/> Lawn & Garden <input type="checkbox"/> Livestock	5. <input type="checkbox"/> Public Water Supply: well ID 6. <input type="checkbox"/> Dewatering: how many wells? 7. <input type="checkbox"/> Aquifer Recharge: well ID 8. <input checked="" type="checkbox"/> Monitoring: well ID <u>MW-10</u> 9. Environmental Remediation: well ID <input type="checkbox"/> Air Sparge <input type="checkbox"/> Soil Vapor Extraction <input type="checkbox"/> Recovery <input type="checkbox"/> Injection	10. <input type="checkbox"/> Oil Field Water Supply: lease 11. Test Hole: well ID <input type="checkbox"/> Cased <input type="checkbox"/> Uncased <input type="checkbox"/> Geotechnical 12. Geothermal: how many bores? a) Closed Loop <input type="checkbox"/> Horizontal <input type="checkbox"/> Vertical b) Open Loop <input type="checkbox"/> Surface Discharge <input type="checkbox"/> Inj. of Water 13. <input type="checkbox"/> Other (specify):
--	--	---

Was a chemical/bacteriological sample submitted to KDHE? Yes No If yes, date sample was submitted:

Water well disinfected? Yes No

8 TYPE OF CASING USED: Steel PVC Other CASING JOINTS: Glued Clamped Welded Threaded
Casing diameter 2 in. to 16.5 ft., Diameter in. to ft., Diameter in. to ft.
Casing height above land surface 0 in. Weight lbs./ft. Wall thickness or gauge No. Sch. 40.....

TYPE OF SCREEN OR PERFORATION MATERIAL:
 Steel Stainless Steel Fiberglass PVC Other (Specify)
 Brass Galvanized Steel Concrete tile None used (open hole)

SCREEN OR PERFORATION OPENINGS ARE:
 Continuous Slot Mill Slot Gauze Wrapped Torch Cut Drilled Holes Other (Specify)
 Louvered Shutter Key Punched Wire Wrapped Saw Cut None (Open Hole)

SCREEN-PERFORATED INTERVALS: From 6.5 ft. to 16.5 ft., From ft. to ft., From ft. to ft.
GRAVEL PACK INTERVALS: From 4.5 ft. to 16.5 ft., From ft. to ft., From ft. to ft.


9 GROUT MATERIAL: Neat cement Cement grout Bentonite Other Concrete 0-2 feet.....
Grout intervals: From 2 ft. to 4.5 ft., From ft. to ft., From ft. to ft.

Nearest source of possible contamination:
 Septic Tank Lateral Lines Pit Privy Livestock Pens Insecticide Storage
 Sewer Lines Cess Pool Sewage Lagoon Fuel Storage Abandoned Water Well
 Watertight Sewer Lines Seepage Pit Feedyard Fertilizer Storage Oil Well/Gas Well
 Other (Specify)

Direction from well? W Distance from well? 123 ft.

10 FROM	TO	LITHOLOGIC LOG	FROM	TO	LITHO. LOG (cont.) or PLUGGING INTERVALS
0	1	Asphalt/Fill			
1	16.5	clay			
16.5		Limestone			

11 CONTRACTOR'S OR LANDOWNER'S CERTIFICATION: This water well was constructed, reconstructed, or plugged under my jurisdiction and was completed on (mo-day-year) 11/5/2021..... and this record is true to the best of my knowledge and belief. Kansas Water Well Contractor's License No. 759..... This Water Well Record was completed on (mo-day-year) 12/12/2021..... under the business name of RAZEK Environmental, LLC Signature [Signature]

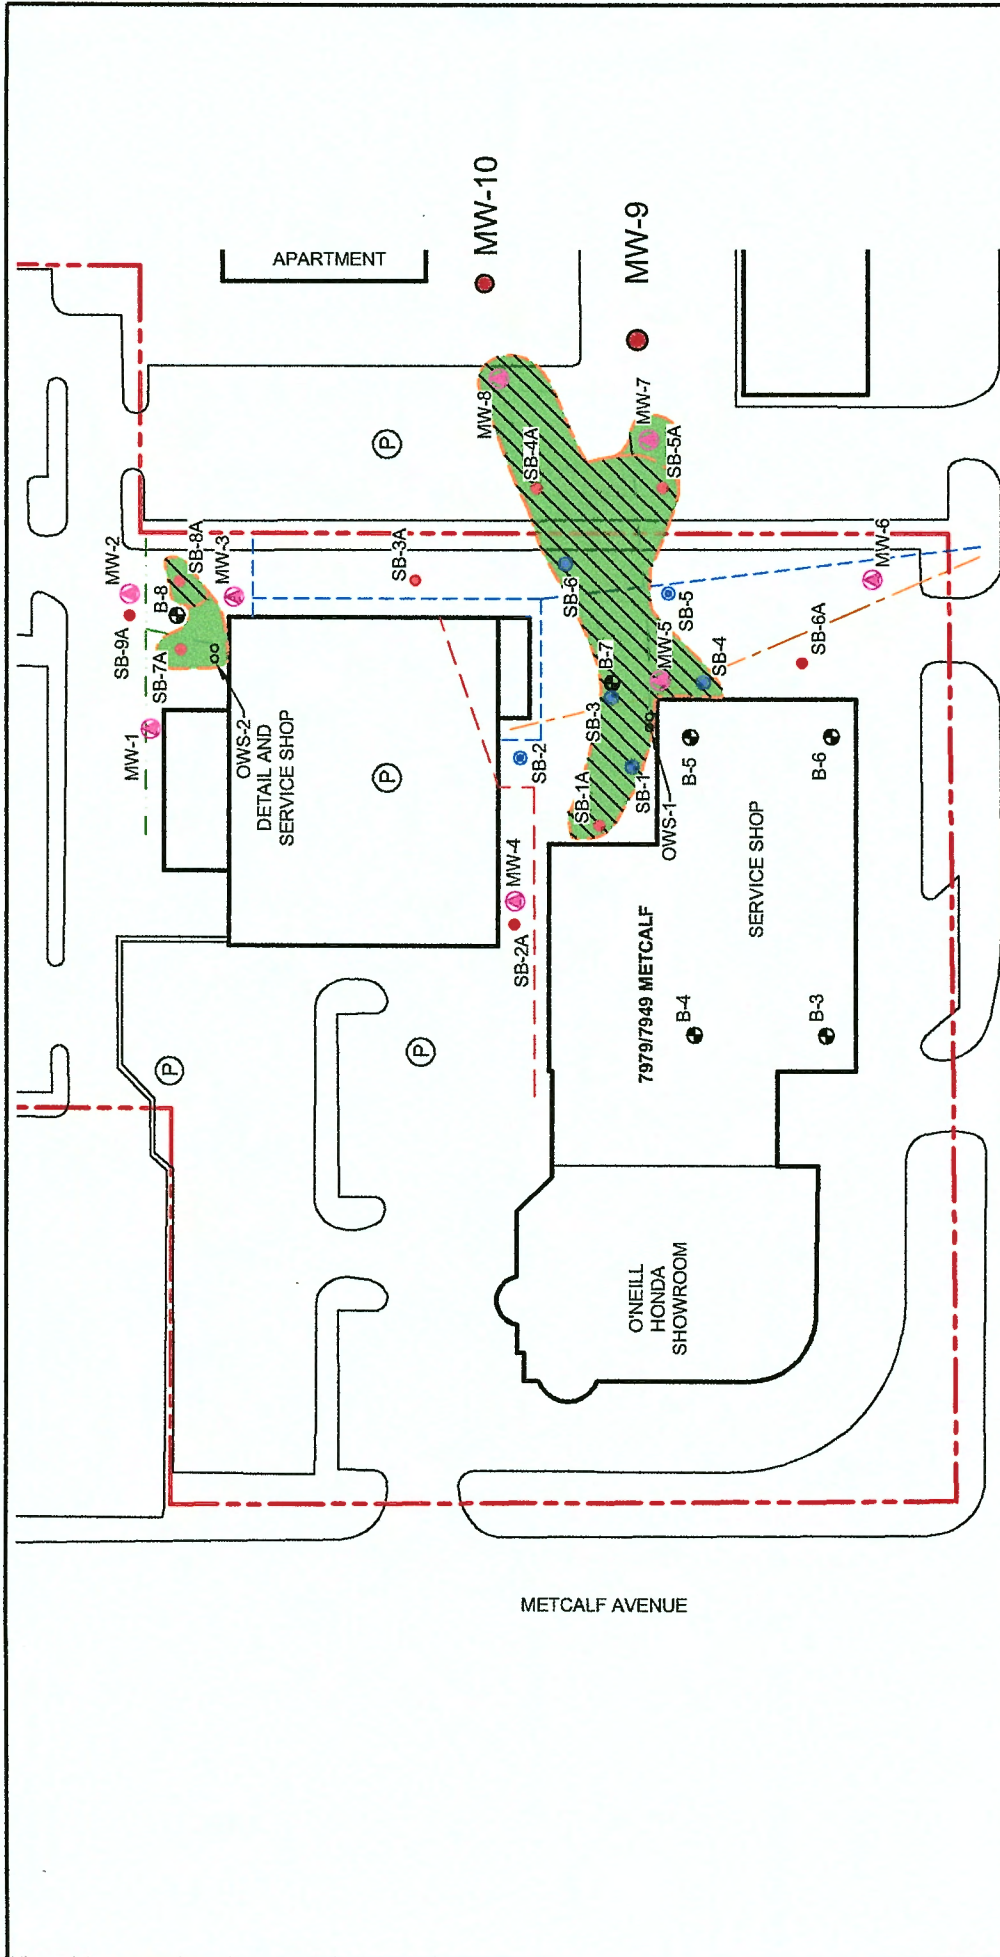

NOTE: FROM OCTOBER 2020 AND MARCH 2021 DATA

- LEGEND**
- APPROXIMATE SITE BOUNDARY
 - PARKING AREA
 - PREVIOUS BORING BY SGE (MARCH 2020)
 - PREVIOUS BORING LOCATION (TERRACON JULY 2020)
 - BORING LOCATION (TERRACON OCTOBER 2020)
 - OIL/WATER SEPARATOR
 - MONITORING WELL
 - IS INTI Proposed Monitoring Well FOR CONSTRUCT...
 - GAS LINES
 - ELECTRIC POWER LINES, CABLES CONDUIT AND LIGHTING CABLES
 - SEWERS AND DRAIN LINES
 - POTABLE WATER
 - TPH ABOVE KDHE RESIDENTIAL RSK
 - TPH ABOVE KDHE NON-RESIDENTIAL RSK

GROUNDWATER EXCEEDANCES - TPH (MARCH 2021)		EXHIBIT
O'NEILL HONDA 7979 METCALF AVENUE OVERLAND PARK, KANSAS		15
Project No.	02207014	<p>Consulting Engineers and Scientists 15620 W 113TH STREET PH: (913) 482-7777</p>
Scale:	1" = 70'	
Date:	05/24/2021	
File No.	02207014E2.DWG	
Project Mgr:	KRC	<p>Proposed Monitoring Well</p>
Approved By:	KRC	
Checked By:	KRC	
By:	DBM	