
WATER WELL RECORD Form WWC-5			Div	vision of Water					
X Original Record	Correction Change	n Well Ust	Reso	ources App. No.		Well ID	MW7		
1 LOCATION OF V	VATER WELL:	Fraction		Section Numb	er Township Nur	nber Range Nu	mber		
County Johnson		SE ¼ NE ¼ NE	'/4 NE !	/4 30	T 12	S R 25	X E W		
2 WELL OWNER: Last Name: First: Street or Rural Address where well is located (if unknown, distance and direction									
Business: Sinclair Marketing, Inc.  Address: 550 East South Temple  from nearest town or intersection): If at owner's address, check here:  ~80 ft N of 7950 Metcalf Ave. Overland Park, KS									
1	Address: 550 East South Temple —80 ft N of 7950 Metcalf Ave, Overland Park, KS Address:								
City Salt La	ake City State: UT	ZIP: 84102							
3 LOCATE WELL		DMPLETED WELL:	4 ft	5 Latitude:	38.984		ial degrees)		
WITH "X" IN	WITH "X" IN Depth(s) Groundwater Encountered: 1) SECTION BOX: 2) ft 3) ft, or 4) Dry Weil				ft Longitude 94.66798 (decimal degrees)  Horizontal Datum: WGS 84 NAD 83 NAD 27				
					ft. Source for Latitude/Longitude:				
	X below land surface, measured on (mo-day-yr)				unit make/model:		)		
NW NE above land surface, measured on (mo-day-yr)				(WAAS enabled? Yes No)					
Pump test data: Well water wasft				X Land Survey Topographic Map					
W after hours pumping gpr Water well was ft				m Online Mapper					
	after hours numping			om 6 Elevation 1035.42 ft Ground Level X TOC					
SW SE Estimated Yield: gpm			,,,,,,	Source X Land Survey GPS Topographic Map					
Bore Hole Diameter: 7.25 in to			t, and	Other					
s in to			i	<b></b>	,		,,,,,,,,,,,,,,,,,,,,,,,,,,,,,,,,,,,,,,,		
7 WELL WATER TO									
1 Domestic:	5 Public Water St	ipply: well 4D		10 Oil Field V	Water Supply: leas	e.			
Household	6 Dewatering: he			11 Test Hole: wel		·			
Lawn & Garden 7 Aquifer Recharge: well ID				Cased Uncased Geotechnical					
Livestock 8 X Monitoring: well ID MW7				12 Geothermal: How many bores?					
2 Irrigation 9 Environmental Remediation: well ID				a) Closed Loop Horizontal Vertical					
3 Feedlot Air Sparge Soil Vapor Extraction 4 Industrial Recovery Injection				b) Open Loop Surface Discharge Inj. of Water					
	Recovery	Injection		Other (spo	city):				
Was a chemical/bacteriological sample submitted to KDHE? Yes X No If yes, date sample was submitted:									
Water well disinfected? Yes X No									
8 TYPE OF CASING USED: Steel X PVC Other CASING JOINTS: Glued Clampled Welded X Threaded									
Casing diameter 2 in. to 4 ft, Diameter in. to ft, Diameter in. to ft, Casing height above land surface -0.50 in. Weight lbs./ft. Well thickness or gauge No									
TYPE OF SCREEN OR PERFORATION MATERIAL:									
Steel Stainless Steel Fiberglass X PVC Other (Specify)									
Brass Galvanized Steel Concrete tile None used (open hole)									
SCREEN OR PERFORATION OPENINGS ARE:									
Continuous Slot X Mill Slot Gauze Wrapped Torch Cut Drilled Holes Other (Specify)  Louvered Shutter Key Punched Wire Wrapped Saw Cut None (Open Hole)									
SCREEN-PERFORATED INTERVALS: From 4 ft. to 14 ft, From ft. to ft, From ft. to ft,									
GRAVEL PACK INTERVALS: From 2 ft. to 14 ft, From ft. to ft, From ft. to ft,									
9 GROUT MATERIAL: Neat cement Cement grout X Bentonite X Other Concrete: 0-0.5'									
9 GROUT MATERIAL: Neat cement Cement grout X Bentonite X Other Concrete: 0-0.5' Grout intervals: From 0.5 ft. to 2 ft, From ft. to ft, From ft. to ft,									
Nearest source of possible				***************************************					
Septic Tank	Lateral Lines	Pit Privy	Live	estock Pens	Insecticide	Storage			
, <del></del>	Sewer Lines Cess Pool Sewage Lagoon			Fuel Storage					
Watertight Sewer Lin	nes Seepage Pit	Feedyard	Fert	ilizer Storage	Oil Well /	Gas Well			
Other (Specity) Direction from well?		Distance Community			6				
10 FROM TO	TPHOTO	Distance from well?		T					
0 0.5	Asphalt LITHOLC	GIC LOG	FROM	TO	LITHO, LOG (co	nt.) or PLUGGING I	NTERVALS		
0.5	Sand fill								
1 7	Clay					-			
7 14	Weathered shale		-						
			Notes: KD	HE ID: Sinclair	#15006; U4-046-00	)437			
Target of monitoring well is shallow groundwater, <20' of grout was installed at									
the direction of KDHE.  CONTRACTOR'S OR LANDOWNER'S CERTIFICATION: This water well was X constructed, reconstructed, or placed under my									
jurisdiction and was completed on (mo-day-year) 1/3/22 and this record is true to the best of my knowledge and belief. Kansas Water Well Contractor's License No 757 This Water Well Record was completed on (mo-day-year) 3/24/22									
under the business name of Larsen & Associates, Inc.  Signature									
	c copy along with a fee of \$5,00 for	each constructed well to: Kansas l	Department of H				-è		
1000 SW Jackson St., Suite 420, Topeka, Kansas 66612-1367. Mail one to Water Well Owner and retain one for your records. Telephone 785-296-5524.  Visit us at http://www.kdheks.gov/waterwell/index.html  KSA 82a-1212  Revised 7/10/2015									
visit us at http://www.kt	meks.gov/waterwett/mdex.mim	KSA 82a-12	14			Neviseu //	1014013		



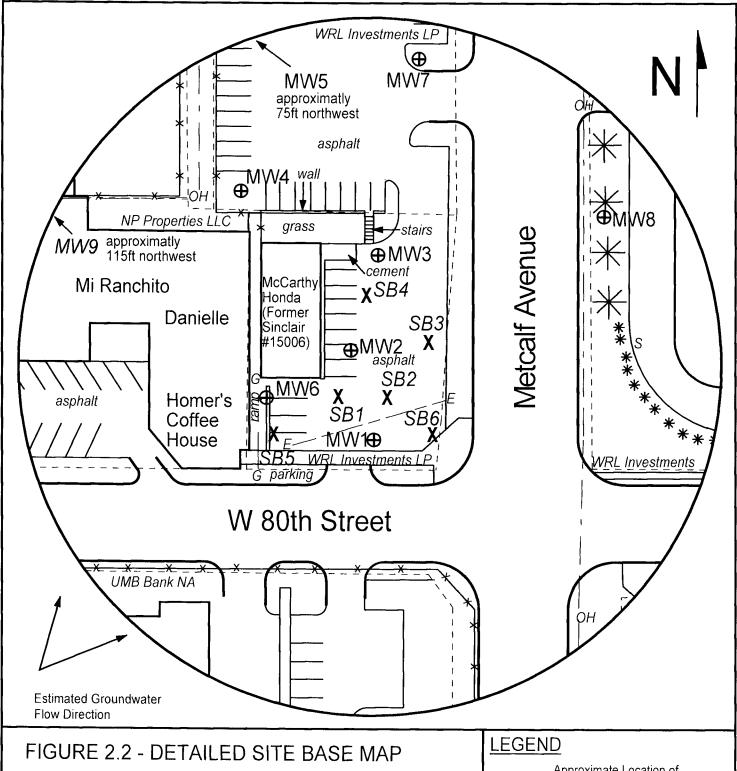

Lawrence, KS 66046

1311 E 25th St., Suite B (785) 841-8707 office (785) 865-4282 fax

## PROJECT:

Sinclair #15006 7950 Metcalf Overland Park, KS KDHE ID: U4-046-00437 Date: 3/8/22

50 ft

Approximate Location of Property Line

- ⊕ New Monitoring Well (Installed 1/3/22 & 1/5/22)
- X Soil Boring (Installed 1/5/22)
- S Sewer Inlet

E — — Electric Lines (2-6 ft bgs)

— Gas Lines (2-6 ft bgs)

— Overhead Lines (25'-40' high)

NOTE: SB5 & SB6 were drilled to collect hydrologic samples. NOTE: Utility depths, heights and locations are approximate. NOTE: Location of the former UST basin is unknown.

50-12-201

## DENNIS L HANDKE

1820 NW 59th Terrace TOPEKA, KANSAS 66618 785-286-4047 Home

Jess Chapman Larsen & Assoc. 1311 E. 25<sup>th</sup> Street, Suite B Lawrence, Kansas 66046 January 25, 2022 Revised March 24, 2022

RE: Monitor Well Elevation Survey 7950 Metcalf, Overland Park, Kansas

North 4792.12

Proj. 22-00C Sinclair #150096 KDHE ID U4-046-00437

SW1/4,NW1/4,NW1/4,NW1/4 (Sec. 29-12-25E)

Long = 94.66755

(from SE Cor. Sec. 30-12-25E)

Bench Mark: Chisled Square on SW corner of concrete storm inlet North of entrance off Mertcalf to

West 27.93

property.

Elev: 1036.92

WY Co

MW-1 1042.24 North 4681.22 SE1/4,NE1/4,NE1/4,NE1/4 rim 74.25 top pipe 1041.80 Lat = 38.98412Long = 94.66798West MW-2 4731.38 rim 1040.29 North SE1/4,NE1/4,NE1/4,NE1/4 top pipe 1039.82 West 86.08 Lat = 38.98426Long = 94.66802MW-3 rim 1039.35 North 4781.15 SE1/4,NE1/4,NE1/4,NE1/4 top pipe 1039.03 West 71.78 Lat = 38.98440Long = 94.66797MW-4 rim 1036.89 4815.22 SE1/4,NE1/4,NE1/4,NE1/4 North 1036.38 141.93 Lat = 38.98449Long = 94.66822top pipe West rim MW-5 1037.81 North 4904.10 SE1/4,NE1/4,NE1/4,NE1/4 1037.56 West 187.64 Lat = 38.98473Long = 94.66834top pipe MW-6 rim 1041.65 North 4706.68 SE1/4,NE1/4,NE1/4,NE1/4 1041.32 129.13 Lat = 38.98419Long = 94.66817top pipe West MW-7 4884.03 rim 1035.92 North SE1/4,NE1/4,NE1/4,NE1/4 top pipe 1035.42 West 74.36 Lat = 38.98468Long = 94.66798

Elevation derived from Johnson County BM #260. NAVD88

North

East

Lat & Long derived from Lenexa 7.5 Quad Map WGS84.

1037.65

1037.23

If you have any tipes ions, please feel free to call me. Thank you for the opportunity to be

4783.01

47.63

Lat = 38.98440

Dennis L Handke RS

MW-8

rim

top pipe