

WATER WELL RECORD

Form WWC-5

Division of Water Resources App. No.


Well ID

MW6

Original Record Correction Change in Well Ust

1 LOCATION OF WATER WELL: County Johnson Fraction SW 1/4 NW 1/4 SW 1/4 SW 1/4 Section Number 32 Township Number T 12 S Range Number R 25 E W

2 WELL OWNER: Last Name: First: Business: Kansas Department of Health and Environment Address: 1000 SW Jackson, Suite 410 City: Topeka State: KS ZIP: 66612 Street or Rural Address where well is located (if unknown, distance and direction from nearest town or intersection): If at owner's address, check here: 9401 Metcalf, Overland Park, KS 66212

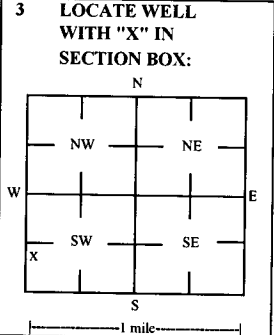

3 LOCATE WELL WITH 'X' IN SECTION BOX: 4 DEPTH OF COMPLETED WELL: 29.5 ft Depth(s) Groundwater Encountered: 1) 22 ft 2) ft 3) ft or 4) Dry Well WELL'S STATIC WATER LEVEL: 3.99 ft below land surface, measured on (mo-day-yr) 6/23/22

5 Latitude: 38.95927 (decimal degrees) Longitude: -94.66734 (decimal degrees) Horizontal Datum: X WGS 84 NAD 83 NAD 27 Source for Latitude/Longitude: GPS (unit make/model): Land Survey Topographic Map Online Mapper 6 Elevation 947.59 ft Ground Level TOC Source: X Land Survey GPS Topographic Map Other

7 WELL WATER TO BE USED AS: 1 Domestic: Household Lawn & Garden Livestock Irrigation Feedlot Industrial 2 Public Water Supply: well ID Dewatering: how many wells? Aquifer Recharge: well ID Monitoring: well ID MW6 Environmental Remediation: well II Air Sparge Soil Vapor Extraction Recovery Inj. Inport 10 Oil Field Water Supply: lease 11 Test Hole: well ID Cased Uncased Geotechnical 12 Geothermal: How many bores? a) Closed Loop Horizontal Vertical b) Open Loop Surface Discharge Inj. of Water Other (specify):

Was a chemical/bacteriological sample submitted to KDHE? Yes No If yes, date sample was submitted: Water well disinfected? Yes No

8 TYPE OF CASING USED: Steel PVC Other CASING JOINTS: Glued Clamped Welded Threaded Casing diameter 2 in. to 19.5 ft Diameter in. to ft Diameter in. to ft Casing height above land surface -0.48 in. Weight lbs./ft. Well thickness or gauge No TYPE OF SCREEN OR PERFORATION MATERIAL: Steel Stainless Steel Fiberglass PVC Other (Specify) SCREEN OR PERFORATION OPENINGS ARE: Continuous Slot Mill Slot Gauze Wrapped Torch Cut Drilled Holes Other (Specify) Louvered Shutter Key Punched Wire Wrapped Saw Cut None (Open Hole) SCREEN-PERFORATED INTERVALS: From 19.5 ft. to 29.5 ft. From ft. to ft. From ft. to ft. GRAVEL PACK INTERVALS: From 17.5 ft. to 29.5 ft. From ft. to ft. From ft. to ft.

9 GROUT MATERIAL: Neat cement Cement grout Bentonite Other Concrete: 0-0.5' Grout intervals: From 0.5 ft. to 17.5 ft. From ft. to ft. From ft. to ft.

Nearest source of possible contamination: Septic Tank Lateral Lines Pit Privy Livestock Pens Insecticide Storage Sewer Lines Cess Pool Sewage Lagoon Fuel Storage Abandoned Water Well Watertight Sewer Lines Seepage Pit Feedyard Fertilizer Storage Oil Well / Gas Well Other (Specify) Direction from well? N Distance from well? 100 ft

Table with columns: FROM, TO, LITHOLOGIC LOG, FROM, TO, LITHO. LOG (cont.) or PLUGGING INTERVALS. Rows include soil layers from 0 to 29.5 ft depth.

Notes: KDHE ID: French Market Dry Cleaning; C4-046-73624 Target of monitoring well is shallow groundwater, <20' of grout was installed at the direction of KDHE.

11 CONTRACTOR'S OR LANDOWNER'S CERTIFICATION: This water well was constructed, reconstructed, or plugged under my jurisdiction and was completed on (mo-day-year) 6/15/22 and this record is true to the best of my knowledge and belief. Kansas Water Well Contractor's License No. 757 This Water Well Record was completed on (mo-day-year) 7/26/22 under the business name of Larsen & Associates, Inc. Signature

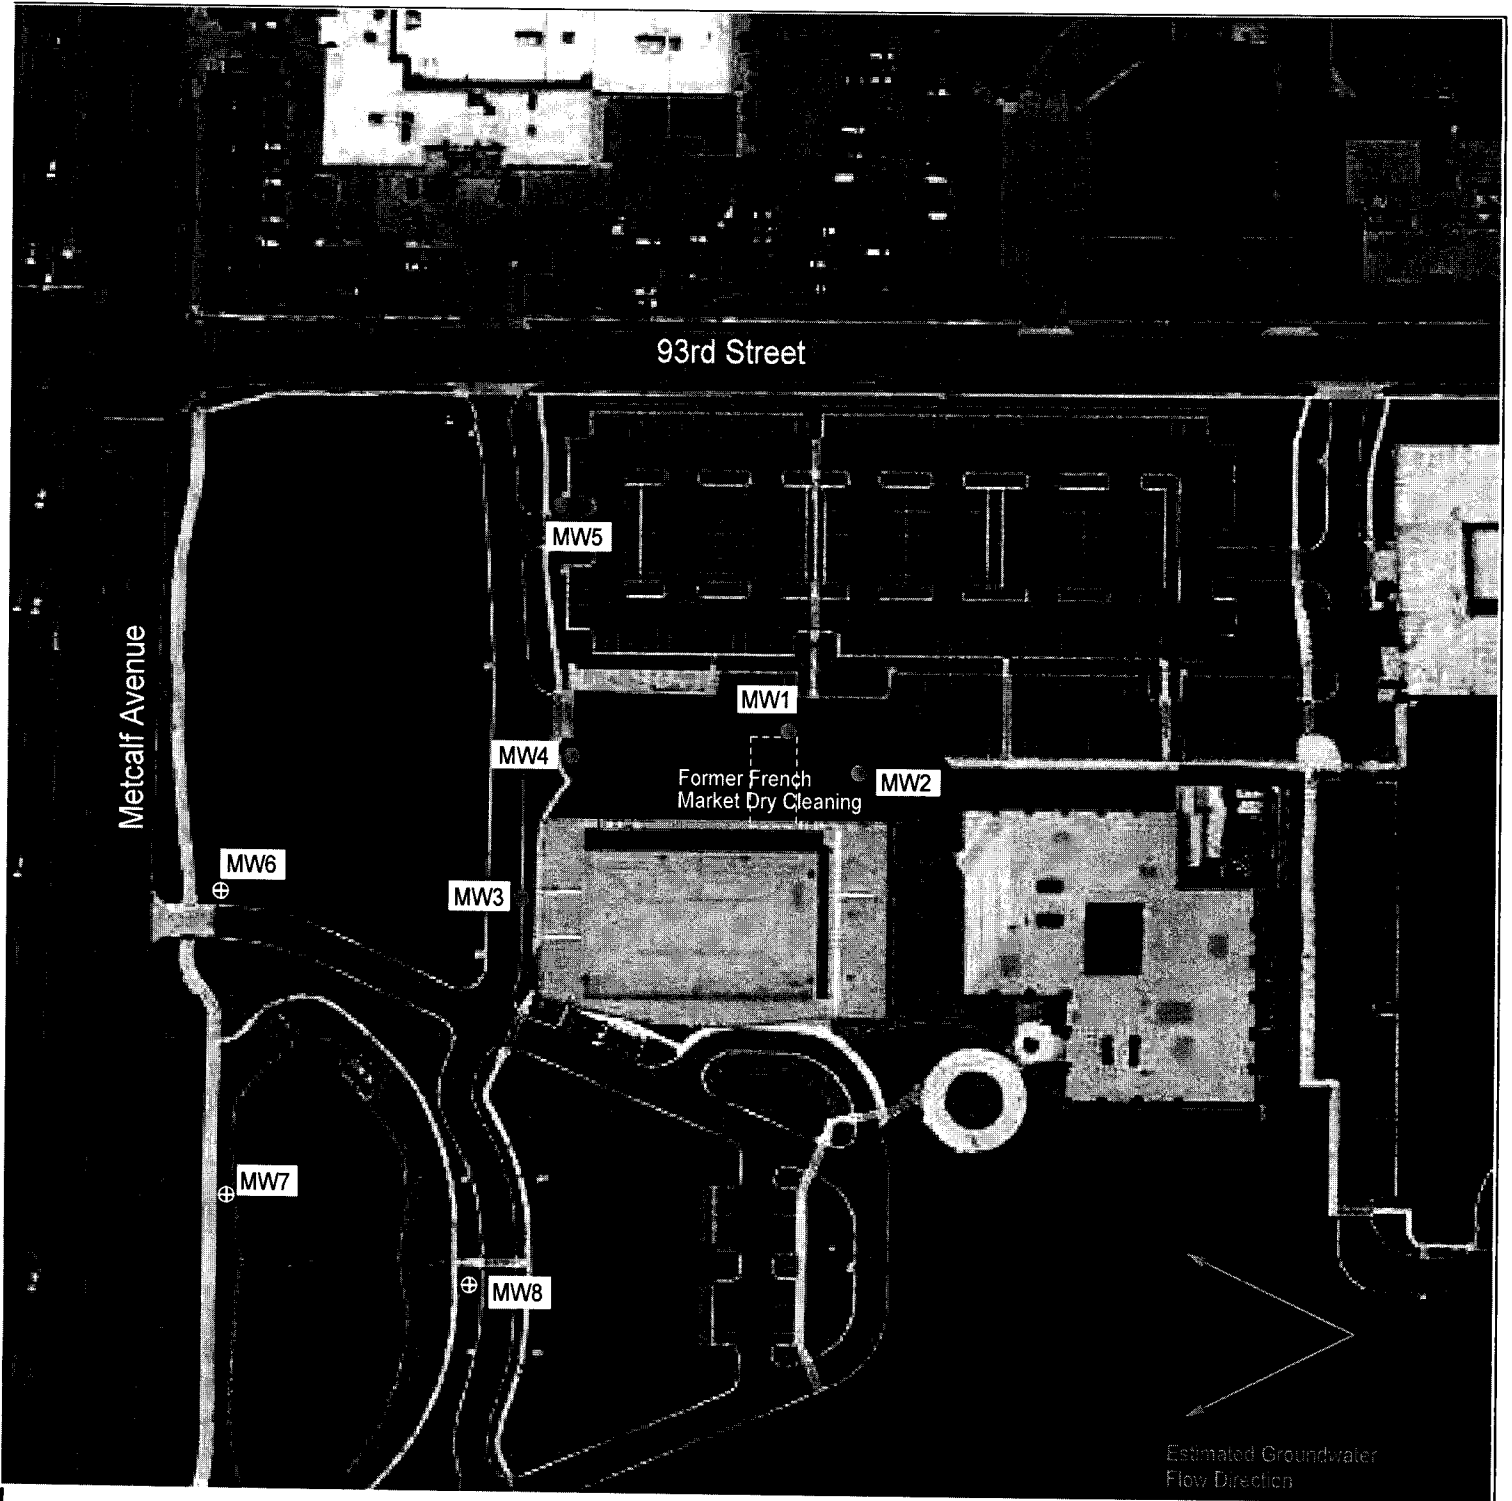


FIGURE 1 - PROPOSED WELL LOCATIONS


LEGEND

- Approximate Location of Former Building Outline
- Monitoring Well (Installed 10/5-7/21)
- ⊕ Proposed Monitoring Well Location



**larsen**  
& ASSOCIATES, INC.

**PROJECT:**  
 French Market Dry Cleaning  
 9401 Metcalf  
 Overland Park, KS  
 KDHE ID: C4-046-73624  
 Date: 6/3/22

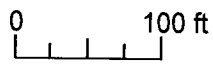

1311 E 25th St., Suite B 785-841-8707 office  
 Lawrence, KS 66046 785-865-4282 fax

Johnson

32-12-25E

ll

# DENNIS L HANDKE

1820 NW 59th Terrace  
TOPEKA, KANSAS 66618  
785-286-4047 Home

Jess Chapman  
Larsen & Associates  
1311 E. 25<sup>th</sup> Street, Suite B  
Lawrence, Kansas, 66046

July 13, 2022

RE: Monitor Well Elevation Survey  
9401 Metcalf, Overland Park, Kansas

Proj. 22-00NN  
French Market Dry Cleaning  
U4-046-73624

Bench Mark: Square cut on Northwest corner of concrete sewer lid South of 93<sup>rd</sup> Street and East of the West entrance to property.


Elev: 958.55      North 1261.17      West 4991.32      (from SE Cor. Sec. 32-12-25E)

MW-6	rim	948.07	North	905.12	SW1/4,NW1/4,SW1/4,SW1/4
	top pipe	947.59	West	5204.96	Lat= 38.95927 Long = 94.66734
MW-7	rim	951.19	North	697.03	SW1/4,NW1/4,SW1/4,SW1/4
	top pipe	950.87	West	5188.84	Lat= 38.95870 Long = 94.66728
MW-8	rim	964.01	North	625.38	NW1/4,SW1/4,SW1/4,SW1/4
	top pipe	963.72	West	5012.45	Lat= 38.95850 Long = 94.66666

Lat & Long derived from Lenexa 7.5 quad map. WGS84.

Elevation established from existing project. NAVD 88

If you have any questions, please feel free to call me. Thank you for the opportunity to be of service to you.

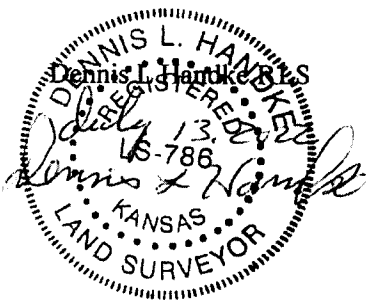

RECEIVED

AUG 01 2022

BUREAU OF WATER