
		T. Commission		77 77 C-3				on of water			ABMW-5D	
		Correction						rces App. No		Well ID		
		WATER WEI	ul:	Fraction	NE 1		Section	on Number	Township Numb		nge Number	
	ty: Dickins			NE 1/4 SW 1/4	NE 7			21	T 13 S		2 ■E□W	
	LOWNER			First:					here well is located			
Address	s: ONE G	Fifth Street				direction fr	om nea	rest town or ir	tersection): If at owner	's address,	check here:	
Address		i ilai Succi			ı	~195' W	of SV	V comer o	f SW 3rd & S Ceda	ar Sts., A	bilene	
City:	Tulsa		State: OK	ZIP: 74103	ı					•		
3 LOCA	TE WELL					44			20.04244	20		
	"X" IN				LL:44 ft.			5 Latitude: 38.9131138 (decimal degrees)				
SECTI	ON BOX:			acountered: 1) ft.				Longitude:97.2173129(decimal degrees)				
N 2) ft. 3)			ft., or 4) Dry Well				Horizontal Datum: ☐ WGS 84 ■ NAD 83 ☐ NAD 27					
WELL'S STATIC WATER L								Source for Latitude/Longitude:				
1 4	1 ' 1			measured on (mo-day-yr)measured on (mo-day-yr)				GPS (unit make/model:				
NW-	NE			ter was ft.				(WAAS enabled? ☐ Yes ☐ No)				
w	 	- ۵ -		pumpinggpm				Land Survey Topographic Map				
}		·		ater was				Online Mapper:				
SW -	SE	after		pumpinggpm			4440.00					
		Estimated Y	ield:	gpm			ı	6 Elevation: 1148.68ft. Ground Level TOC				
	S	Bore Hole I	Diameter:	8.5 in to	44	ft. and	- !	Source:	Land Survey 🔲 🤇	SPS 🔲 T	opographic Map	
1	mile		•••	in. to		ft.			☐ Other			
7 WELL	WATER 7	O BE USED A										
1. Domestic	o:	5. 🗆	Public Wat	er Supply: well II	D			10. 🔲 Oil F	ield Water Supply: le	ase		
☐ House	ehold			: how many well					le: well ID			
☐ Lawn	& Garden	7. 🗆	Aquifer Re	charge: well IDA					d 🗌 Uncased 🔲 G			
☐ Lives	tock								mal: how many bores'			
2. Irrigat				Remediation: we					ed Loop 🔲 Horizonta			
3. Feedle				☐ Soil Va		Extraction		b) Open Loop Surface Discharge Inj. of Water				
4. 🗌 Indust	trial		Recovery	☐ Injection	n			13. Other	(specify):			
Was a che	mical/bact	eriological san	ple submi	tted to KDHE?		Yes N	o If	ves, date sa	mple was submitted	i:		
		1? 🗌 Yes 🔳			_			• ,	A			
				Other		CAS	SING	JOINTS: F	Glued Clamped	□ Welde	d Threaded	
Casing dian	neter 2	in. to	33.5 _{ft}	Diameter 2		in to	44	ft. Diamete	r in. to	ft.	- Inicaded	
Casing heig	ht above land	i surfaceC).53 in.	Weight		lbs./f	ì. 1		s or gauge No. Sch.			
		R PERFORAT					•••	,, an amount	or Brabe 140. In the			
☐ Steel		ainless Steel	☐ Fiberg		'C			☐ Other	(Specify)			
Brass	_	lvanized Steel	☐ Concre		_	sed (open h	ole)		(open) /			
. –	_	RATION OPE					,					
	nuous Slot	Mill Slot			l To	rch Cut	Drille	ed Holes	Other (Specify)			
☐ Louve	ered Shutter	☐ Key Punch	ed 🔲 Win	re Wrapped	Sav	v Cut □	None	(Open Hole)			
SCREEN-I	PERFORAT	TED INTERVA	LS: From	33,5 ft. to .43	3.5	ft., Fron	n	ft. to	ft., From	ft. to	π.	
G	RAVEL PA	CK INTERVA	LS: From	30 ft. to	44	ft Fron	n	ft. to	ft., From	ft. to	ft.	
9 GROUT	MATERI	AL: Neat co	ement 🗍 (Cement grout	Ber	ntonite	Other	 Concrete 				
Grout Interv	als: From	0 ft. to	1.5	ft. From . 1.5	1	i to 3	0	ft. From	ft. to	₩		
Nearest sou	rce of possil	ole contaminatio	n:	,				,			1	
☐ Septic			ateral Lines	☐ Pit Priv	ry	[Live	estock Pens	☐ Insectici	de Storage		
☐ Sewer			ess Pool	☐ Sewage		oon [☐ Fue	1 Storage	☐ Abandon			
	ight Sewer L		eepage Pit	☐ Feedya			☐ Fert	tilizer Storage	e 🔲 Oil Well	/Gas Well	i	
	m well?				n we	11?			ft.			
10 FROM	TO	L	THOLOGI	C LOG		FROM		TO LIT	THO. LOG (cont.) or F	LUGGIN	G INTERVALS	
0	0.25	Asphalt					\perp					
0.25	0.5	Gravel and f	sand									
0.5	5	Silt and clay										
5	10	Clay, some si	lt				\top					
10	17	Silt, some cla						ĺ				
17	25	Clay, some si										
25	30	Silt, some cla				Notes:		L				
30	40	Sand, f-vf, an				110000					1	
11 CONT	40 44 Sand, tr. gravel, silt 11 CONTRACTOR'S OR LANDOWNER'S CERTIFICATION: This water well was constructed, reconstructed, or plugged											
under my jurisdiction and was completed on (mo-day-year). 6/5/2017 and this record is true to the best of my knowledge and belief.												
Kansas Wat	ter Well Co	ntractor's Licer	se No. 52	7 This	Wat	er Well Re	ecord	was comple	and on (ma-day-vea	r) 6/14/2	01.7.	
Kansas Water Well Contractor's License No. 527												
Mail 1	white copy al	ong with a fee of \$	5.00 for each o	constructed well to:	Kans	as Departmen	nt of H	ealth and Envi	ronment, Bureau of Wate	r, GWTS S	ection,	
	1000 SW Jackson St., Suite 420, Topeka, Kansas 66612-1367. Mail one to Water Well Owner and retain one for your records. Telephone 785-296-5524.											
		s.gov/waterwell/inc				SA 82a-1			•		7/10/2015	

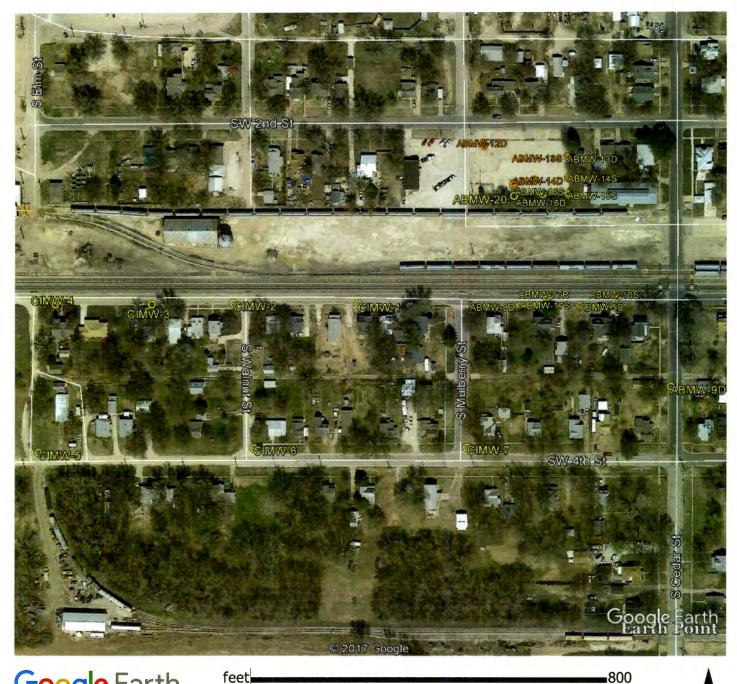

Google Earth

feet meters

200



ONE Gas (for Burns and McDonell) Abilene, Kansas

GPS Coordinates:

ABMW-5D:	38.9131138, -97.2173129	ABMV
ABMW-8D:	38.9131136, -97.2177859	ABMV
ABMW-9D:	38.9126168, -97.2165918	ABMV
ABMW-12D:	38.9140816, -97.2180669	ABMV
ABMW-12S:	38.9140928, -97.2180625	ABMV
ABMW-13D:	38.9140131, -97.2174146	ABMV
ABMW-13S:	38.9140215, -97.2174165	ABMV

W-14D: 38.9138852, -97.2174120 W-14S: 38.9138946, -97.2174112 W-15D: 38.9137872, -97.2174094 W-15S: 38.9137961, -97.2174099 W-16D: 38.9137847, -97.2175987 W-16S: 38.9137858, -97.2176098 W-17D: 38.9131615, -97.2175552

ONE Gas Abilene, Kansas Sheet 2

GPS Coordinates (cont'd):

ABMW-17S:	38.9131598, -97.2175651	CIMW-1:	38.9131215, -97.2190620
ABMW-17R:	38.9131607, -97.2175770	CIMW-2:	38.9131258, -97.2200443
ABMW-18D:	38.9131643, -97.2170046	CIMW-3:	38.9131235, -97.2206910
ABMW-18S:	38.9131589, -97.2170173	CIMW-4:	38.9131245, -97.2214561
ABMW-19:	38.9138752, -97.2176725	CIMW-5:	38.9122182, -97.2215866
ABMW-20:	38.9137790, -97.2178331	CIMW-6:	38.9122408, -97.2198854
ABMW-21:	38.9138473, -97.2178333	CIMW-7:	38.9122432, -97.2181998