
		RECURD		W W C-5				sion of Wa				nan m	ABMW-18D
		Correction		ge in Well Use				rces App.		Townshi		Well ID	an Mumban
		WATER WEI	LL:	Fraction NE 1/4 SW 1/4	ME I	, ANA/ 1/	Secti	ion Numi 21	oer	I ownsni T	ip Number 13 S		nge Number BE □ W
	ty: Dickins				INE 7								
	OWNER:			First:									, distance and
Address	s: ONE Ga	Fifth Street				direction i	rom ne	arest town	or inte	rsection): 13	at owner's	address,	check here:
Address		i illii Sueet				~110' W	of N	W corne	of s	SW 3rd 8	S Cedar	Sts., Al	bilene
City: Tulsa State: OK ZIP: 74103													
3 LOCA		4 DEDON	LOD COL			42	_			30	01316/3	!	
WITH	WITH "X" IN 4 DEPTH OF COMPLETED WELL:												
SECTI	SECTION BOX: Depth(s) Groundwater Encountered:									itude:97.2170046(decimal degrees) ontal Datum: WGS 84 NAD 83 NAD 27			
}	2) ft. 3) ft., WELL'S STATIC WATER LEVEL:								83 LI NAD 27				
							GPS (unit make/model:)						
NOV	below land surface, measured on (mo-day-				- /		٦,			bled? \ \ Y			
1 1 1 1	7			vater was							Topograph		,
w H	┞┈╏	after	hour	s pumping		gpm	gpm						
637	SE			vater was									
5\\	^~SE			s pumping		gpm 6 Elevation: 1148.87 n			Ground	LI evel T TOC			
	اللليا	Estimated Y	ield:	gpm .8.5 in. to43 ft. and			6 Elevation: 1148.87ft. ☐ Ground Level ☐ TOC Source: ☐ Land Survey ☐ GPS ☐ Topographic Map						
1	S mile I	Bote Hole I	Jiameter:	.9.9 in. to		ft. and Source:			Other				
· · · · · · · · · · · · · · · · · · ·	<u> </u>			in. to		n.	-	<u> </u>					
1. Domestic		O BE USED A		ton Cummless swall	ID			10 🗆 0):1 E:_	ld Water C	ummler lange		
Domestic		3. L	J Public wa I Downtorin	ter Supply: well g: how many we	ייי. עני פוני	••••••	••••				uppiy: iease		
1 - '	& Garden			echarge: well ID							ed Geo		
Livest		8.	Monitorin	g: well ID	ABM	N-18D					iny bores?		
2. Irrigat				al Remediation:							Horizontal		
3. Feedle				Soil V									Inj. of Water
4. Indust			Recovery										
		oriological can	nnla cubm	itted to KDHI		Vec N	Jo I						
		eriologicai sali l? ☐ Yes ■ 1			a. 🗀	i cs	10 1	ı yes, da	C Sai	ipic was s	aumme		• • • • • • • • • • • • • • • • • • • •
9 TVDE	OF CASING	C LICED.	tool DV	C D Other		CA	SINIC	LOINITO	<u>. </u>	Glued 🗆	Clomped F	Wolder	Threaded
Casing dian	neter 2	in to	32.5 A	Other Diameter Weight	2	in to	43	f Diar	neter	Glucu 🗀	in to	n relace	i i i i i i i i i i i i i i i i i i i
Casing heig	ht above land	surface -().37 in	Weight		ibs./	ff.	Wall thic	kness	от даиде Х	Sch. 40)	
TYPE OF	SCREEN C	R PERFORAT	TON MAT	TERIAL:						BB			
☐ Steel		inless Steel	☐ Fiber		VC			☐ Ot	her (S	pecify)			
☐ Brass		lvanized Steel			None u	sed (open i	hole)		•	• •			
SCREEN (OR PERFO	RATION OPE											
☐ Conti	nuous Slot	Mill Slot	☐ Ga	uze Wrapped	☐ To	rch Cut [] Dril	led Holes		Other (Spec	cify)		
☐ Louve	ered Shutter	☐ Key Punch	ned 🔲 W	ire Wrapped	□ Sa	w Cut [] Non	ie (Open F	lole)				
				32.5 ft. to .									
G	RAVEL PA	CK INTERVA	LS: From	29 ft. to	43	ft., Fro	m	ft. t	0	ft., I	rom	ft. to	ft.
9 GROUI	r materi	AL: Neat c	етерт 🔲	Cement grout . ft., From . 1.5.	Be	ntonite	Othe	er Conci	rete			• • • • • • • • •	
Grout Interv	als: From.	fl. to	1.5	. ft., From79.	•••••	ft. to	29	. ft., From	•••••	ft. t	0	ft.	
		ole contaminatio								_		a .	
☐ Septic			ateral Lines				_	vestock Pe		_	Insecticide	_	17_11
☐ Sewer	Lines ight Sewer L		Cess Pool	☐ Sewa ☐ Feed				el Storage rtilizer Sto			Abandoned Oil Well/G		veli
			eepage Pit Site				_ re	LILLIZEI SIL	nage	u	OII WEILG	as Frell	
Direction from	om well?	er i registili i editerili A		Distance fr	om w	:117					ft.		
10 FROM	TO		THOLOG			FROM						UGGINO	INTERVALS
0	0.25	Asphalt				1					,		
0.25	0.5	Gravel and f	sand			1							
0.5	5	Silt, some cla				1	+	1					
5	10	Clay, some s					+-						
10	16.5	Silt, some cla				 							
16.5	30	Clay, some si					_						
30		Sand, vf-f, an				Notes:						•	
35	43			gravel	_	110.63.							
JJ	35 43 Sand, m-vf, tr. silt and gravel												
11 CONTRACTOR'S OR LANDOWNER'S CERTIFICATION: This water well was constructed, reconstructed, or plugged													
under my jurisdiction and was completed on (mo-day-year) .6/5/20.17 and this record is true to the best of my knowledge and belief.													
Kansas Wa	ter Well Co	ntractor's Lice	nse No. 5	27 Thi	is Wa	ter Well R	Record	l was con	nn let	ed on (mo	-day-year)	6/14/2	Q1.7
under the b	usiness nam	e of GeoCore	e inc				Signa	iture	Ř.L.	U Va			
Mail 1	l white copy al	ong with a fee of \$	5.00 for each	constructed well to	o: Kan	sas Departm	ent of I	Health and	Enviro	nment, Bure	ay of Water,	GWTS Se	ection,
	1000 SW Jackson St., Suite 420, Topeka, Kansas 66612-1367. Mail one to Water Well Owner and retain one for your records. Telephone 785-296-5524.												
Visit us at http://www.kdheks.gov/waterwell/index.html KSA 82a-1212 Revised 7/10/2015													

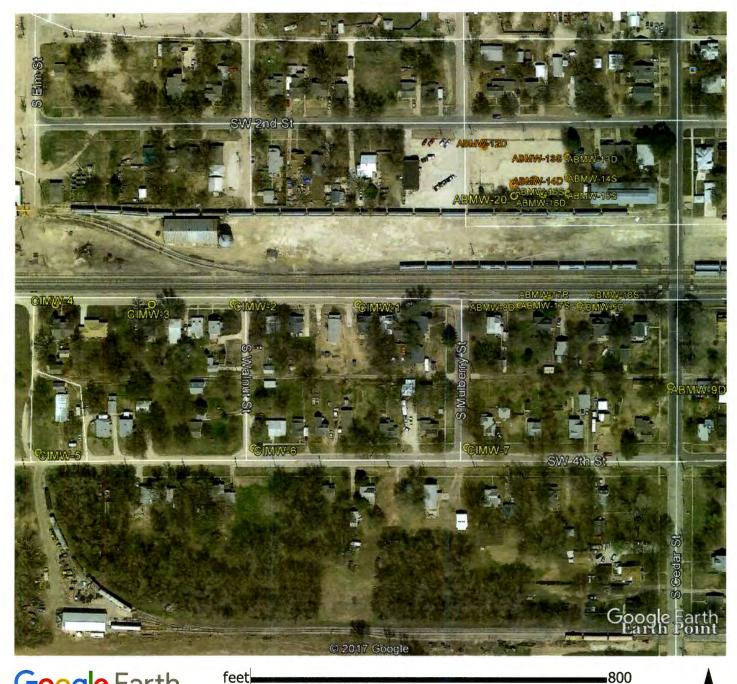

Google Earth

feet meters

200



ONE Gas (for Burns and McDonell) Abilene, Kansas

GPS Coordinates:

ABMW-5D:	38.9131138, -97.2173129	ABMV
ABMW-8D:	38.9131136, -97.2177859	ABMV
ABMW-9D:	38.9126168, -97.2165918	ABMV
ABMW-12D:	38.9140816, -97.2180669	ABMV
ABMW-12S:	38.9140928, -97.2180625	ABMV
ABMW-13D:	38.9140131, -97.2174146	ABMV
ABMW-13S:	38.9140215, -97.2174165	ABMV

W-14D: 38.9138852, -97.2174120 W-14S: 38.9138946, -97.2174112 W-15D: 38.9137872, -97.2174094 W-15S: 38.9137961, -97.2174099 W-16D: 38.9137847, -97.2175987 W-16S: 38.9137858, -97.2176098 W-17D: 38.9131615, -97.2175552

ONE Gas Abilene, Kansas Sheet 2

GPS Coordinates (cont'd):

ABMW-17S:	38.9131598, -97.2175651	CIMW-1:	38.9131215, -97.2190620
ABMW-17R:	38.9131607, -97.2175770	CIMW-2:	38.9131258, -97.2200443
ABMW-18D:	38.9131643, -97.2170046	CIMW-3:	38.9131235, -97.2206910
ABMW-18S:	38.9131589, -97.2170173	CIMW-4:	38.9131245, -97.2214561
ABMW-19:	38.9138752, -97.2176725	CIMW-5:	38.9122182, -97.2215866
ABMW-20:	38.9137790, -97.2178331	CIMW-6:	38.9122408, -97.2198854
ABMW-21:	38.9138473, -97.2178333	CIMW-7:	38.9122432, -97.2181998