
			WWC-5			ion of Water	l			ABMW-18S
			ge in Well Use			rces App. No.			Well ID	
		WATER WELL:	Fraction		Section	on Number	1	hip Numb		ange Number
	ty: Dickins		NE 1/4 SW 1/4 NE 1/			21	<u> </u>	13 S		2 ■E □ W
	LOWNER:		First:			Address wh				
Busines	s: ONE G	as, inc. Fifth Street					,			, check here:
Address		Film Succi		~115' W	of N	W corner of	SW 3rd	& S Ceda	ar Sts., <i>F</i>	\bilene
City:	Tulsa	State: OK	ZIP: 74103							
3 LOCA		4 DEPTH OF COL	MPLETED WELL:	30	4	5 T - 4444 d a	. 3	8 91315	89	(decimal degrees)
	"X" IN									
SECTI	ON BOX:		Encountered: 1) ft.			Longitude:97.2170173(decimal degrees) Horizontal Datum: □ WGS 84 ■ NAD 83 □ NAD 27				
	N		TER LEVEL: ft.					Longitude:		765 🗀 11/30/27
	$\top$	☐ below land surface	, measured on (mo-day-yr)			GPS (unit make/model:)				
NW-	NE		measured on (mo-day-yr)			(WAAS enabled? ☐ Yes ☐ No)				
	1 1 1	1	ater was ft.			■ Land Survey □ Topographic Map				
w	T I	·	pumping gpm			☐ Online Mapper:				
sw-	SE		water was							
1 1	111	Estimated Yield:	gnm							nd Level 🔲 TOC
	S	Bore Hole Diameter:	8.5 in. to 30	ft. and				-		Topographic Map
1	mile		in. to	ft			Other			
7 WELL	WATER T	O BE USED AS:								
1. Domestic			ater Supply: well ID							
☐ House			ng: how many wells?			11. Test Hole				
1 —	& Garden	7. ☐ Aquifer R	echarge: well ID	N-18S	••••			sed G		
Lives			g: well ID ABM\ al Remediation: well II			12. Geotherm		nany bores. Horizonta		
2. ☐ Irrigat 3. ☐ Feedle		9. Environment								Inj. of Water
4. Indust		☐ Recovery		LAHACHON						
		eriological sample subm		Voc.	No I					
		eriological sample subm  ?   Yes  No	intento Kome:	ies 💻 i	וג טא	i yes, date sai	iipic was	Submittee		
0.000	OF CLOTH	CHOPP CO. 1 P.N.	C D Other	CA	SING	IONTS:	Glued C	Clamped	□ Welde	d Threaded
Casing dian	neter 2	in to 19.5 ft.,  surface -0.37 in	Diameter 2	in to	30	ft Diameter	Oluca L	in to	H WEIGH	i i i i i i i i i i i i i i i i i i i
Casing heig	ht above land	surface -0.37 in	. Weight	lbs./	/ <del>f</del> t.	Wall thickness	or gauge	No. Sch.	40	•
TYPE OF	SCREEN C	R PERFORATION MA	TERIAL:							
☐ Steel		inless Steel  Fiber	glass PVC			Other (S	Specify)			
☐ Brass		Ivanized Steel		sed (open	hole)					
1		RATION OPENINGS A				_				
	nuous Slot		auze Wrapped	rch Cut	] Drill	ed Holes	Other (Sp	ecify)		•••••
Louve	ered Shutter	☐ Key Punched ☐ W TED INTERVALS: From	ire Wrapped	w Cut L	_  Non	e (Open Hole)		Г	Δ.	
		CK INTERVALS: From								
Grout Intern	ole: From	AL: Neat cement D	A From 2	nionne I	- Oux 6.5	f From		to		
		ole contamination:	н., гиш		×.w	i., riom	11.			
☐ Septic		Lateral Line	s 🔲 Pit Privy		□ Liv	estock Pens		Insectici	de Storage	
☐ Sewer		Cess Pool	Sewage Lag	goon	☐ Fue	el Storage		Abandon		
		ines			☐ Fer	tilizer Storage	[	] Oil Well	/Gas Well	
Other (	■ Other (Specify) .Contaminated Site									
									TICODI	CDITEDUALC
10 FROM	TO	LITHOLOG	arc LOG	FROM		10   LIII)	MU. LUG	(cont.) of h	LUGGIN	G INTERVALS
0		Asphalt Gravel and f sand			+					
0.25 0.5	0.5			-	+					
5.5	5.5 9	Silt, some clay Clay, some silt			+-			****		
9	16	Silt, some clay		<del> </del>	+		<del></del>			
16	29.5	Clay, some silt		<del></del>	+					
10	23.0	olay, sullic sill		Notes:						
				Hores.						
				†						
11 CONT	11 CONTRACTOR'S OR LANDOWNER'S CERTIFICATION: This water well was constructed, reconstructed, or plugged									
under my jurisdiction and was completed on (mo-day-year) .6/5/20.17 and this record is true to the best of my knowledge and belief.										
Kansas Wa	ter Well Co	ntractor's License No5	2/ This Wat	ter Well F	Record	was complet	🏚 don (m	o-day <sub>z</sub> yez	t) .6/1.4/2	201.7
under the b	usiness nam	e of GeoCore Inc			Signa	ture	ale.	Kally	OTT TO	
		ong with a fee of \$5.00 for each								
		t., Suite 420, Topeka, Kansas 6 s.gov/waterwell/index.html						_		5524. <b>7/10/2015</b>
y isit us at nttr	<u>,,//www.kan</u> ek	s.gov/ water well/index.html		10/1 0/2a-	1414				AFCATOCO	II AUI AUI A

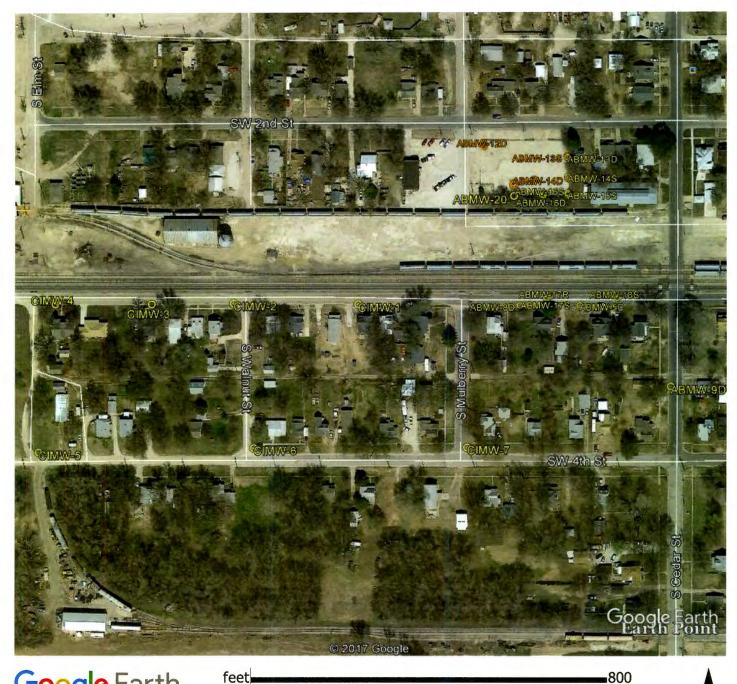

Google Earth

feet meters

200



ONE Gas (for Burns and McDonell) Abilene, Kansas

## **GPS Coordinates:**

ABMW-5D:	38.9131138, -97.2173129	ABMV
ABMW-8D:	38.9131136, -97.2177859	ABMV
ABMW-9D:	38.9126168, -97.2165918	ABMV
ABMW-12D:	38.9140816, -97.2180669	ABMV
ABMW-12S:	38.9140928, -97.2180625	ABMV
ABMW-13D:	38.9140131, -97.2174146	ABMV
ABMW-13S:	38.9140215, -97.2174165	ABMV

W-14D: 38.9138852, -97.2174120 W-14S: 38.9138946, -97.2174112 W-15D: 38.9137872, -97.2174094 W-15S: 38.9137961, -97.2174099 W-16D: 38.9137847, -97.2175987 W-16S: 38.9137858, -97.2176098 W-17D: 38.9131615, -97.2175552

ONE Gas Abilene, Kansas Sheet 2

## GPS Coordinates (cont'd):

ABMW-17S:	38.9131598, -97.2175651	CIMW-1:	38.9131215, -97.2190620
ABMW-17R:	38.9131607, -97.2175770	CIMW-2:	38.9131258, -97.2200443
ABMW-18D:	38.9131643, -97.2170046	CIMW-3:	38.9131235, -97.2206910
ABMW-18S:	38.9131589, -97.2170173	CIMW-4:	38.9131245, -97.2214561
ABMW-19:	38.9138752, -97.2176725	CIMW-5:	38.9122182, -97.2215866
ABMW-20:	38.9137790, -97.2178331	CIMW-6:	38.9122408, -97.2198854
ABMW-21:	38.9138473, -97.2178333	CIMW-7:	38.9122432, -97.2181998