
| | | RECORD | | W W C-5 | | | | on of Water | | Well ID | ABMW-8D |
|--|---|--|---------------------------------------|------------------------------|----------|--|------------|---|--|--------------|----------------------|
| | | ☐ Correction WATER WEL | | ge in Well Use Fraction | | | | ces App. No. on Number | Township Number | | nge Number |
| | ity: Dickins | | L: | NW 1/4 SW 1/ | A NE 1 | | SCCHO | 21 | T 13 S | | ige Number ≥ ■E□W |
| | L OWNER: | | | First: | 4 14- / | | Pural | | ere well is located | | |
| | s: ONE G | | | rust. | | | | | ersection): If at owner | | |
| Address | | Fifth Street | | | | | | | • | • | |
| Address | | | 014 | | | ~328' W | of SV | v comer of | SW 3rd & S Ceda | r Sts., Al | oilene |
| City: | <u>Tulsa</u> | | State: OK | ZIP: 7410; | 3 | | - | | | | |
| | TE WELL | 4 DEPTH | OF COM | IPLETED V | VELL: | 43 | . ft. | 5 Latitude | 38.913113 | 36 | (decimal degrees) |
| | "X" IN | | | Encountered: | | | | | | | |
| SECT | ON BOX: | 2) | ft. 3 | 3) ft., | , or 4) | Dry Well Horizontal Datum: WGS 84 NAD 83 NAD 27 | | | | | |
| | WELL'S STATIC WATER LEVEL: | | | | | Source for Battade, Bongitude. | | | | | |
| '4 | below land surface, measured on (mo-da | | | | | - Constitution in the control of the | | | | | |
| NW- | -NWNE □ above land surface, measured on (mo- Pump test data: Well water was | | | (mo-day | -yr) | | | WAAS enabled? | | lo) | |
| | 111. | | | pumpinggpm | | | - 1 | ■ Land Survey ☐ Topographic Map ☐ Online Mapper: | | | |
| 1 1 ' | 1 '' 1 | | | ater was ft. | | | | | | | |
| sw - | SE | after | | | ng gpm | | | | 1140 40 | | |
| L | | Estimated Yi | eld: | gpm | | | | 6 Elevation: 1148.48 ft. ☐ Ground Level ☐ TOC Source: ☐ Land Survey ☐ GPS ☐ Topographic Map | | | |
| 1 | S | Bore Hole Di | iameter: | 8.5 in. to | 43 | ft. and | | | | | |
| 1 | <u>-</u> | | | in, to . | | ft. | | L | Other | | |
| | | O BE USED A | | | | | | | | | |
| 1. Domesti | | | | ter Supply: we | | | | | ld Water Supply: lea | | |
| House | enoid & Garden | 6. □ | Dewatering | g: how many v | wells? | ••••• | | | : well ID | | |
| Lives | | /. ∐ : 8 ■ | Monitorine | charge: well I g: well ID | ÄÄÄM | W-8D Cased ☐ Uncased ☐ Geotechnical 12. Geothermal: how many bores? | | | | | |
| 2. Irriga | | | | l Remediation | | | | | | | |
| 3. Feedl | | | Air Sparge | | | Extraction | | | .oop Surface Disc | | |
| 4. 🔲 Indus | trial | | Recovery | ☐ Inje | ction | | | | specify): | | |
| Was a che | mical/bact | eriological sam | ple submi | itted to KDH | IE? □ | Yes No | o If | ves, date sar | nple was submitted | • | |
| | | ? ☐ Yes ■ N | | | | | | <i>,</i> , | | | |
| 8 TYPE | OF CASING | G USED: ☐ Ste | el PVC | Other | | CAS | SING. | JOINTS: \Box | Glued Clamped | □ Welded | ■ Threaded |
| Casing diar | neter2 | in. to3 | 2.5 _{ft.,} | Diameter | 2 | in. to | 43 | ft., Diameter | in. to | ft. | |
| Casing heig | ht above land | surface0. | 33 in. | Weight | | lbs./f | ì. V | Wall thickness | Glued Clamped in. to or gauge No. Sch. | 40 | |
| TYPE OF | SCREEN O | R PERFORATI | ON MAT | ERIAL: | | | | | | | |
| ☐ Steel | | inless Steel | ☐ Fiberg | _ | PVC | | | Other (S | Specify) | | |
| Brass | | lvanized Steel | Concre | | None u | sed (open h | ole) | | | | |
| | | RATION OPEN | | | _ ~ | 10.0 | 1 5 .11 | 177 1 | 04 (0 (0) | | |
| | nuous Slot | ■ Mill Slot ☐ Key Punche | | uze Wrapped | | ren Cut | l Mana | (Open Hole) | Other (Specify) | ••••• | |
| SCREEN | EIGU SHUIIGI PEREAR A T | ED INTERVAL | u ∐ wı | 32.5 ft to | . 42.5 | w Cut | J MOTTE | to to | ft., From | A to | A |
| SCILLEIN | RAVEL PA | CK INTERVAL | S. From | 28.5 A to | 43 | II., FIUII | u n | ft. to | ft., From | IL. W | |
| 9 CROIT | MATERI | AI · D Neat cer | ment D | Cement grout | ■ Re | ntonite | Other | Concrete | II., TIOIII | 11. 10 | |
| Grout Interv | als: From | 0 H to | 1.5 | A From 1.5 | 5 | fito 28 | .5 f | From | ft. to | A | |
| Nearest sou | rce of possib | le contamination | 1: | 11., 1 10.00 | | KL 10 | 177 | , | | 16. | |
| ☐ Septic | | | teral Lines | ☐ Pit | Privy | | ☐ Live | stock Pens | ☐ Insectició | e Storage | |
| ☐ Sewer | | | ss Pool | | vage Lag | | | Storage | ☐ Abandon | ed Water V | Vell |
| | ight Sewer L | | epage Pit | ☐ Fee | | | ☐ Ferti | ilizer Storage | ☐ Oil Well/ | Gas Well | |
| | | ontaminated Si | | | | | | | • | | |
| 10 FROM | om well? | | THOLOG | | nom we | FROM | | | IO LOG (sort) or R | LUCCNIC | INTERVALO |
| 0 | ! | | (AULUG) | IL LUG | | rkum | + - | io Inii | HO. LOG (cont.) or P | LUGGINU | MIEKVALS |
| 0.25 | | Asphalt Gravel and f s | and | | | | + | | | | |
| 0.25 | | Silt, some clay | | | | | +- | | | | |
| 5 | | <u>ડાત, some clay</u> Silt and clay | · · · · · · · · · · · · · · · · · · · | | | | + | | | | |
| 10 | | Silt, some clay | , | - | | | + | | | | |
| 17 | | Clay, some ciay | | | | | + | | | | |
| 23 | | Silt and clay | | | | Notes: | | | | | |
| 28 43 Sand, vf-f, and silt | | | | | | 1 | | | | | |
| <u> LU</u> | D 140 Odnu, VI-I, and Silt | | | | | | | | | | |
| 11 CONTRACTOR'S OR LANDOWNER'S CERTIFICATION: This water well was constructed, reconstructed, or plugged | | | | | | | | | | | |
| under my jurisdiction and was completed on (mo-day-year) 6/5/17 | | | | | | | | | | | |
| Kansas Water Well Contractor's License No. 527 This Water Well Record was completed on (morday-year) 6/14/2017 | | | | | | | | | | | |
| Mail 1 white copy along with a fee of \$5.00 for each constructed well to: Kansas Department of Health and Environment, Bureau of Water, GWTS Section, | | | | | | | | | | | |
| Mail 1 | white copy ale | ong with a fee of \$5. | 00 for <u>each</u> | constructed well | to: Kans | as Departmer | nt of He | alth and Enviro | nment, Bureau of Water | , GWTS Se | ction, |
| | 1000 SW Jackson St., Suite 420, Topeka, Kansas 66612-1367. Mail one to Water Well Owner and retain one for your records. Telephone 785-296-5524. Visit us at http://www.kdheks.gov/waterwell/index.html KSA 82a-1212 Revised 7/10/2015 | | | | | | | | | | |
| visit us at http | .//www.kanek | .gov/waterwell/inde | x.nuni | | | SA 82a-1 | 414 | | | mevised i | 7/10/2015 |

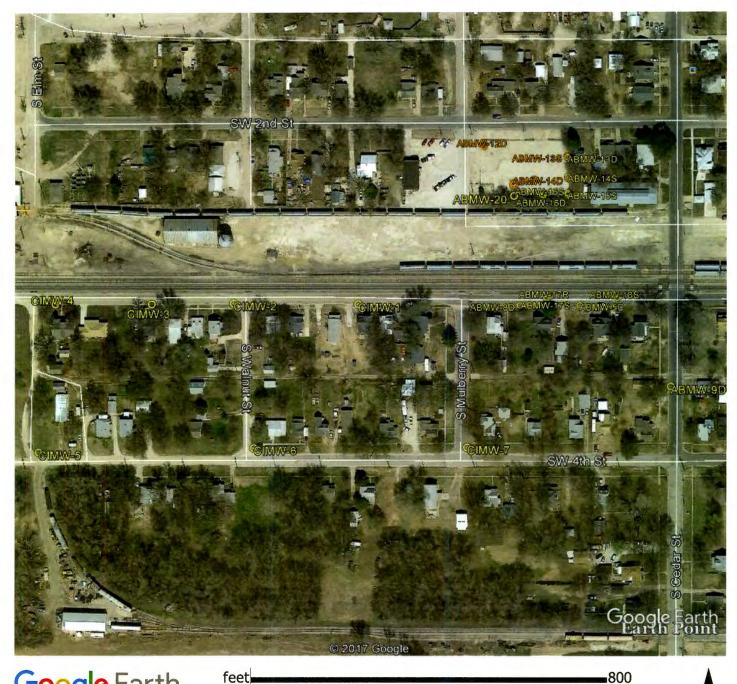

Google Earth

feet meters

200



ONE Gas (for Burns and McDonell) Abilene, Kansas

GPS Coordinates:

| ABMW-5D: | 38.9131138, -97.2173129 | ABMV |
|-----------|-------------------------|------|
| ABMW-8D: | 38.9131136, -97.2177859 | ABMV |
| ABMW-9D: | 38.9126168, -97.2165918 | ABMV |
| ABMW-12D: | 38.9140816, -97.2180669 | ABMV |
| ABMW-12S: | 38.9140928, -97.2180625 | ABMV |
| ABMW-13D: | 38.9140131, -97.2174146 | ABMV |
| ABMW-13S: | 38.9140215, -97.2174165 | ABMV |
| | | |

W-14D: 38.9138852, -97.2174120 W-14S: 38.9138946, -97.2174112 W-15D: 38.9137872, -97.2174094 W-15S: 38.9137961, -97.2174099 W-16D: 38.9137847, -97.2175987 W-16S: 38.9137858, -97.2176098 W-17D: 38.9131615, -97.2175552

ONE Gas Abilene, Kansas Sheet 2

GPS Coordinates (cont'd):

| ABMW-17S: | 38.9131598, -97.2175651 | CIMW-1: | 38.9131215, -97.2190620 |
|-----------|-------------------------|---------|-------------------------|
| ABMW-17R: | 38.9131607, -97.2175770 | CIMW-2: | 38.9131258, -97.2200443 |
| ABMW-18D: | 38.9131643, -97.2170046 | CIMW-3: | 38.9131235, -97.2206910 |
| ABMW-18S: | 38.9131589, -97.2170173 | CIMW-4: | 38.9131245, -97.2214561 |
| ABMW-19: | 38.9138752, -97.2176725 | CIMW-5: | 38.9122182, -97.2215866 |
| ABMW-20: | 38.9137790, -97.2178331 | CIMW-6: | 38.9122408, -97.2198854 |
| ABMW-21: | 38.9138473, -97.2178333 | CIMW-7: | 38.9122432, -97.2181998 |
| | | | |