
		RECORD	Form V				sion of Wat		ł	F7 11 PD	ABMW-17S	
				in Well Use			urces App.		- 1: XX 1	Well ID	\	
		WATER WELI		Fraction	- 1/ 1/	1	tion Numb	er	Township Number		nge Number	
	ty: Dickinso			NW 1/4 SW 1/4 NE			21				² ■E□W	
						Street or Rural Address where well is located (if unknown, distance and lirection from nearest town or intersection): If at owner's address, check here:						
Address:		s, inc. Fifth Street							•	•		
Address		i ilui Olicet			~268' \	V of N	W come	r of S	SW 3rd & S Ceda	ır Sts., Al	oilene	
City:	Tulsa	S	State: OK	ZIP: 74103								
3 LOCAT		A DEPTH	OF COM	PLETED WELI	29.5	fì	5 Lotit	ndo.	38.913159	98	(decimal degrees)	
WITH												
	SECTION BOX: Depth(s) Groundwater Encountered: 1)					Dry Well Horizontal Datum: WGS 84 NAD 83 NAD 27						
WELL'S STATIC WATER LEVEL:						ft. Source for Latitude/Longitude:						
□ below land surface, measured on (mo-day-yr)						(
NW	above land surface, measured on (mo-day-)					• • • • • • •	(· · · · · · · · · · · · · · · · · · ·					
				ter was			■ Land Survey □ Topographic Map					
W	E	atter	-	oumpingter was								
sw	- SE	after		oumping			4440.00					
		Estimated Yie	eld:	gpm			6 Elevation: 1148.66					
	S	Bore Hole Di	ameter:	3.5 in. to 29	.5 ft. and		Source		Land Survey G			
	mile	. 		in. to	ft.		<u> </u>	<u> </u>	Other			
		O BE USED A										
1. Domestic				r Supply: well ID					d Water Supply: lea			
☐ House				how many wells?					well ID			
. —	& Garden	7. ∐ A	Aquifer Ked	harge: well ID well ID AB	MW-17S				☐ Uncased ☐ God: how many bores?			
☐ Livest 2. ☐ Irrigat				Remediation: wel					Loop Horizontal			
3. Teedlo			Air Sparge	☐ Soil Vap					oop Surface Disc			
4. Indust			Recovery	☐ Injection					specify):			
		riological sami	nle submit	ted to KDHE?		No 1			ple was submitted			
		? 🗌 Yes 📰 N		icu to andica:	103		n yes, aan	o sam	pic was submitted	• • • • • • • • • • • • • • • • • • • •		
				☐ Other	C	A STNO	G IOINTS		Glued	□ Welded	☐ Threaded	
Casing diam	eter 2	in to	i9 π γ τ	Diameter 2	in to	29.5	ft Dian	neter .	in to		· · · · · · · · · · · · · · · · · · ·	
Casing heigh	ht above land	surface -0.	37 in.	Weight		./ft.	Wall thick	cness (in. to or gauge No. Sch.	40		
		R PERFORATI										
☐ Steel	☐ Sta	nless Steel	☐ Fibergl	ass 🔳 PVC			☐ Oth	ner (Sp	pecify)			
☐ Brass		vanized Steel	☐ Concre		e used (oper	hole)						
		ATION OPEN										
	nuous Slot	Mill Slot	∐ Gau	ze Wrapped 📙	Torch Cut	∐ Dri	lled Holes	. I ⊃ C	other (Specify)	• • • • • • • • • • • • • • • • • • • •		
	erea Snuner Dedecid At	ED INTERVAL	a ∐win	Wrapped ☐	Saw Cut		ne (Open H	ioie)	ft., From	A 40	A	
SCREEN-R	DAMEI DA	CV INTERVAL	S. From .	11. 10 29 25 25	11., FI	om	الا مع ه	,	ft., From	II. IU	II.	
A CROUT	RAYEL FA	CK INTERVAL	mont \Box	amont grout	Pontonito	OM	Concr	ete	II., FIOM	11. 10	····· 1L	
Grout Interv	rale: Erom	O A to	1.5 d	From 1.5	A to	15	A From	Ŧ?Ħ	ft. to			
		le contamination		, 1 10th			11., 1 10	• • • • • • •	11. 10	AL.		
☐ Septic			teral Lines	☐ Pit Privy	•	□ Li	ivestock Pe	ns	☐ Insecticid	le Storage		
☐ Sewer I	Lines	Ce	ss Pool	☐ Sewage	Lagoon		uel Storage		☐ Abandon	ed Water V	Vell	
	ight Sewer Li	nes 🗆 See	epage Pit	☐ Feedyard		☐ Fe	ertilizer Sto	rage	☐ Oil Well/	Gas Well		
Other (Specify) .Co	ntaminated. Si	te						•			
										LUCCDIC	DITTONIALO	
10 FROM	TO		THOLOGI	LLUG	FRO	VI	10	LUIH	O. LOG (cont.) or P	TOOPING	INTERVALS	
		Asphalt Grovel and for	and			+-						
		<u>Gravel and f sa</u> Silt and clay	anu	· · · · · · · · · · · · · · · · · · ·								
0.5			<u> </u>									
5		Clay, some silt										
10		Silt, some clay			-	\dashv	 					
		Clay, some silt			Notes	<u>. </u>						
25	29	Silt, some clay			140tg2	•						
11 CONTRACTOR'S OR LANDOWNER'S CERTIFICATION: This water well was constructed, reconstructed, or plugged												
under my jurisdiction and was completed on (mo-day-year) .6/5/20.17 and this record is true to the best of my knowledge and belief.												
Kansas Water Well Contractor's License No. 527 This Water Well Record was completed on (mo-day, year) 6/14/2017												
under the bi	usiness name	of GeoCore	Inc			Signa	ature 🕰	I. Ola	y Mala			
Mail 1	Mail 1 white copy along with a fee of \$5.00 for each constructed well to: Kansas Department of Health and Environment, Bureau of Water, GWTS Section,											
	1000 SW Jackson St., Suite 420, Topeka, Kansas 66612-1367. Mail one to Water Well Owner and retain one for your records. Telephone 785-296-5524.											
Visit us at http	://www.kdheks	.gov/waterwell/inde	ex.html		KSA 82a	1-1212	:			<u>kevised</u>	7/10/2015	

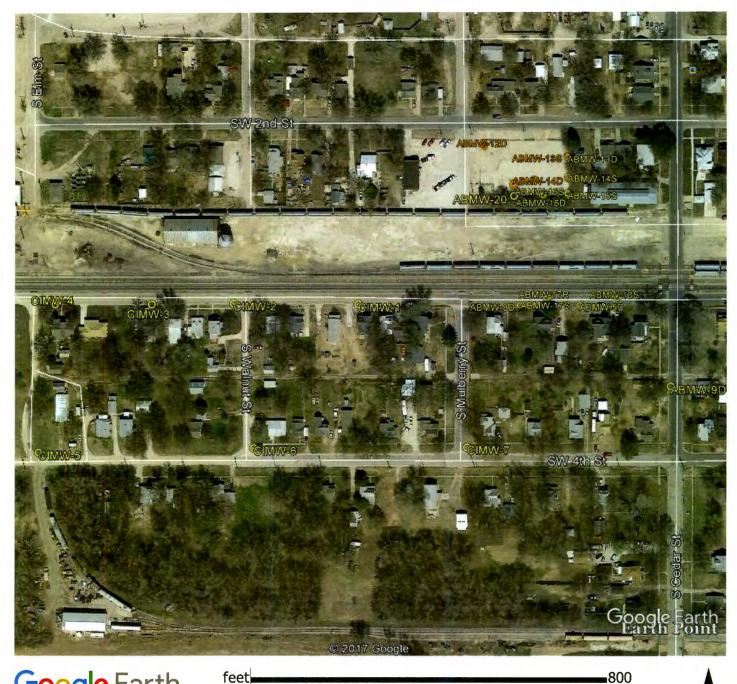

Google Earth

feet meters

200



ONE Gas (for Burns and McDonell) Abilene, Kansas

GPS Coordinates:

ABMW-5D:	38.9131138, -97.2173129	ABMV
ABMW-8D:	38.9131136, -97.2177859	ABMV
ABMW-9D:	38.9126168, -97.2165918	ABMV
ABMW-12D:	38.9140816, -97.2180669	ABMV
ABMW-12S:	38.9140928, -97.2180625	ABMV
ABMW-13D:	38.9140131, -97.2174146	ABMV
ABMW-13S:	38.9140215, -97.2174165	ABMV

W-14D: 38.9138852, -97.2174120 W-14S: 38.9138946, -97.2174112 W-15D: 38.9137872, -97.2174094 W-15S: 38.9137961, -97.2174099 W-16D: 38.9137847, -97.2175987 W-16S: 38.9137858, -97.2176098 W-17D: 38.9131615, -97.2175552

ONE Gas Abilene, Kansas Sheet 2

GPS Coordinates (cont'd):

ABMW-17S: 38.9131598, -97.21	L75651 CIMW	1: 38.9131215, -97.2190620
· · · · · · · · · · · · · · · · · · ·		
ABMW-17R: 38.9131607, -97.23	175770 CIMW	-2: 38.9131258, -97.2200443
ADIVIVE 1711. 30.3131007, -37.2.	LISTIO	2. 30.3131230, 37.2200443
ADMAN 400 20 0424642 07 24	70046	2. 20 0424225 07 2205040
ABMW-18D: 38.9131643, -97.21	.70046 CIMW	3: 38.9131235, -97.2206910
Tanada and an analysis and a		
ABMW-18S: 38.9131589, -97.21	170173 CIMW	4: 38.9131245, -97.2214561
/ DIVIVE 200. 00.0202000, 07.12.	.,01,0	1. 50.0151215, 57.2211501
ADMANA 10. 20 0120752 07 24	7C72E CINAVA	5: 38.9122182, -97.2215866
ABMW-19: 38.9138752, -97.21	L/0/25 CIIVIVV	5: 50.9122182, -97.2215800
ABMW-20: 38.9137790, -97.21	.78331 CIMW	6: 38.9122408, -97.2198854
		•
ABMW-21: 38.9138473, -97.21	78333 CIMM	7: 38.9122432, -97.2181998
ADIVIVE-21. 30.31304/3, -3/.21	CIIVIV	7. 30.3122432, -37.2101330