
			WWC-5			on of Water		Well ID	ABMW-17R
		Correction Change	ge in Well Use Fraction			rces App. No. on Number	Township Number		nge Number
	ty: Dickins		NW 1/4 SW 1/4 NE 1/4		Secia	21	T 13 S		E W
	OWNER:		First:		Rural		ere well is located		
	S: ONE GE		i iist.				rsection): If at owner		
Address	: 15 East	Fifth Street					,		
Address		Server OK	7TD: 74400	~21U VV	OI NV	v comer or	SW 3rd & S Mulb	erry Sis.,	Abliefie
City:	Tulsa	State: OK							
3 LOCA WITH		4 DEPTH OF CON			ft.		38.913160		
	ON BOX:	Depth(s) Groundwater			.	Longitud	le: <u>-9</u> 7,2175	7 <u>70</u>	(decimal degrees)
	N		3) ft., or 4) [ս		l Datum: ☐ WGS 84	NAD NAD	83 🗆 NAD 27
	T	WELL'S STATIC WA	, measured on (mo-day-				Latitude/Longitude:		,
X	NE		, measured on (mo-day- , measured on (mo-day-				unit make/model:		
NW -	NE	Pump test data: Well v					10)		
w	$+-+- _{E}$		s pumping						
637	SE		vater was 1	ft.					
5W	- SE		s pumping	6 Elevation: 1148.66ft. ■ Ground			I evel TTOC		
	S	Estimated Yield: Bore Hole Diameter:	gpm 8.5 in to 53	A and		Source:	Land Survey G	PS TT	prographic Map
h1	mile	Bore Hole Diameter:	in. to	II. AIIU			Other		
		O BE USED AS:							
1. Domestic			ter Supply: well ID			10. ☐ Oil Fie	ld Water Supply: lea	ıse	
House		Dewaterin	g: how many wells?				well ID		
☐ Lawn	& Garden	7. □ Aquifer Re	echarge: well ID			_	☐ Uncased ☐ G		
☐ Livest		8. Monitorin	g: well ID ABMV	<u>y-1/K</u>	•••		al: how many bores?		
2. Irrigat			al Remediation: well II		•••		Loop Horizonta		
3. Feedle		☐ Air Sparge ☐ Recovery	e ☐ Soil Vapor I ☐ Injection	extraction			oop Surface Disespecify):		
4. Indust									
		eriological sample subm	itted to KDHE?	Yes N	io II	yes, date sar	nple was submitted	:	
		? ☐ Yes ■ No			OD IO	TOD ITTO	a		1 = 01 1 1
8 TYPE	JF CASING	G USED: ☐ Steel ■ PV in. to42.5 ft.,	C Other	CA	SUNG 53	JOINTS: L	Glued Clamped	∐ Welded	Threaded
Casing dian	ht above land	surface -0.40 in	Weight	μι. ω lbe /:	 A	. II., Diaineter Wall thickness	or gauge No. Sch.		
		R PERFORATION MAT		105.7	•••	TO ART MAIORILESS	or gauge tro	. 5. 7	
☐ Steel		inless Steel Fiber				Other (S	Specify)		
☐ Brass		Ivanized Steel	rete tile \text{None us}	sed (open h	iole)		• • • • • • • • • • • • • • • • • • • •		
		RATION OPENINGS A							
Conti	nuous Slot						Other (Specify)	•••••	
Louve	ered Shutter	☐ Key Punched ☐ Wi TED INTERVALS: From	re Wrapped ∐ Sav	v Cut L		e (Open Hole)	Α Γ	Δ.	
SCREEN	PEKFUKAI DAVEL DA	CK INTERVALS: From	44.9π. το .94.9 38 A 53	II., FIOI	n	11. to	n., From	II. 10	π.
A CROUT	CMATEDI	AL: Neat cement	Compat growt Por	IL., FIOI	Otho	- Concrete	п., гюш	11. 10	
Grout Interv	ale: From	O fl. to 1.5	# From 1.5	to 3	8 Ome	f From	ft to	A	• • • • • • • • • • • • • • • • • • • •
		ole contamination:	. II., 110III	it. 10		i., 1 ioni	11. 10	11.	
☐ Septic		☐ Lateral Lines	☐ Pit Privy		☐ Liv	estock Pens	☐ Insecticio	le Storage	
☐ Sewer		☐ Cess Pool	☐ Sewage Lag			el Storage	☐ Abandon	ed Water V	Vell
	ight Sewer L				☐ Fer	tilizer Storage	☐ Oil Well	Gas Well	
Other ((Specify) .Co	ontaminated Site	D'						
		LITHOLOG		FROM			HO. LOG (cont.) or F	LIGGING	INTEDVALE
10 FROM 0	0.25	Asphalt	ac LUG	PROM	+-	TO LLIL	IO. LOG (COM.) OF P	LUUUINU	LILLERVALS
0.25		Gravel and f Sand		 	+			<u> </u>	
0.5	10	Clay, some silt			+				
10		Silt, some clay				-	-		
17		Clay, some silt			1				
25		Silt, some clay							
28		Sand, vf-f, and silt		Notes:					
39		Sand, c-vf, tr. silt and g	ravel	1					
				1					
11 CONTRACTOR'S OR LANDOWNER'S CERTIFICATION: This water well was constructed, reconstructed, or plugged									
under my jurisdiction and was completed on (mo-day-year) .6/5/20.17 and this record is true to the best of my knowledge and belief.									
Kansas Water Well Contractor's License No. 527 This Water Well Record was completed on (mo-day-year) .6/14/2017									
under the business name of GeoCore Inc. Mail I white copy along with a fee of \$5.00 for each constructed well to: Kansas Department of Health and Environment, Bureau of Water, GWTS Section,									
	1000 SW Jackson St., Suite 420, Topeka, Kansas 66612-1367. Mail one to Water Well Owner and retain one for your records. Telephone 785-296-5524.								
		s.gov/waterwell/index.html							7/10/2015

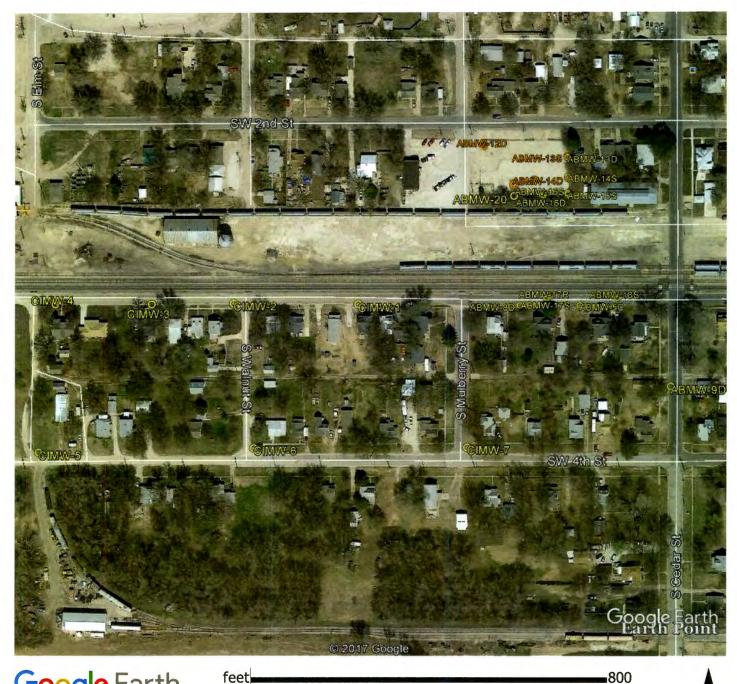

Google Earth

feet meters

200



ONE Gas (for Burns and McDonell) Abilene, Kansas

GPS Coordinates:

ABMW-5D:	38.9131138, -97.2173129	ABMV
ABMW-8D:	38.9131136, -97.2177859	ABMV
ABMW-9D:	38.9126168, -97.2165918	ABMV
ABMW-12D:	38.9140816, -97.2180669	ABMV
ABMW-12S:	38.9140928, -97.2180625	ABMV
ABMW-13D:	38.9140131, -97.2174146	ABMV
ABMW-13S:	38.9140215, -97.2174165	ABMV

W-14D: 38.9138852, -97.2174120 W-14S: 38.9138946, -97.2174112 W-15D: 38.9137872, -97.2174094 W-15S: 38.9137961, -97.2174099 W-16D: 38.9137847, -97.2175987 W-16S: 38.9137858, -97.2176098 W-17D: 38.9131615, -97.2175552

ONE Gas Abilene, Kansas Sheet 2

GPS Coordinates (cont'd):

ABMW-17S:	38.9131598, -97.2175651	CIMW-1:	38.9131215, -97.2190620
ABMW-17R:	38.9131607, -97.2175770	CIMW-2:	38.9131258, -97.2200443
ABMW-18D:	38.9131643, -97.2170046	CIMW-3:	38.9131235, -97.2206910
ABMW-18S:	38.9131589, -97.2170173	CIMW-4:	38.9131245, -97.2214561
ABMW-19:	38.9138752, -97.2176725	CIMW-5:	38.9122182, -97.2215866
ABMW-20:	38.9137790, -97.2178331	CIMW-6:	38.9122408, -97.2198854
ABMW-21:	38.9138473, -97.2178333	CIMW-7:	38.9122432, -97.2181998