
			WWC-5		Division of W			Well ID	CIMW-7	
			ge in Well Use Fraction		Resources App Section Num		Township Numbe		ige Number	
		WATER WELL:	SW 1/4 SW 1/4 NE 1/4		Section Num 21	iber	Township Number		ige Number □ E □ W	
			First:	Street or Rural Address where well is located (if unknown, distance and						
Business: ONE Gas, Inc.			i iist.	direction from nearest town or intersection): If at owner's address, check here:						
Address: 15 East Fifth Street				On NW corner of SW 4th & S Mulberry Sts., Abilene						
Address: City: Tulsa State: OK ZIP: 7				Off NVV Coffiel of SVV 4tif & 5 Mulberry Sts., Abiletie				2		
City:	<u>Tulsa</u>				1					
WITH				OWELL:27.5 ft. 5 Latitude: 38.9122432(c						
	ON BOX:		ncountered: 1)			Longitude:				
	N) ft., or 4) Dry Well TER LEVEL: ft.				■ NAD	83 ⊔ NAD 27	
	T		1 22			ource for Latitude/Longitude: GPS (unit make/model:)				
N.	NE			neasured on (mo-day-yr)			WAAS enabled?			
			water was f				■ Land Survey			
w	1 	· 1	rs pumping	g gpm						
sw	SE		water was f rs pumping				<u>-</u>			
]		Estimated Yield	onm	6 Elevation:			. 1147.86 _{ft.}			
	S	Bore Hole Diameter: .	8.25 in to 27.5	n. to27.5 ft. and Source			e: Land Survey GPS Topographic Map			
1	mile		in. to	ft.			Other			
7 WELL	WATER 1	O BE USED AS:	 							
1. Domestic			ater Supply: well ID				ld Water Supply: lea			
House			ng: how many wells?				well ID			
☐ Lawn	& Garden	/. [Aquiter R	Recharge: well ID ng: well IDCIM	W-7	L		☐ Uncased ☐ Ge al: how many bores?			
2. Irrigat			al Remediation: well ID				Loop Horizontal			
3. Feedle		☐ Air Sparg					.oop ☐ Surface Disc			
4. 🔲 Indust		☐ Recovery					specify):			
Was a che	mical/bact	eriological sample subn	nitted to KDHE?	Yes No	o If yes, da	ite san	nple was submitted			
		l? ☐ Yes ■ No	_		• 1		*			
8 TYPE C	OF CASIN	G USED: 🗌 Steel 🔳 PV	C Other	CAS	SING JOINT	`S: 🗆	Glued Clamped	☐ Welded	Threaded	
Casing diam	neter2.	in to 17 ft	, Diameter2	in. to?	7.5 ft., Dia	meter	in. to	ft.		
Casing heig	ht above land	i surfaceU.D/ ir	n. Weight	lbs./f	t. Wall thi	ckness	or gauge No. SCD	4.0		
1		R PERFORATION MA				41 (C	Specify)			
☐ Steel ☐ Brass		inless Steel	•	sed (open h		miei (s	респу)			
		RATION OPENINGS A		sea (open n	u.c,					
☐ Conti	nuous Slot	■ Mill Slot □ G	auze Wrapped 🔲 Tor	rch Cut 🔲	Drilled Hole	s 🔲 (Other (Specify)			
☐ Louve	ered Shutter	☐ Key Punched ☐ W	ire Wrapped 🔲 Sav	v Cut 🔲	None (Open	Hole)				
SCREEN-I	PERFORA!	TED INTERVALS: From	a17 ft. to .27	ft., Fron	1 ft.	to	ft., From	ft. to .	ft.	
G	RAVEL PA	ACK INTERVALS: From	n13 ft. to2/5	ft., Fron	1 ft.	to	ft., From	ft. to	ft.	
9 GROUI	MATERI	AL: Neat cement 0 ft. to 1.5	Cement grout Ber	ntonite	Other	iieie				
Grout Interv	als: From .	ole contamination:	ft., From 1	t. to	э ft., Fron	n	It. to	n.		
Septic		ле сопсаминации: П Lateral Line	s 🔲 Pit Privy	F	Livestock F	ens	☐ Insecticid	e Storage		
☐ Sewer		☐ Cess Pool	☐ Sewage Lag	_	Fuel Storag				Vell	
☐ Watert	ight Sewer L		☐ Feedyard	[Fertilizer S		Oil Well/	Gas Well		
		ontaminated Site								
		LITHOLOG			ТО		ft. HO. LOG (cont.) or P	LUCCDIC	DITEDVALC	
10 FROM 0	TO 0.25		alt roe	FROM 15	21.25	1		LUGGING	INTERVALS	
0.25	0.25	Asphalt Sand and gravel		21.25	21.5		some clay some clay, tr. gra	vel		
0.5	2.5	Silt, some sand		21.5	25		and clay	101		
	5	Silt, tr. clay		25	27.5		, some silt			
5	6	Silt, some clay			1	<u> </u>	, 001110 0111			
6	10	Silt, tr. clay			1					
10	12.5	Silt		Notes:		-				
12.5 12.75 Silt, tr. clay			1							
12.75 15										
11 CONTRACTOR'S OR LANDOWNER'S CERTIFICATION: This water well was constructed, reconstructed, or plugged										
under my jurisdiction and was completed on (mo-day-year) .6/5/20.17 and this record is true to the best of my knowledge and belief. Kansas Water Well Contractor's License No. 527 This Water Well Record was completed on (mo-day-gear) .6/14/2017										
wansas Wai	ier well Co usiness nan	ntractor's License No? he of GeoCore Inc	ri Inis wat	er well Ka	acoru was co Signature	mpiet	ALL CONTRACTOR	1) 3/13/914!	<i>«</i>	
Mail 1	white copy a	ong with a fee of \$5.00 for each	h constructed well to: Kans	as Departme	nt of Health and	Enviro	nment, Bureau of Water	, GWTS Se	ction,	
1000 SW Jackson St., Suite 420, Topeka, Kansas 66612-1367. Mail one to Water Well Owner and retain one for your records. Telephone 785-296-5524.										
Visit us at http	://www.kdhek	s.gov/waterwell/index.html	<u>k</u>	KSA 82a-1	212			Revised 7	//10/2015	

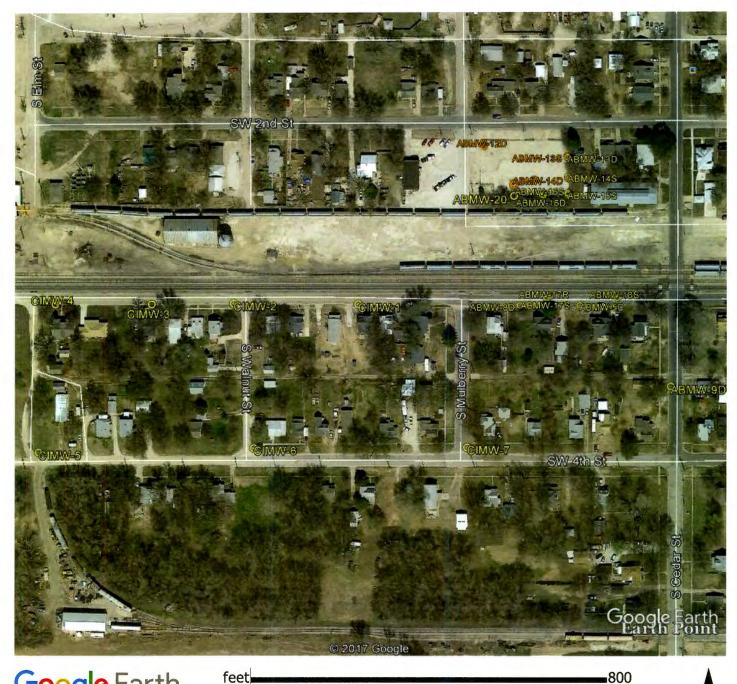

Google Earth

feet meters

200



ONE Gas (for Burns and McDonell) Abilene, Kansas

GPS Coordinates:

ABMW-5D:	38.9131138, -97.2173129	ABMV
ABMW-8D:	38.9131136, -97.2177859	ABMV
ABMW-9D:	38.9126168, -97.2165918	ABMV
ABMW-12D:	38.9140816, -97.2180669	ABMV
ABMW-12S:	38.9140928, -97.2180625	ABMV
ABMW-13D:	38.9140131, -97.2174146	ABMV
ABMW-13S:	38.9140215, -97.2174165	ABMV

W-14D: 38.9138852, -97.2174120 W-14S: 38.9138946, -97.2174112 W-15D: 38.9137872, -97.2174094 W-15S: 38.9137961, -97.2174099 W-16D: 38.9137847, -97.2175987 W-16S: 38.9137858, -97.2176098 W-17D: 38.9131615, -97.2175552

ONE Gas Abilene, Kansas Sheet 2

GPS Coordinates (cont'd):

ABMW-17S:	38.9131598, -97.2175651	CIMW-1:	38.9131215, -97.2190620
ABMW-17R:	38.9131607, -97.2175770	CIMW-2:	38.9131258, -97.2200443
ABMW-18D:	38.9131643, -97.2170046	CIMW-3:	38.9131235, -97.2206910
ABMW-18S:	38.9131589, -97.2170173	CIMW-4:	38.9131245, -97.2214561
ABMW-19:	38.9138752, -97.2176725	CIMW-5:	38.9122182, -97.2215866
ABMW-20:	38.9137790, -97.2178331	CIMW-6:	38.9122408, -97.2198854
ABMW-21:	38.9138473, -97.2178333	CIMW-7:	38.9122432, -97.2181998