
			WWC-5		Division of Wa				CIMW-4
			e in Well Use Resources A			 ^		Well ID	
		WATER WELL:	Fraction		Section Numi 21	ber	Township Numb		ige Number
	ty: Dickins		NE 1/4 SW 1/4 NW 1/4			ala	T 13 S ere well is located		E D W
	OWNER: ONE Ga		First:				rsection): If at owner		
Address		Fifth Street					-		
Address	:			~890' W (of SW come	er of a	SW 3rd & S Mulb	erry Sts.,	Abilene
City:	Tulsa	State: OK	ZIP: 74103						
3 LOCAT		4 DEPTH OF COM	APLETED WELL: .	27,5	. ft. 5 Lati	tude:	38.91312	45	(decimal degrees)
	ON BOX:	Depth(s) Groundwater			Longitude: -97.2214561 (decimal degrees)				
	N		3) ft., or 4) [Horizontal Datum: ☐ WGS 84 ■ NAD 83 ☐ NAD 27				
		WELL'S STATIC WA				Latitude/Longitude:			
X	NE		, measured on (mo-day- , measured on (mo-day-			unit make/model:			
- NM	NE	Pump test data: Well w		,	(WAAS enabled? ☐ Yes ☐ No) ■ Land Survey ☐ Topographic Map				
w	+++	1 ^ 1	s pumping		Online Mapper:				
1 1 '	SE	Well v	ter was ft.						
\$	SE		s pumping	gpm	6 Elev	ation	. 1151.88 _{ft.}	■ Ground	Level TI TOC
	S	Estimated Yield: Bore Hole Diameter:	gpm 8.25 in to 27.5	A and	Sour	ce:	Land Survey	PS To	pographic Man
J1	mile	Bore Hole Diameter	in. to	II. allu A			Other		
		O BE USED AS:							
1. Domestic			ter Supply: well ID		10. 🗆 🤆	il Fie	ld Water Supply: lea	ase	
☐ House	ehold		g: how many wells?		11. Test	Hole	well ID		
1 =	& Garden	7. Aquifer Re	echarge: well ID				☐ Uncased ☐ G		
Livest			g: well ID CIM				al: how many bores		
2. ☐ Irrigat 3. ☐ Feedle		9. Environmenta ☐ Air Sparge	al Remediation: well ID				Loop Horizonta Oop Surface Dis		
3.		☐ Recovery	☐ Son Vapor I	ZALI ACTION	13. 🗆 0)ther (specify):	Charge L	iiij. Oi Water
		eriological sample subm		Vac N					
		eriological sample subm ? 🔲 Yes 🔳 No	med to Midne:	ies Inc	i ii yes, ua	ic san	ipie was submitted	li	
8 TVPE	DE CASINO	LISED: Steel PV	C D Other	CAS	ING IOINT	<u>s. n</u>	Glued Clamped	□ Welded	■ Threaded
Casing diam	neter2	in. to 17 ft	Diameter2	in. to2	7.5 ft Dia	meter	in. to	ft.	Imcaccu
Casing heig	ht above land	G USED: ☐ Steel ■ PV0 in. to	. Weight	lbs./fi	t. Wall thic	kness	or gauge No. Sch.	40	
TYPE OF	SCREEN O	R PERFORATION MAT	TERIAL:						
☐ Steel		inless Steel				her (S	pecify)		
Brass		vanized Steel Concr		sed (open he	ole)				
	DK PEKFOI nuous Slot	RATION OPENINGS AF ■ Mill Slot □ Ga		ash Cut 🖂	Deilled Heles		Other (Creek)		
		☐ Key Punched ☐ Wi	ire Wrapped Say	v Cut □	None (Open 1	и Hole)	Other (Specify)	•••••	•••••
SCREEN-I	PERFORAT	ED INTERVALS: From	17 ft. to .27	ft., From	1 ft. 1	0	ft., From	ft. to .	ft.
		CK INTERVALS: From							
9 GROUT	MATERI	AL: Neat cement	Cement grout Ber	ntonite I	Other Conc	rete			
		0 ft. to 1.5	. ft., From1.5 1	ft. to13	3 ft., From		ft. to	ft.	
		le contamination:	□ Dia Daire	_	7 7 :		□ t	1. 04	
☐ Septic ☐ Sewer		☐ Lateral Lines ☐ Cess Pool	s ☐ Pit Privy ☐ Sewage Lag		☐ Livestock Pe ☐ Fuel Storage		☐ Insectici		17a11
	ight Sewer L				Fertilizer St				7011
Other (Specify) .Co	ontaminated Site				•			
	m well?	······································							
10 FROM	TO	LITHOLOG	SIC LOG	FROM	TO	LITI	HO. LOG (cont.) or I	PLUGGING	INTERVALS
0		Asphalt, gravel, sand			ļ				
0.5		Silt, some clay							
15		Silt, tr. clay							
15.5		Silt, some clay							
16		Silt, tr. clay							
18 20.5		Clay, some silt Silt, some clay		Notes:					
23		Clay and silt		Hotes.					
		Silt and clay, tr. sand							
11 CONT	RACTOR'S	OR LANDOWNER'S	CERTIFICATION:	This wat	er well was [COI	structed, recon	structed, o	r Dlugged
11 CONTRACTOR'S OR LANDOWNER'S CERTIFICATION: This water well was constructed, reconstructed, or plugged under my jurisdiction and was completed on (mo-day-year) .6/5/2017									
Kansas Wa	ter Well Co	ntractor's License No52	27 This Wat	er Well Re	ecord was con	nplet	ed on (mo-day-yea	r) .6/1.4/2!	Q1.7
under the b	usiness nam	e of GeoCore Inc	constructed well to: V	S	ignature	No	M. Kabel	CUTTO C	etion
	Mail 1 white copy along with a fee of \$5.00 for each constructed well to: Kansas Department of Health and Environment, Bureau of Water, GWTS Section, 1000 SW Jackson St., Suite 420, Topeka, Kansas 66612-1367. Mail one to Water Well Owner and retain one for your records. Telephone 785-296-5524.								
		s.gov/waterwell/index.html	I	SA 82a-1	212		, car records. reception	Revised 7	//10/2015

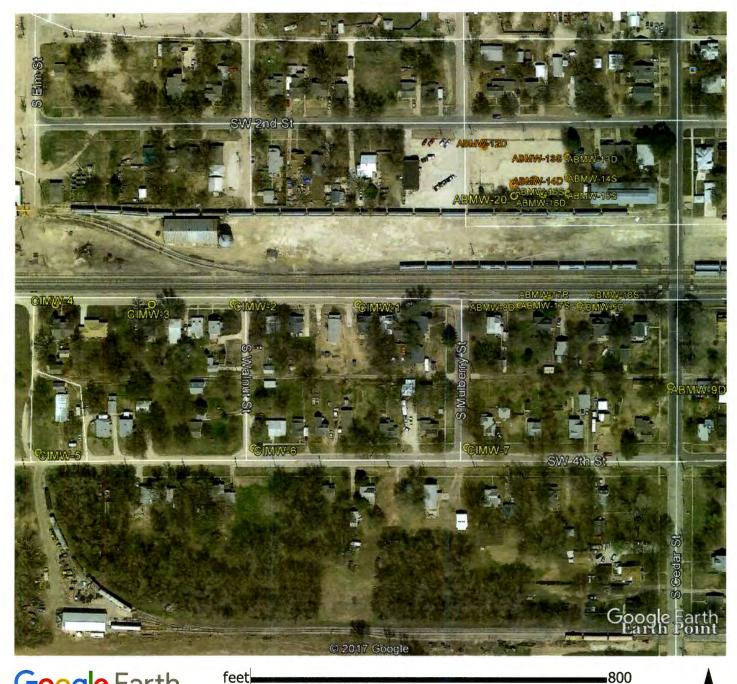

Google Earth

feet meters

200



ONE Gas (for Burns and McDonell) Abilene, Kansas

GPS Coordinates:

ABMW-5D:	38.9131138, -97.2173129	ABMV
ABMW-8D:	38.9131136, -97.2177859	ABMV
ABMW-9D:	38.9126168, -97.2165918	ABMV
ABMW-12D:	38.9140816, -97.2180669	ABMV
ABMW-12S:	38.9140928, -97.2180625	ABMV
ABMW-13D:	38.9140131, -97.2174146	ABMV
ABMW-13S:	38.9140215, -97.2174165	ABMV

W-14D: 38.9138852, -97.2174120 W-14S: 38.9138946, -97.2174112 W-15D: 38.9137872, -97.2174094 W-15S: 38.9137961, -97.2174099 W-16D: 38.9137847, -97.2175987 W-16S: 38.9137858, -97.2176098 W-17D: 38.9131615, -97.2175552

ONE Gas Abilene, Kansas Sheet 2

GPS Coordinates (cont'd):

ABMW-17S:	38.9131598, -97.2175651	CIMW-1:	38.9131215, -97.2190620
ABMW-17R:	38.9131607, -97.2175770	CIMW-2:	38.9131258, -97.2200443
ABMW-18D:	38.9131643, -97.2170046	CIMW-3:	38.9131235, -97.2206910
ABMW-18S:	38.9131589, -97.2170173	CIMW-4:	38.9131245, -97.2214561
ABMW-19:	38.9138752, -97.2176725	CIMW-5:	38.9122182, -97.2215866
ABMW-20:	38.9137790, -97.2178331	CIMW-6:	38.9122408, -97.2198854
ABMW-21:	38.9138473, -97.2178333	CIMW-7:	38.9122432, -97.2181998