
			_	W W U-3			on or water		CIMW-3		
		Correction		e in Well Use			rces App. No		Well ID		
		WATER WELL:	:	Fraction	.,	Section	on Number	Township Number			
	ity: Dickins			NW 1/4 SE 1/4 NW			21	T 13 S	R 2 ■E□W		
	L OWNER			First:				here well is located (
	s: ONE G				direction f	tom nea	erest town or it	tersection): If at owner'	's address, check here: 🔲		
Address		Fifth Street			-670' W	of SV	M comer o	f SW 3rd & S Mulbe	erny Ste Ahilene		
Address		C4-	OK	7D. 74400	0,0 **	0.0.	TV COITICI O	OFF DIG & S INGIDE	ary ota., Abilene		
City:	Tulsa_	Sta	ite. Or	ZIP: 74103			-				
	TE WELL	4 DEPTH O	F COM	IPLETED WELL:	27,5 ft. 5 Latitude: 38.9131235 (decimal degrees)						
	"X" IN										
	SECTION BOX: Depth(s) Groundwater Encountered: 1)				□ Dry We	☐ Dry Well Horizontal Datum: ☐ WGS 84 ■ NAD 83 ☐ NAD 2					
1	WELL'S STATIC WATER LEVEL:					Source for Latitude/Longitude:					
	well S STATIC WATER LEVEL:										
XIII/X					measured on (mo-day-yr)			(WAAS enabled? ☐ Yes ☐ No)			
NW*	NE			ater was ft.			i I on				
				pumping							
" '	1 ' 1			ter was ft.			Ontine iviapper:				
SW	SE	after	hours pumping gpm			j	1100.00				
1 1 1	1 1 1	Estimated Yield	Estimated Yield:gpm					6 Elevation: 1150.90 ft. Ground Level TOC			
1	S	Bore Hole Diar	neter (3.25 in to 27.5	fland	j	Source:	Land Survey 🔲 Gl	PS 🔲 Topographic Mar		
1		2010 11010 2111		in, to	fi			Other			
<u> </u>		O BE USED AS:			**** ***						
1. Domestic				er Supply: well ID			10 🗆 0:15	ield Water Supply: Jee	se		
Domesia				g: how many wells? .				e: well ID			
_	& Garden	7 🗆 🗸	water De	sharaa: wall ID	• • • • • • • • • • • • • • • • • • • •	••••		d □ Uncased □ Ge			
Lives		7. [_] AM.	quiter inc	charge: well ID	лw-3	••••					
				Remediation: well l				mal: how many bores?			
2. ☐ Irrigat 3. ☐ Feedle			omnema r Sparge					d Loop Horizontal			
4. Indust					Extraction b) Open Loop ☐ Surface Discharge ☐ 13. ☐ Other (specify):						
			covery	☐ Injection							
			e submi	tted to KDHE? 🗀	Yes N	lo If	yes, date s	imple was submitted:			
Water well	l disinfecte	i? 🗌 Yes 🔳 No									
8 TYPE C	OF CASIN	G USED: ☐ Steel	■ PVC	☐ Other	CA	SING	JOINTS: [☐ Glued ☐ Clamped	☐ Welded ■ Threaded		
Casing diam	aeter2	in. to17	ft	Diameter 2	in. to	27.5	ft Diamete	r in. to			
Casing heig	ht above lan	d surface0.53	3 in.	Weight	lbs./	ft.	Wall thickne	s or gauge No. Sch. 4	40		
		R PERFORATIO					., .,	Bun-Bu 1101 11111111			
☐ Steel			Fiberg				□ Other	(Specify)			
☐ Brass		-	Concre		used (open l	nole)		(орсону)	***************************************		
		RATION OPENIN			ased (open a	ioicy					
	nuous Siot	Mill Slot			arch Cut. F	7 1711	ad Wales C	Other (Specify)			
			□ Wi	re Wrapped Sa			Compan Holo	Omer (Specify)			
COPENI	DEDEND A'		יייי ו∟ Feorm	17 A 4 27	W Cut _	 T 140116	Copen Hote	, ft., From	0.4-		
SCICEDIA	DANCI DA	CEL HATERANTS	. rrom .		1L., F101		II. 10	n., rrom	n. to n.		
G	KAVELPA	CKINIERVALS	: From	!9 ft. to	? ft., From	<u> </u>	ft. to	ft., From	ft. to ft.		
9 GROUT	' MATERI	AL: Neat ceme	pt □ (Cement grout 📕 Be	entonite	Other	r Concrete	ft. to			
Grout Interv	als: From.	ft. to!.	<u> </u>	ft., FromJ	ft. to	.3 .:	ft., From	ft. to	ft.		
		ole contamination:		_							
☐ Septic		☐ Later		Pit Privy		_	estock Pens	☐ Insecticide			
☐ Sewer I		☐ Cess		☐ Sewage La	~		1 Storage		ed Water Well		
	ight Sewer L			☐ Feedyard		☐ Fert	tilizer Storag	e ☐ Oil Well/0	Gas Well		
■ Other (Specify) .Contaminated .Site											
10 FROM	TO	LITH	OLOGI	CLOG	FROM		TO LIT	THO. LOG (cont.) or PI	LUGGING INTERVALS		
0	0.5	Asphalt, gravel,	sand			<u> </u>	_				
0.5	3	Silt, some clay									
	7.5	Clay, some silt						-			
7.5	12.5	Silt, some clay					***				
12.5_	18	Silt, tr. clay		-	1	+					
18	19.5	Clay, some silt			+	+					
					Notes						
	22	Silt, some clay			Notes:						
	24.5	Clay, some silt			4						
24.5 27.5 Silt, some clay											
11 CONTRACTOR'S OR LANDOWNER'S CERTIFICATION: This water well was constructed, reconstructed, or plugged											
under my jurisdiction and was completed on (mo-day-year) .6/5/2017 and this record is true to the best of my knowledge and belief.											
Kansas Water Well Contractor's License No. 527. This Water Well Record was completed on my Gay-year) 6/14/2017. under the business name of GeoCore Inc. Signature											
under the bu	isiness nam	e of Geogore In	<u>c</u>		<u></u>	Signati	ure XX	r juli			
Mail 1	white copy al	ong with a fee of \$5.00	for each c	onstructed well to: Kan	sas Departme	nt of He	ealth and Envi	ronment, Bureau of Water,	, GWTS Section,		
	1000 SW Jackson St., Suite 420, Topeka, Kansas 66612-1367. Mail one to Water Well Owner and retain one for your records. Telephone 785-296-5524.										
Visit us at http:	://www.kdhek	s.gov/waterwell/index.l	ntml		KSA 82a-1	1212			Revised 7/10/2015		

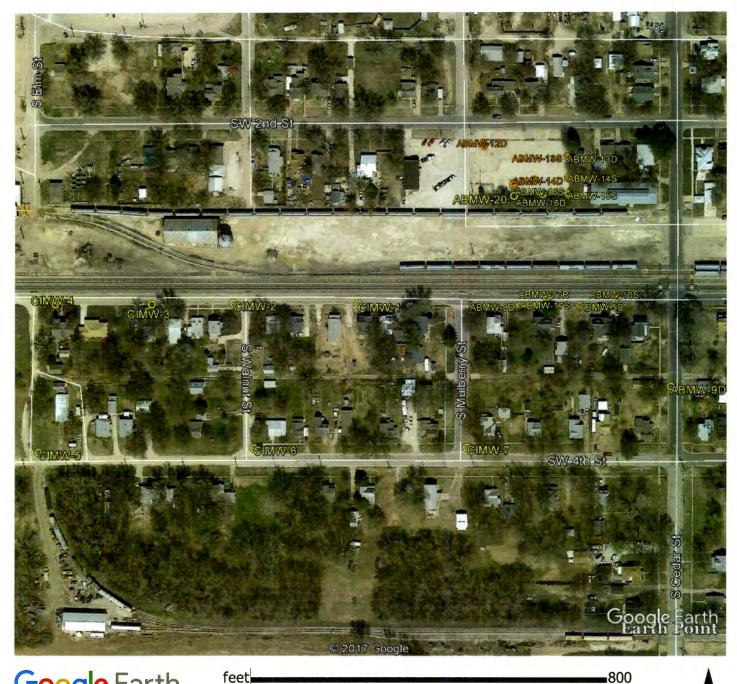

Google Earth

feet meters

200



ONE Gas (for Burns and McDonell) Abilene, Kansas

GPS Coordinates:

ABMW-5D:	38.9131138, -97.2173129	ABMV
ABMW-8D:	38.9131136, -97.2177859	ABMV
ABMW-9D:	38.9126168, -97.2165918	ABMV
ABMW-12D:	38.9140816, -97.2180669	ABMV
ABMW-12S:	38.9140928, -97.2180625	ABMV
ABMW-13D:	38.9140131, -97.2174146	ABMV
ABMW-13S:	38.9140215, -97.2174165	ABMV

W-14D: 38.9138852, -97.2174120 W-14S: 38.9138946, -97.2174112 W-15D: 38.9137872, -97.2174094 W-15S: 38.9137961, -97.2174099 W-16D: 38.9137847, -97.2175987 W-16S: 38.9137858, -97.2176098 W-17D: 38.9131615, -97.2175552

ONE Gas Abilene, Kansas Sheet 2

GPS Coordinates (cont'd):

ABMW-17S:	38.9131598, -97.2175651	CIMW-1:	38.9131215, -97.2190620
ABMW-17R:	38.9131607, -97.2175770	CIMW-2:	38.9131258, -97.2200443
ABMW-18D:	38.9131643, -97.2170046	CIMW-3:	38.9131235, -97.2206910
ABMW-18S:	38.9131589, -97.2170173	CIMW-4:	38.9131245, -97.2214561
ABMW-19:	38.9138752, -97.2176725	CIMW-5:	38.9122182, -97.2215866
ABMW-20:	38.9137790, -97.2178331	CIMW-6:	38.9122408, -97.2198854
ABMW-21:	38.9138473, -97.2178333	CIMW-7:	38.9122432, -97.2181998