
			WWC-5		Division (CIMW-6
			ge in Well Use			App. No.		Well ID	
		WATER WELL:	Fraction	1	Section 1		Township Num		nge Number
	ty: Dickins		SW 1/4 SE 1/4 NW 1/4			21	T 13 S		² ■E□W
	LOWNER		First:				ere well is located		
Address	s: ONE G	as, inc. Fifth Street					rsection): If at owner	-	
Address		Filli Sucet		~447' W	of NW o	comer of	SW 4th & S Mul	berry Sts.,	Abilene
City:	Tulsa	State: OK	ZIP: 74103						
3 LOCA	TE WELL	4 DEPTH OF COM	APLETED WELL: .	27.5	A 5	T -4*4	38 9122	108	
	"X" IN		Encountered: 1)						
SECTI	ON BOX:		3) ft., or 4) [Datum: WGS 8		
	N		TER LEVEL:					65 LI NAU 21	
		☐ below land surface	, measured on (mo-day-	yr)	GPS (unit make/model:)				
- X w-	NE		, measured on (mo-day-		(WAAS enabled? Yes No)				
111			ter was ft.			■ Land Survey □ Topographic Map			
W	 	- 1	pumping gpm rater was ft.			Online Mapper:			
sw-	SE								
111		Estimated Yield:	gpm 6 Ele		Elevation	evation: 1148.95 ft. Ground Level 🗆 TOC			
	S	Bore Hole Diameter:	8.25 in to 27.5	ft. and	- 1	Source:	Land Survey	GPS 🔲 To	pographic Map
1	mile		in. to	ft.			Other		
7 WELL	WATER 7	O BE USED AS:							
1. Domestic	c:		ter Supply: well ID			. 🔲 Oil Fie	ld Water Supply: le	ease	
☐ House		6. Dewaterin	g: how many wells?		11		well ID		
_	& Garden	7. Aquifer R	echarge: well ID	۱۸/ ₋ 6			☐ Uncased ☐		
Lives			g: well IDCIM				al: how many bores		
2. ☐ Irriga 3. ☐ Feedl		9. Environmenta ☐ Air Sparge	al Remediation: well ID e ☐ Soil Vapor F		•••		Loop Horizont .oop Surface Di		
4. ☐ Indus		☐ Recovery		EXHACTION	13		specify):		
		eriological sample subm	utted to KUHE?	Yes 🔳 N	o If ye	s, date san	ipie was submitte	:a:	
water wel	l disinfected	1? ☐ Yes ■ No	0.001	<u> </u>	0010.70	TA TOPO .	GI 1 5 GI		· · ·
S I YPE	Ur CASUN	G USED: ☐ Steel ■ PV in. to	Diameter	CA	SING JU 27.5 A	MN12: □	Glued Clamped	ı 🔲 welded	Inreaded
Casing their	tht above lan	10. to	Weight	m. w	:/.:∺ 11., B Wai	, Diameter II thickness	organge No Sch	. 40	
TYPE OF	SCREEN (R PERFORATION MAT	TERIAL:	103./ 1	. 174	ii uickiics	or gauge 110	·	
☐ Steel		ainless Steel Fiber				☐ Other (S	pecify)		
☐ Brass		Ivanized Steel		sed (open h		_			
SCREEN	OR PERFO	RATION OPENINGS AI		• •	·				
	nuous Slot						Other (Specify)		
Louve	ered Shutter	☐ Key Punched ☐ W	ire Wrapped	v Cut	None (C)pen Hole)			
SCREEN-	PERFORA'	TED INTERVALS: From		ft., Fron	n	ft. to	ft., From	ft. to	ft.
		ACK INTERVALS: From							
9 GROUT	9 GROUT MATERIAL: ☐ Neat cement ☐ Cement grout ☐ Bentonite ☐ Other Concrete Grout Intervals: From								
			. ft., From f	t. toJ.	.3 ft.,	From	ft. to	ft.	
Nearest sou		ole contamination: ☐ Lateral Lines	s 🔲 Pit Privy	1	☐ Livesto	a als Dana	□ Imposti	ide Storage	
☐ Septic		☐ Cess Pool	Sewage Lag		☐ Livesio			nde Storage oned Water V	Wall
_	ight Sewer L		☐ Sewage Lag			zer Storage	_	ll/Gas Well	VC11
Other	(Specify) .C	ontaminated Site							
Direction fro	om well?		Distance from we	11?					
10 FROM	TO	LITHOLOG	IC LOG	FROM	TC	LITH	IO. LOG (cont.) or	PLUGGING	INTERVALS
0	0.5	Gravel, sand, and silt		15.5	17.5		some clay		
0.5	1.5	Silt, some clay		17.5	20	Clay	and silt		
1.5	5	Silt, tr. clay		20	20.5		some clay		
5	5.5	Silt, some clay		20.5	22.5	Silt a	ind clay		
5.5	7.5	Silt, tr. clay		22.5	27.5	Clay	, some silt, tr. sa	and	
7.5	12.5	Silt			<u></u>				
12.5	13	Silt, tr. clay		Notes:					
13	14	Silt, some clay							
14									
11 CONTRACTOR'S OR LANDOWNER'S CERTIFICATION: This water well was constructed, reconstructed, or plugged									
under my jurisdiction and was completed on (mo-day-year) .6/5/20.17 and this record is true to the best of my knowledge and belief. Kansas Water Well Contractor's License No. 527 This Water Well Record was completed on (mo-day-year) .6/14/2017									
under the business name of GeoCore Inc.									
Mail	Mail 1 white copy along with a fee of \$5.00 for each constructed well to: Kansas Department of Health and Environment, Bureau of Water, GWTS Section,								
	1000 SW Jackson St., Suite 420, Topeka, Kansas 66612-1367. Mail one to Water Well Owner and retain one for your records. Telephone 785-296-5524.								
		s.gov/waterwell/index.html				_		Revised 7	

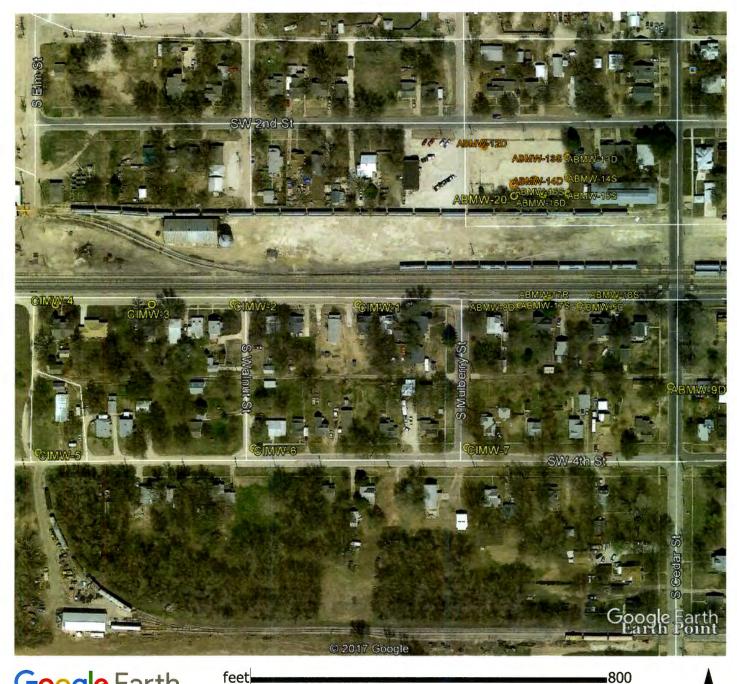

Google Earth

feet meters

200



ONE Gas (for Burns and McDonell) Abilene, Kansas

GPS Coordinates:

ABMW-5D:	38.9131138, -97.2173129	ABMV
ABMW-8D:	38.9131136, -97.2177859	ABMV
ABMW-9D:	38.9126168, -97.2165918	ABMV
ABMW-12D:	38.9140816, -97.2180669	ABMV
ABMW-12S:	38.9140928, -97.2180625	ABMV
ABMW-13D:	38.9140131, -97.2174146	ABMV
ABMW-13S:	38.9140215, -97.2174165	ABMV

W-14D: 38.9138852, -97.2174120 W-14S: 38.9138946, -97.2174112 W-15D: 38.9137872, -97.2174094 W-15S: 38.9137961, -97.2174099 W-16D: 38.9137847, -97.2175987 W-16S: 38.9137858, -97.2176098 W-17D: 38.9131615, -97.2175552

ONE Gas Abilene, Kansas Sheet 2

GPS Coordinates (cont'd):

ABMW-17S:	38.9131598, -97.2175651	CIMW-1:	38.9131215, -97.2190620
ABMW-17R:	38.9131607, -97.2175770	CIMW-2:	38.9131258, -97.2200443
ABMW-18D:	38.9131643, -97.2170046	CIMW-3:	38.9131235, -97.2206910
ABMW-18S:	38.9131589, -97.2170173	CIMW-4:	38.9131245, -97.2214561
ABMW-19:	38.9138752, -97.2176725	CIMW-5:	38.9122182, -97.2215866
ABMW-20:	38.9137790, -97.2178331	CIMW-6:	38.9122408, -97.2198854
ABMW-21:	38.9138473, -97.2178333	CIMW-7:	38.9122432, -97.2181998