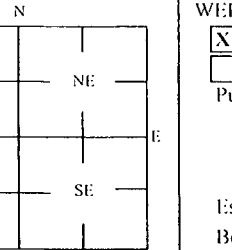


☒ Original Record ☐ Correction ☐ Change in Well Use

1 LOCATION OF WATER WELL: County Douglas		Fraction NE ¼ NW ¼ SE ¼ SW ¼ Section Number 6 Township Number T 13 S Range Number R 20 E 1 W																																																							
2 WELL OWNER: Last Name: Business: KDHE (Continental Oil Co.) Address: 1000 SW Jackson City Topeka State: KS ZIP: 66612		First: _____ Street or Rural Address where well is located (if unknown, distance and direction from nearest town or intersection): If at owner's address, check here: <input type="checkbox"/> 1906 Massachusetts St, Lawrence, KS																																																							
3 LOCATE WELL WITH "X" IN SECTION BOX: 		4 DEPTH OF COMPLETED WELL: 20 ft Depth(s) Groundwater Encountered: 1) _____ ft 2) _____ ft 3) _____ ft or 4) <input type="checkbox"/> Dry Well WELL'S STATIC WATER LEVEL: 3.06 ft. <input checked="" type="checkbox"/> below land surface, measured on (mo-day-yr) 5/5/20 <input type="checkbox"/> above land surface, measured on (mo-day-yr) _____ Pump test data: Well water was _____ ft after _____ hours pumping _____ gpm Water well was _____ ft after _____ hours pumping _____ gpm Estimated Yield: _____ gpm Bore Hole Diameter: 7.25 in to _____ ft, and _____ in to _____ ft																																																							
		5 Latitude: 38.94978 (decimal degrees) Longitude: 95.23570 (decimal degrees) Horizontal Datum: <input checked="" type="checkbox"/> WGS 84 <input type="checkbox"/> NAD 83 <input type="checkbox"/> NAD 27 Source for Latitude/Longitude: <input type="checkbox"/> GPS (unit make/model: _____) (WAAS enabled? <input type="checkbox"/> Yes <input checked="" type="checkbox"/> No) <input checked="" type="checkbox"/> Land Survey <input type="checkbox"/> Topographic Map <input type="checkbox"/> Online Mapper																																																							
		6 Elevation: 868.04 ft <input type="checkbox"/> Ground Level <input checked="" type="checkbox"/> TOC Source <input checked="" type="checkbox"/> Land Survey <input type="checkbox"/> GPS <input type="checkbox"/> Topographic Map <input type="checkbox"/> Other _____																																																							
7 WELL WATER TO BE USED AS: 1 Domestic: <input type="checkbox"/> Household <input type="checkbox"/> Lawn & Garden <input type="checkbox"/> Livestock 2 Irrigation <input type="checkbox"/> Feedlot <input type="checkbox"/> Industrial 5 Public Water Supply: well ID _____ 6 Dewatering: how many wells? _____ 7 Aquifer Recharge: well ID _____ 8 <input checked="" type="checkbox"/> Monitoring: well ID MW11 9 Environmental Remediation: well ID _____ <input type="checkbox"/> Air Sparge <input type="checkbox"/> Soil Vapor Extractor <input type="checkbox"/> Recovery <input type="checkbox"/> Injection 10 Oil Field Water Supply: lease _____ 11 Test Hole: well ID _____ <input type="checkbox"/> Cased <input type="checkbox"/> Uncased <input type="checkbox"/> Geotechnical 12 Geothermal: How many bores? a) Closed Loop <input type="checkbox"/> Horizontal <input type="checkbox"/> Vertical b) Open Loop <input type="checkbox"/> Surface Discharge <input type="checkbox"/> Inj. of Water <input type="checkbox"/> Other (specify): _____																																																									
Was a chemical/bacteriological sample submitted to KDHE? <input type="checkbox"/> Yes <input checked="" type="checkbox"/> No If yes, date sample was submitted: _____ Water well disinfected? <input type="checkbox"/> Yes <input checked="" type="checkbox"/> No																																																									
8 TYPE OF CASING USED: <input type="checkbox"/> Steel <input checked="" type="checkbox"/> PVC <input type="checkbox"/> Other _____ CASING JOINTS: <input type="checkbox"/> Glued <input type="checkbox"/> Clamped <input type="checkbox"/> Welded <input checked="" type="checkbox"/> Threaded Casing diameter 2 in. to 10 ft, Diameter _____ in. to _____ ft, Diameter _____ in. to _____ ft, Casing height above land surface -0.39 in. Weight _____ lbs./ft. Well thickness or gauge No _____ TYPE OF SCREEN OR PERFORATION MATERIAL: <input type="checkbox"/> Steel <input type="checkbox"/> Stainless Steel <input type="checkbox"/> Fiberglass <input checked="" type="checkbox"/> PVC <input type="checkbox"/> Other (Specify) _____ <input type="checkbox"/> Brass <input type="checkbox"/> Galvanized Steel <input type="checkbox"/> Concrete tile <input type="checkbox"/> None used (open hole) SCREEN OR PERFORATION OPENINGS ARE: <input type="checkbox"/> Continuous Slot <input checked="" type="checkbox"/> Mill Slot <input type="checkbox"/> Gauze Wrapped <input type="checkbox"/> Torch Cut <input type="checkbox"/> Drilled Holes <input type="checkbox"/> Other (Specify) _____ <input type="checkbox"/> Louvered Shutter <input type="checkbox"/> Key Punched <input type="checkbox"/> Wire Wrapped <input type="checkbox"/> Saw Cut <input type="checkbox"/> None (Open Hole) SCREEN-PERFORATED INTERVALS: From 10 ft. to 20 ft, From _____ ft. to _____ ft, From _____ ft. to _____ ft, GRAVEL PACK INTERVALS: From 8 ft. to 20 ft, From _____ ft. to _____ ft, From _____ ft. to _____ ft,																																																									
9 GROUT MATERIAL: <input type="checkbox"/> Neat cement <input type="checkbox"/> Cement grout <input checked="" type="checkbox"/> Bentonite <input checked="" type="checkbox"/> Other Concrete: 0-0.5' Grout intervals: From 0.5 ft. to 8 ft, From _____ ft. to _____ ft, From _____ ft. to _____ ft, Nearest source of possible contamination: <input type="checkbox"/> Septic Tank <input type="checkbox"/> Lateral Lines <input type="checkbox"/> Pit Privy <input type="checkbox"/> Livestock Pens <input type="checkbox"/> Insecticide Storage <input type="checkbox"/> Sewer Lines <input type="checkbox"/> Cess Pool <input type="checkbox"/> Sewage Lagoon <input checked="" type="checkbox"/> Fuel Storage <input type="checkbox"/> Abandoned Water Well <input type="checkbox"/> Watertight Sewer Lines <input type="checkbox"/> Seepage Pit <input type="checkbox"/> Feedyard <input type="checkbox"/> Fertilizer Storage <input type="checkbox"/> Oil Well / Gas Well <input type="checkbox"/> Other (Specify) _____ Direction from well? ~200 ft Distance from well? N _____ ft																																																									
<table border="1" style="width: 100%;"> <thead> <tr> <th>FROM</th> <th>TO</th> <th>LITHOLOGIC LOG</th> </tr> </thead> <tbody> <tr><td>0</td><td>0.3</td><td>Concrete</td></tr> <tr><td>0.3</td><td>1</td><td>Gravel</td></tr> <tr><td>1</td><td>3</td><td>Silty clay, some gravel</td></tr> <tr><td>3</td><td>20</td><td>Silty clay</td></tr> <tr><td> </td><td> </td><td> </td></tr> <tr><td> </td><td> </td><td> </td></tr> <tr><td> </td><td> </td><td> </td></tr> <tr><td> </td><td> </td><td> </td></tr> </tbody> </table>		FROM	TO	LITHOLOGIC LOG	0	0.3	Concrete	0.3	1	Gravel	1	3	Silty clay, some gravel	3	20	Silty clay													<table border="1" style="width: 100%;"> <thead> <tr> <th>FROM</th> <th>TO</th> <th>LITHO. LOG (cont.) or PLUGGING INTERVALS</th> </tr> </thead> <tbody> <tr><td> </td><td> </td><td> </td></tr> <tr><td> </td><td> </td><td> </td></tr> <tr><td> </td><td> </td><td> </td></tr> <tr><td> </td><td> </td><td> </td></tr> <tr><td> </td><td> </td><td> </td></tr> <tr><td> </td><td> </td><td> </td></tr> <tr><td> </td><td> </td><td> </td></tr> <tr><td> </td><td> </td><td> </td></tr> </tbody> </table>		FROM	TO	LITHO. LOG (cont.) or PLUGGING INTERVALS																								
FROM	TO	LITHOLOGIC LOG																																																							
0	0.3	Concrete																																																							
0.3	1	Gravel																																																							
1	3	Silty clay, some gravel																																																							
3	20	Silty clay																																																							
FROM	TO	LITHO. LOG (cont.) or PLUGGING INTERVALS																																																							
Notes: KDHE ID: Continental Oil Co.; U4-023-15188 Target of monitoring well is shallow groundwater, <20' of grout was installed at the direction of KDHE.																																																									
11 CONTRACTOR'S OR LANDOWNER'S CERTIFICATION: This water well was <input checked="" type="checkbox"/> constructed, <input type="checkbox"/> reconstructed, or <input type="checkbox"/> plugged under my jurisdiction and was completed on (mo-day-year) 4/21/20 and this record is true to the best of my knowledge and belief. Kansas Water Well Contractor's License No 757 This Water Well Record was completed on (mo-day-year) 6/2/20 under the business name of Larsen & Associates, Inc. Signature _____																																																									
Mail 1 white copy along with a fee of \$5.00 for each constructed well to: Kansas Department of Health and Environment, Bureau of Water Control Section 1000 SW Jackson St., Suite 420, Topeka, Kansas 66612-1367. Mail one to Water Well Owner and retain one for your records. Telephone 785-796-5524. Visit us at http://www.kdheks.gov/waterwell/index.html KSA 82a-1212 Revised 7/10/2015																																																									

NOTE: Figures exhibited within this report are only to be used within the context of this report. Placement of property lines, wells, structures, and roads is based on the available information from county appraiser maps, surveys, site visits, and/or previous vendor reports and should be considered approximate.

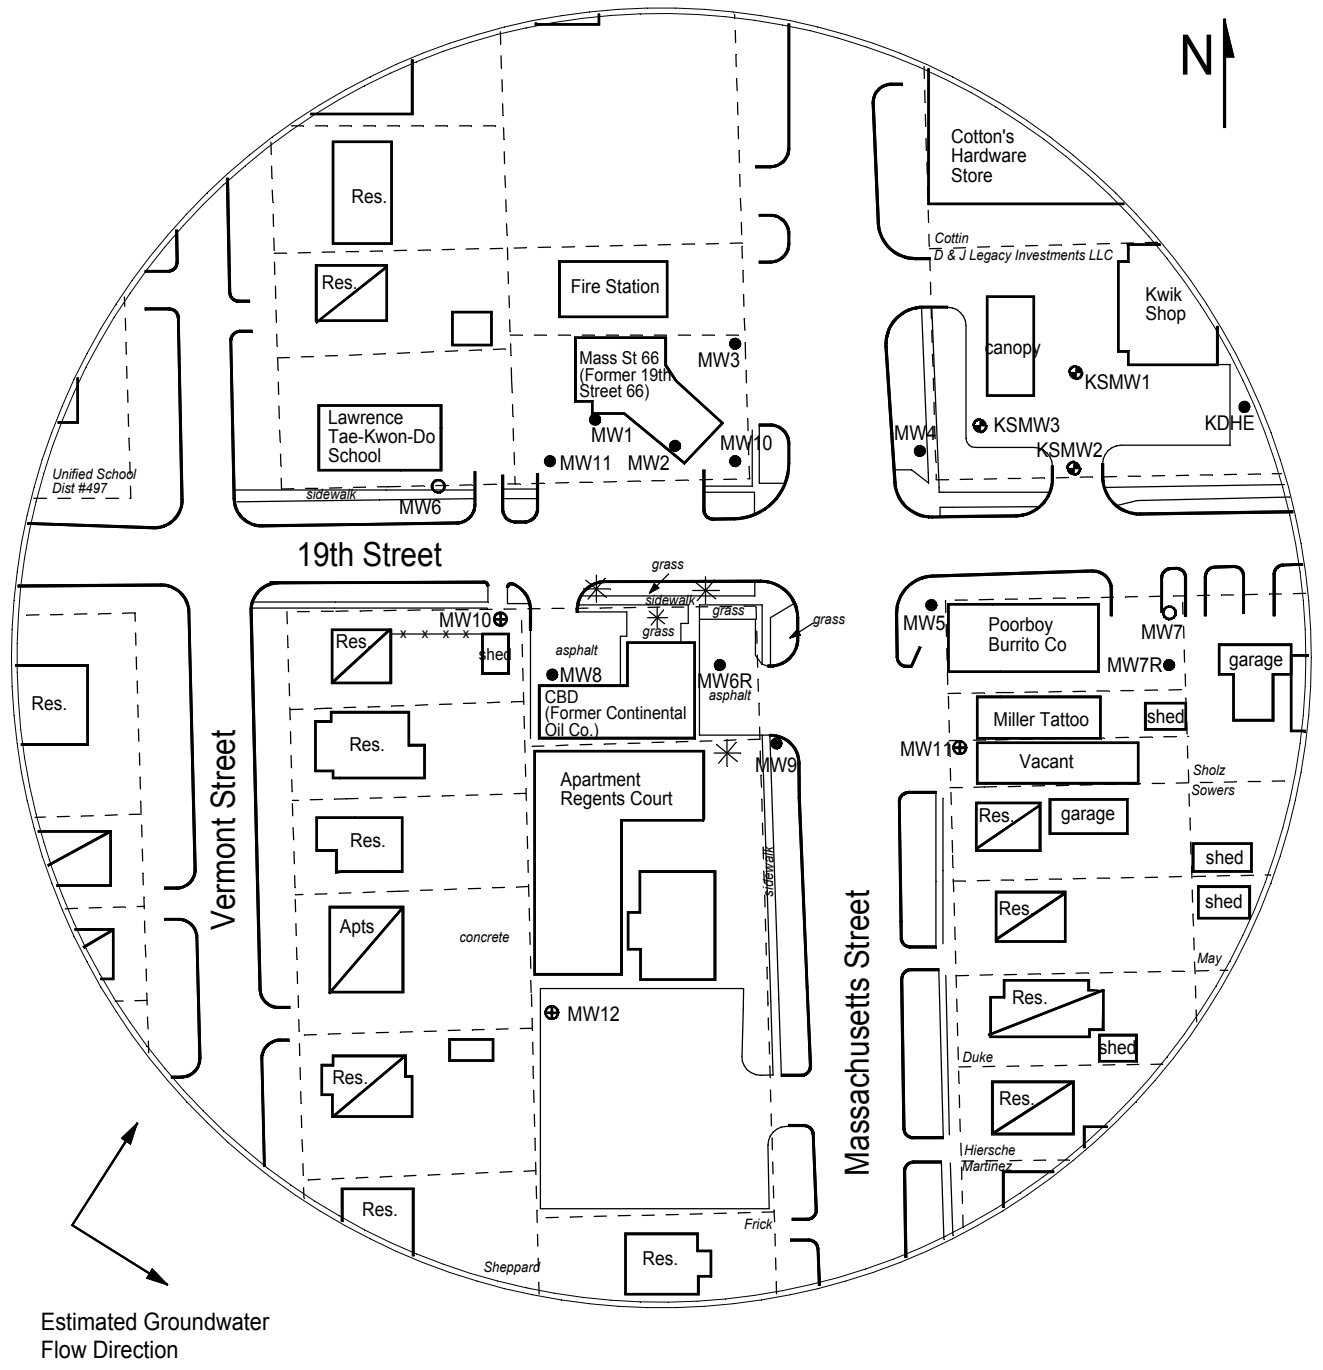


FIGURE 2.1 - 350 FT RADIUS AREA BASE MAP



1311 E 25th St. Suite B 785-841-8707 office
Lawrence, KS 66046 785-865-4282 fax

PROJECT:

Continental Oil Co.
1901 Massachusetts
Lawrence, KS
KDHE ID: U4-023-15188
Date: 5/5/20

0 100 ft

LEGEND:

- Approximate Location of Former UST Basin, Product Lines & Pump Islands
- Approximate Location of Active UST Basin & Pump Islands
- Building with Basement
- Approximate Location of Property Line
- Monitoring Well from nearby site 19th Street 66 (U4-023-01681)
- Monitoring Well from nearby site Kwik Shop #702 (U4-023-11798)
- Plugged Well
- Monitoring Well (Installed 4/20-21/20)
- Soil Boring (Drilled 4/20/20)
- Fire Hydrant
- Electric Lines (1.5 - 3 ft bgs)
- Gas Lines (1.5 - 3 ft bgs)
- Sewer Lines (2 - 6 ft bgs)
- Overhead Lines (25'-40' high)
- Telephone Lines (2 - 6 ft bgs)
- Water Lines (1.5 - 3 ft bgs)

NOTE: SB5 & SB6 were drilled to collect hydrologic samples.
NOTE: Utility depths, heights and locations are approximate.

Douglas

6 - T13 - R20E

DENNIS L HANDKE

1820 NW 59th Terrace
TOPEKA, KANSAS 66618
785-286-4047 Home

Jess Chapman
Larsen & Assoc.
1311 E. 25th St., Suite B
Topeka, Kansas 66046

May 1, 2020

RE: Monitor Well Elevation Survey
1901 Massachusetta, Lawrence, Kansas

Proj. 20-00T
Continental Oil Co.
KDHE ID U4-023-15188

Bench Mark: Chisled square on Southwest corner of signal light base the SW corner of property.
Elev.: 869.52 North 2687.27 West 3611.87 (from SE Cor. Sec. 6-13-20E)

MW-10	rim	870.36	North	2676.61	NE1/4,NW1/4,NE1/4,SW1/4
	top pipe	870.00	West	3729.63	Lat = 38.94998 Long = 95.23656
MW-11	rim	868.43	North	2602.55	NE1/4,NW1/4,NE1/4,SW1/4
	top pipe	868.04	West	3485.08	Lat = 38.94978 Long = 95.23570
MW-12	rim	870.50	South	2459.84	NE1/4,NW1/4,NE1/4,SW1/4
	top pipe	870.11	West	3711.40	Lat = 38.94938 Long = 95.23650

Lat & Long derived from Lawrence East 7.5' quad map. WGS84.

Elevation derived from existing project. NAVD 88.

If you have any questions, please feel free to call me. Thank you for the opportunity to be of service to you.

Dennis L Handke RLS

