

WATER WELL RECORD Form WWC-5

Division of Water Resources App. No.

Well ID 057MW008

Original Record Correction Change in Well Use

| | | | | |
|---|------------------------------|---------------------|---------------------------|---|
| 1 LOCATION OF WATER WELL: County: Johnson | Fraction ¼ SE ¼ SE ¼ NW ¼ | Section Number 7 | Township Number T 13 S | Range Number R 22 <input checked="" type="checkbox"/> E <input type="checkbox"/> W |
|---|------------------------------|---------------------|---------------------------|---|

| | |
|--|--|
| 2 WELL OWNER: Last Name: <u> </u> First: <u> </u> Business: Sunflower Army Ammunition Plant Address: <u> </u> Address: 35425 W. 103rd Street City: DeSoto State: KS ZIP: 66018 | Street or Rural Address where well is located (if unknown, distance and direction from nearest town or intersection): If at owner's address, check here: <input checked="" type="checkbox"/> |
|--|--|

3 LOCATE WELL WITH "X" IN SECTION BOX:
N

| | |
|----|----|
| NW | NE |
| SW | SE |

S

|-----1 mile-----|

4 DEPTH OF COMPLETED WELL: 23.0 ft.
 Depth(s) Groundwater Encountered: 1) 21 ft.
 2) ...N/A... ft. 3) ...N/A... ft., or 4) Dry Well
WELL'S STATIC WATER LEVEL: 21.37 ft.
 below land surface, measured on (mo-day-yr) 7-12-2021
 above land surface, measured on (mo-day-yr)
 Pump test data: Well water was N/A ft.
 after N/A hours pumping N/A gpm
 Well water was N/A ft.
 after N/A hours pumping N/A gpm
 Estimated Yield: N/A gpm
 Bore Hole Diameter: 8.25 in. to 23.0 ft. and
 in. to ft.

5 Latitude: 38.93653 (decimal degrees)
Longitude: 95.01108 (decimal degrees)
Horizontal Datum: WGS 84 NAD 83 NAD 27
Source for Latitude/Longitude:
 GPS (unit make/model:)
 (WAAS enabled? Yes No)
 Land Survey Topographic Map
 Online Mapper: KGS Mapper/Google Earth

6 Elevation: 946 ft. Ground Level TOC
Source: Land Survey GPS Topographic Map
 Other Google Earth

7 WELL WATER TO BE USED AS:

| | | |
|---|---|---|
| 1. Domestic: <input type="checkbox"/> Household <input type="checkbox"/> Lawn & Garden <input type="checkbox"/> Livestock 2. <input type="checkbox"/> Irrigation 3. <input type="checkbox"/> Feedlot 4. <input type="checkbox"/> Industrial | 5. <input type="checkbox"/> Public Water Supply: well ID 6. <input type="checkbox"/> Dewatering: how many wells? 7. <input type="checkbox"/> Aquifer Recharge: well ID 8. <input checked="" type="checkbox"/> Monitoring: well ID <u>057MW008</u> 9. Environmental Remediation: well ID <input type="checkbox"/> Air Sparge <input type="checkbox"/> Soil Vapor Extraction <input type="checkbox"/> Recovery <input type="checkbox"/> Injection | 10. <input type="checkbox"/> Oil Field Water Supply: lease 11. Test Hole: well ID <input type="checkbox"/> Cased <input type="checkbox"/> Uncased <input type="checkbox"/> Geotechnical 12. Geothermal: how many bores? a) Closed Loop <input type="checkbox"/> Horizontal <input type="checkbox"/> Vertical b) Open Loop <input type="checkbox"/> Surface Discharge <input type="checkbox"/> Inj. of Water 13. <input type="checkbox"/> Other (specify): |
|---|---|---|

Was a chemical/bacteriological sample submitted to KDHE? Yes No If yes, date sample was submitted:
 Water well disinfected? Yes No

8 TYPE OF CASING USED: Steel PVC Other **CASING JOINTS:** Glued Clamped Welded Threaded
 Casing diameter 2 in. to 13 ft., Diameter N/A in. to N/A ft., Diameter N/A in. to N/A ft.
 Casing height above land surface 30 in. Weight N/A lbs./ft. Wall thickness or gauge No. Sch. 40

TYPE OF SCREEN OR PERFORATION MATERIAL:
 Steel Stainless Steel Fiberglass PVC Other (Specify)
 Brass Galvanized Steel Concrete tile None used (open hole)

SCREEN OR PERFORATION OPENINGS ARE:
 Continuous Slot Mill Slot Gauze Wrapped Torch Cut Drilled Holes Other (Specify)
 Louvered Shutter Key Punched Wire Wrapped Saw Cut None (Open Hole)

SCREEN-PERFORATED INTERVALS: From 13 ft. to 23.0 ft., From N/A ft. to N/A ft., From N/A ft. to N/A ft.
GRAVEL PACK INTERVALS: From 10 ft. to 23.0 ft., From N/A ft. to N/A ft., From N/A ft. to N/A ft.


9 GROUT MATERIAL: Neat cement Cement grout Bentonite Other Concrete 0 to 2
 Grout Intervals: From 2 ft. to 10 ft., From N/A ft. to N/A ft., From N/A ft. to N/A ft.

Nearest source of possible contamination:
 Septic Tank Lateral Lines Pit Privy Livestock Pens Insecticide Storage
 Sewer Lines Cess Pool Sewage Lagoon Fuel Storage Abandoned Water Well
 Watertight Sewer Lines Seepage Pit Feedyard Fertilizer Storage Oil Well/Gas Well
 Other (Specify)
 Direction from well? Distance from well? ft.

| 10 FROM | TO | LITHOLOGIC LOG | FROM | TO | LITHO. LOG (cont.) or PLUGGING INTERVALS |
|---------|----|---------------------|------|----|--|
| 0 | 1 | Grass/gravelly fill | | | |
| 1 | 23 | CLAY | | | |
| | 23 | Limestone | | | |
| Notes: | | | | | |

11 CONTRACTOR'S OR LANDOWNER'S CERTIFICATION: This water well was constructed, reconstructed, or plugged under my jurisdiction and was completed on (mo-day-year) 7-13-2021 and this record is true to the best of my knowledge and belief. Kansas Water Well Contractor's License No. 759 This Water Well Record was completed on (mo-day-year) 12-19-2021 under the business name of RAZEK Environmental, LLC Signature: [Signature]

Path: Z:\Clients\ENUS\COB119849_SFAAP\2019RFI\Study\GIS\MapData\SWMU 53\Figure 3 - SWMU53_Monitoring Well Locations.mxd
 COPYRIGHT © 2015 BURNS & McDONNELL ENGINEERING COMPANY, INC

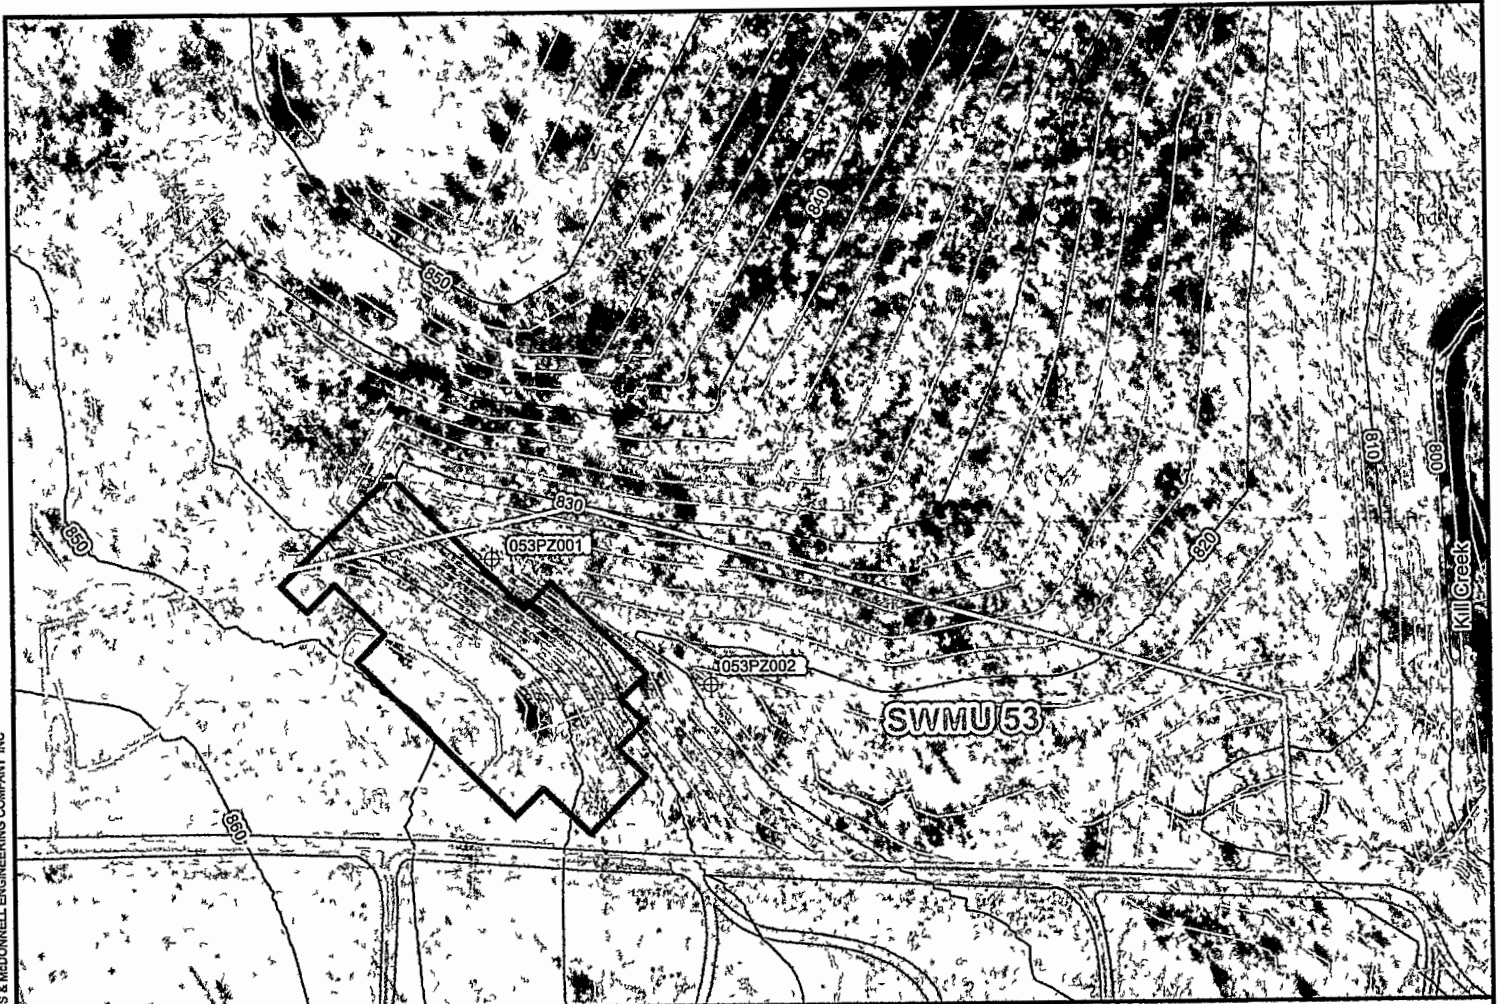

Legend

- Proposed Piezometer
- Inferred Groundwater Flow
- SWMU Boundary
- Intermittent Creek
- Approximate Location of Construction Debris Disposal Area
- Approximate Location of Burn Areas
- Road
- Stream

0 50 100
 Feet



**BURNS
 McDONNELL**

Figure 3

Proposed Temporary Piezometer Location Map
Supplemental RFI Work Plan
SWMU 53
 Former Sunflower Army Ammunition Plant
 De Soto, Kansas

Source: FSRI and Burns & McDonnell Engineering

Issued January 19, 2021