	WELL REC		Form WW					ision of Water urces App. No.		 Well ID	MW4	
		Correction	<u> </u>				- Keso		L Transkie Nim			
1		VATER WELL	;	Fraction, SW 1/4	SW ¼	SF ¼	sw ½		per Township Nur		Number 24 X E W	
County 2 WELI	L OWNER: L	act Name:		First:	J 77 /4			,	ell is located (if unk	<u></u>		
1	Business: Star Fuel Centers, Inc. from nearest town or intersection): If at owner's address, check here:											
Addres	s: 11161 Ove	rbrook Rd.,				11350 W	135th St.,	Overland Park, I	KS			
Addres		wood Cr	uta: VC	71D: 443	1.1							
3 LOCA	Leav TE WELL		ite: KS EPTH OF COM	ZIP: 662 IPLETED		35	ft	5 Latitude:	38.884		cimal degrees)	
	"X" IN		Groundwater E	ncountered:	1)		u	Longitud	e 94.718	352 (de	cimal degrees)	
SECT	ION BOX:	2)		ft,	ਯ ਖਮੁ	JDIY WCII	1		Datum: X WGS		83 NAD 27	
	N		STATIC WATE		*********	2.1 ft.			Latitude/Longitude unit make/model:	2:	,	
			elow land surfact bove land surfact						/AAS enabled?	lYes No	, , .	
	NE ·		test data: Well	water was	2 011 (1110-1	ft			Survey Topog		,	
w		aft	erhou	rs pumping		gpm		Onlin	e Mapper			
"		·	Wa	ter well was	3	ft	<u> </u>	C Elementica	1012 12 6	Ground L	evel X TOC	
sw	SE SE		erhou			gpm		6 Elevation	1013.13 ft Land Survey		Topographic Map	
] _x			ited Yield: lole Diameter: _			ft and	4	Source	Other] 0.5	1 ropograpino map	
	S				in to	ft			_			
I mile												
7 WELI 1 Domestic:			ıblic Water Sup	nlv: well ID	1		1	0 Oil Field	Water Supply: leas	e		
House		==	ewatering: how					1 Test Hole: we				
Lawn	& Garden		quifer Recharge	-				Cased	Uncased	Geotechnic	al	
Livest			onitoring: well				1	2 Geothermal: H	_ i			
2 Irrigat			nmental Remed					a) Closed Lo				
3 Feedlo		=	ir Sparge [ecovery [Injection	apor Extra	ctior		b) Open Loo Other (sp		ischarge	inj. oi water	
Was a chemical/bacteriological sample submitted to KDHE? Yes X No If yes, date sample was submitted: Water well disinfected? Yes X No												
8 TYPE OF CASING USED: Steel X PVC Other CASING JOINTS: Glued Clampled Welded X Threaded												
Casing diameter 2 in to 15 ft, Diameter in to ft, Diameter in to ft,												
Casing height above land surface -0.48 in. Weight lbs./ft. Well thickness or gauge No												
TYPE OF SCREEN OR PERFORATION MATERIAL:												
Steel Stainless Steel Fiberglass X PVC Other (Specify)												
Brass Galvanized Steel Concrete tile None used (open hole) SCREEN OR PERFORATION OPENINGS ARE:												
l —		X Mill Slot		Wrapped	ΤП	orch Cut	☐ Dril	ed Holes	Other (Specif	v)		
! ==		Key Punched						e (Open Hole)	(% p====,	,,		
SCREEN-PE	ERFORATED I	NTERVALS: F	rom 15	fl. to	35ft,	From	fi	. to	្ហារិ, From	ft. to	ft,	
GRA	VEL PACK IN	NTERVALS: F	rom 13	ft. to	35 ft,	From	f	. to	_ft, From	fl. to	<u></u> ft,	
9 GROUT MATERIAL: Neat cement Cement grout X Bentonite X Other Concrete: 0-0.5'												
Grout interva	*********	0.5 ft. to	13 ft, Fr	om	ft. to		ft, Fro	mft.	toft,			
Nearest sour	-	e contamination	i: iteral Lines	n	Driver			stock Pour	[Impactic! 4	a Storage		
Sewer			uerai Lines ess Pool		Privy wage Lago	ion		stock Pens Storage	Insecticid Abandone	e Storage ed Water Well		
	tight Sewer Lin	=	epage Pit	=	wage Lage edyard			lizer Storage	Oil Well /			
Other	(Specity)		. •		•		_					
Direction from	well? S	***************************************		Dis	tance fron	well? ~2	25		ft			
10 FROM	ТО	<u> </u>	LITHOLOG	IC LOG			FROM	ТО	LITHO, LOG (co	ont.) or PLUGGI	ng intervals	
0		Clay Shale	, , , , , , , , , , , , , , , , , , ,	- ,,,,,				_	1			
15	16	Limestone							 			
16	24	Shale										
24	26	Limestone										
26	29 35	Shale Limestone				- 	iotes: KDI	IE ID: Shell St	 ar Mart #909; U4-	046-14874		
									shallow groundwate		was installed at	
the direction of KDHE. 11 CONTRACTOR'S OR LANDOWNER'S CERTIFICATION: This water well was X constructed, reconstructed, or plugged under my jurisdiction and was completed on (mo-day-year) 2/11/19 and this record is true to the best of my knowledge and belief. Kansar water Well Contractor's												
II.			R'S CERTIFIC	CATION:	This wate	r well was	the best of	constructed,	reconstructed or	plugged	under my	
License No	-	oleted on (mo-day- This V	year) 2/11 Vater Well Reco	rd was con	uns recor	u is true to (mo-dav-ve	ar) 3/4/1	0		Water well Co	intractor 5	
	business name o	of Larsen & Ass	ociates, Inc.					Signature				
	Mail I white	copy along with a f	ee of \$5.00 for eac	ch constructe	d well to: k	Cansas Depa	rtment of H	ealth and Environr	nent, Bureau of Wate	GWTS Section	, ,	
				66612-1367			ell Owner aı	nd retain one for yo	our records. Telephon		47/10/2015	
Visit us	at http://www.kd	heks.gov/waterwell/	index.html		KSA 8	32a-1212				Kevise	d 7/10/2015	

DENNIS L HANDKE

1820 NW 59th Terrace TOPEKA, KANSAS 66618 785-286-4047 Home 785-286-1990 Fax

Jess Chapman Larsen & Associates 1311 E. 25th Street, Suite B Lawrence, Kansas, 66046 February 27, 2019

RE: Monitor Well Elevation Survey 11350 W. 135th St., Overland Park, Kansas

Proj. 19-00J Shell Star Mart #909 U4-046-14874

Bench Mark: Square cut on SW corner of concrete storm sewer inlet at SW Corner of property. Elev: 1012.23 North 98.20 West 3793.00 (from SE Cor. Sec. 26-13-24E) MW-4 rim 1013.61 North 267.36 SW1/4,SW1/4,SE1/4,SW1/4 top pipe 1013.13 West 3808.34 Lat = 38.88443 Long = 94.71852MW-5 rim 1013.48 123.25 SW1/4,SW1/4,SE1/4,SW1/4 North 1013.16 West Lat = 38.88404 Long = 94.71786top pipe 3620.21 MW-6 rim 1014.55 219.45 SW1/4,SW1/4,SE1/4,SW1/4 North top pipe 1014.07 West 3889.27 Lat = 38.88403 Long = 94.71880MW-7 3.41 rim 1014.25 North SW1/4,SW1/4,SE1/4,SW1/4 top pipe 1013.65 West 3906.05 Lat = 38.88371 Long = 94.71886MW-8 rim 1011.37 North SW1/4,SW1/4,SE1/4,SW1/4 7.78 top pipe 1010.93 West 3794.83 $Lat = 38.88371 \quad Long = 94.71847$ MW-9 rim 1007.85 South 3.37 NW1/4,NW1/4,NE1/4,NW1/4 (Sec. 35-13-24E)

3647.95

Lat = 38.88369 Long = 94.71796

Lat & Long derived from Lenexa 7.5 quad map. WGS84

1007.41

Elevation established from existing project.


If you have any questions, please feel free to call me. Thank you for the opportunity to be of service to you.

West

Denigis L Handke

SOLVE

top pipe

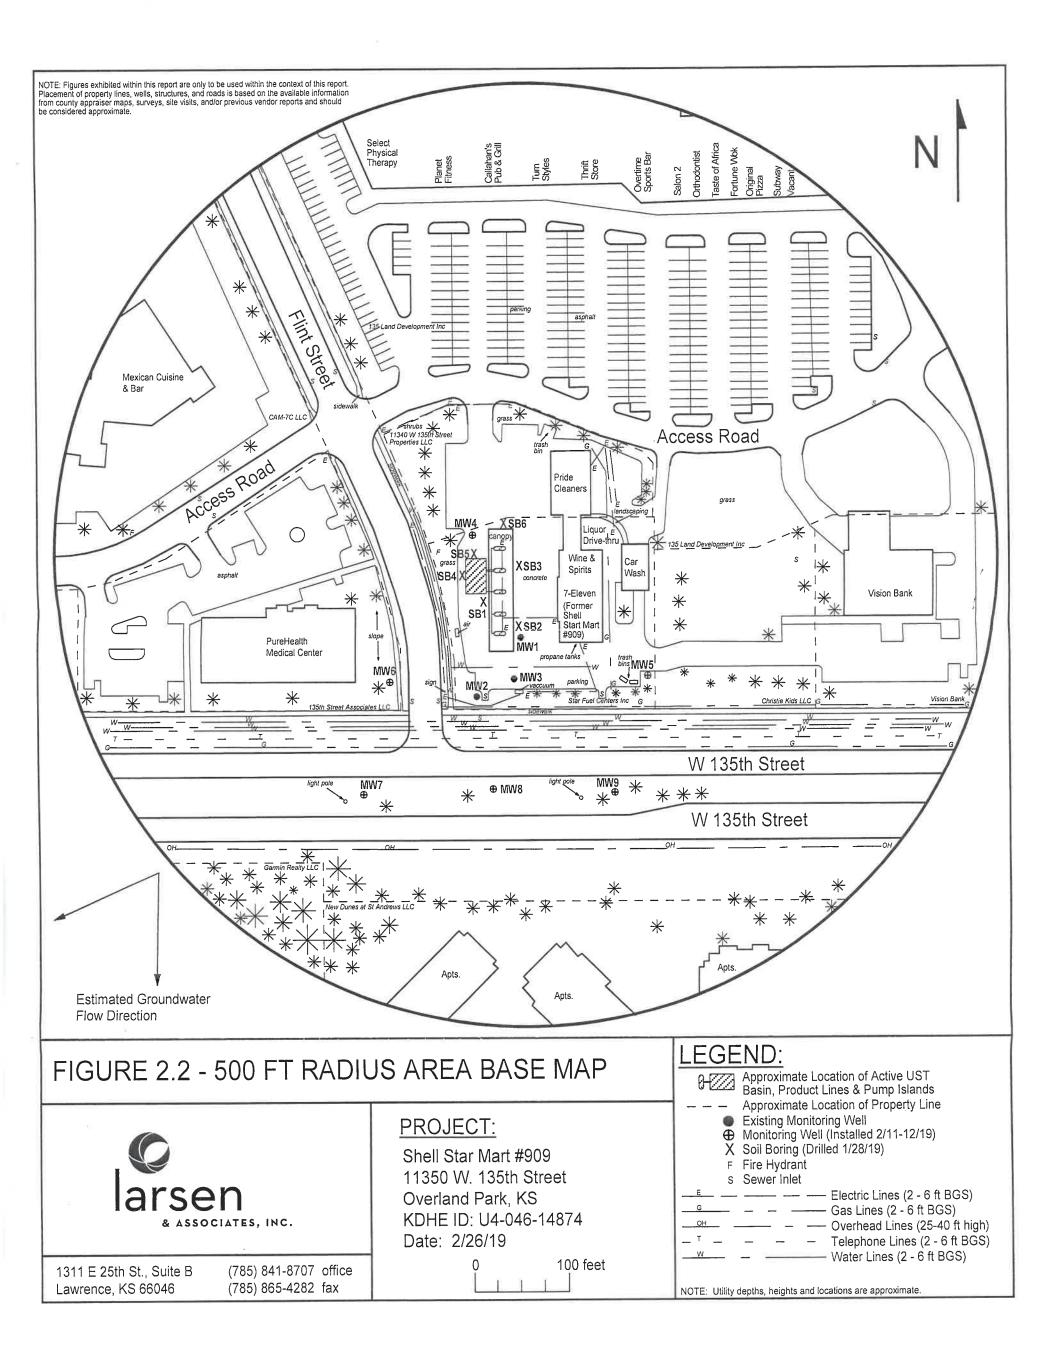

RECEIVED

MAR **26** 2019