
WATER				WWC-5		ision of Water		1W-11 1P	LMW-5	
		Correction		Fraction		ources App. No.	Township Numb	Well ID	ana Namahan	
	Johnson	ATER WEI	aka:	NW 1/2 NW 1/2 NW 1/2		ction Number 8	tber Township Number Range Number R 13 S R 25 ■ E 🗍 W			
2 WELL OWNER: Last Name: First: Street or Rural Address where well is located (if unknown, distance and										
	Star Fuel	Centers Inc					tersection): If at owner			
Address: 11161 Overbrook Road, Suite 150										
Address: City;	1 0000000		State: KS	7ID: CC244	10/01 Met	701 Wetcall Avenue, Overland Park, No				
2 TOOLME SUPER										
WITH "V" IN 4 DEPTH OF COMPLETED WELL:										
SECTION BOX: Depth(s) Groundwater Encountered: 1)								.(decimal degrees)		
N				TER LEVEL:						
				, measured on (mo-day			PS (unit make/model:)			
NW NE above land surface,				, measured on (mo-day	′-yr)		(WAAS enabled? ☐ Yes ☐ No)			
	1 1			vater was						
W	E afterhours pumping					Onl	ne Mapper: Google	: waps		
sw	1 SW 1 SE 1									
		Estimated Y	/ield:	gpm	· or···	6 Elevation	m։ <u>922</u>	. 🔲 Groun	d Level 🔲 TOC	
	S Bore Hole Diameter:8.25 in. to ft. and						Source:			
1 mile in. to										
7 WELL WATER TO BE USED AS: 1. Domestic: 5. Public Water Supply; well ID										
	☐ Lawn & Garden 7. ☐ Aquifer Recharge: we									
	□ Lawn & Garden 7. □ Aquifer Recharge: well ID □ Cased □ Uncased □ Geotechnical □ Livestock 8. ■ Monitoring; well ID LMW-5 12. Geothermal: how many bores?									
	. 🗌 Irrigation 9. Environmental Remediation: well ID									
3. Feedlot			Air Sparg		Extraction		n Loop 🔲 Surface D			
4. Industrial Recovery Injection 13. Other (specify):										
Was a chemical/bacteriological sample submitted to KDHE? Tyes No If yes, date sample was submitted:										
Water well disinfected? Yes No										
8 TYPE OF CASING USED: ☐ Steel ■ PVC ☐ Other CASING JOINTS: ☐ Glued ☐ Clamped ☐ Welded ■ Threaded										
Casing diameter										
TYPE OF SCREEN OR PERFORATION MATERIAL:										
☐ Steel ☐ Stainless Steel ☐ Fiberglass ■ PVC ☐ Other (Specify)										
☐ Brass ☐ Galvanized Steel ☐ Concrete tile ☐ None used (open hole)										
SCREEN OR PERFORATION OPENINGS ARE:										
☐ Continuous Slot										
Louvered Shutter										
SCREEN-PERFORATED INTERVALS: From										
ORAYEL FACA BYTERVALS: From										
9 GROUT MATERIAL: Neat cement Cement grout Bentonite Other										
Nearest source of possible contamination:										
☐ Septic	Tank		Lateral Lin			Livestock Pen		icide Storag		
☐ Sewer			Cess Pool	Sewage I	agoon E	Fuel Storage		loned Water		
☐ Watertight Sewer Lines ☐ Scepage Pit ☐ Feedyard ☐ Fertilizer Storage ☐ Oil Well/Gas Well										
☐ Other (Specify)										
10 FROM	TO		LITHOLO	GIC LOG	FROM	TO I	ITHO, LOG (cont.) c	r PLUGGI	NG INTERVALS	
0	1	Silty topsoil				1				
1	9	Silt with mir	or clay							
9	13.5	Weathered								
13.5	13.69	Shale								
						 				
					Notes:					
11 CONTRACTOR'S OR LANDOWNER'S CERTIFICATION: This water well was constructed, reconstructed, or plugged										
under my i	urisdiction	and was comi	oleted on (mo-day-year) .12/23	3/19 an	d this record is	true to the best of a	ny knowle	dge and belief	
Kansas Wa	ter Well Co	ontractor's Li	cense No.		Vater Well R	ecord was com	pleted on (mo-day-	year) ./.×	20	
Kansas Water Well Contractor's License No. 172 This Water Well Record was completed on (mo-day-year) 1.22										
Mail 1 white copy along with a fee of \$5.00 for each constructed well to: Kansas Department of Health and Environment, Bureau of Water, GWTS Section, 1000 SW Jackson St., Suite 420, Topeka, Kansas 66612-1367. Mail one to Water Well Owner and retain one for your records. Telephone 785-296-5524.										
				s 66612-1367. Mail one	to Water Well O KSA 82a-		e tor your records. Telej		96-5524. ed 7/10/2015	
y isit us at nil	o.a www.kane	ks.vov/waterwell	mucxann)		ひらい ひんぱ".	1212		TCV1S(_ G1U4/VI\\ D.	

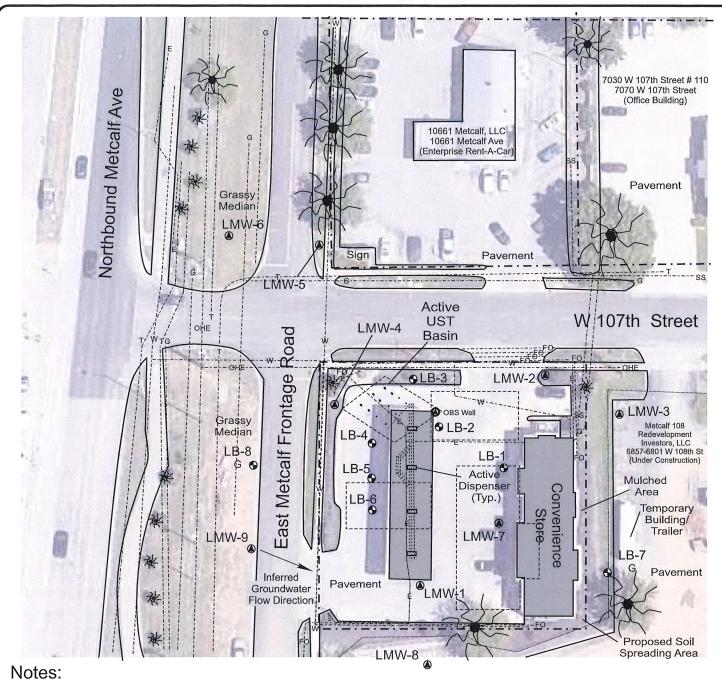

- Proposed Soil Boring Location (borings denoted with (G) for hydrologic samples)
- Tank Basin Observation Well

Proposed Monitoring Well

Product Line Location

UST Location

·- Property Boundary

米 Tree (approx.) Fence

- Buried Storm Sewer Line (3' 5' depth, approx.) StS
- Buried Sanitary Sewer Line (3' 5' depth, approx.) SS
- Т Buried Tele/Fiber Optic Line (3'-5' depth, approx.)
- Buried Gas Line (3' 5' depth, approx.) G
- Buried Water Line (4' depth, approx.) W
- Buried Electric Line (2' 3' depth, approx.) E
- Buried Traffic Line (2' 3' depth, approx.) Tr
- FΩ Buried Fiber Optic Line (2' - 3' depth, approx.)
- OHE Overhead Electric, Cable, & Telephone Line (15' ave height, approx.)

All drilling proposed for site owned by 7-Eleven, Inc..

