
WATER WELL F		- 4	WWC-5		ivision of Water	1	LMW-1	
Original Record			Y		sources App. No		Well ID	
1 LOCATION OF WATER WELL: County: Johnson			Fraction SW 1/2 NW 1/2 NW 1/2	Section Number   Township Number   Range Number   Range Number   R SW 1/4 SW 1				
2 WELL OWNER: I	act Nama:		R 25 ■ E □ W					
					Street or Rural Address where well is located (if unknown, distance and direction from nearest town or intersection): If at owner's address, check here:			
Address: 11161 O	erbrook Roa	d, Suite	150		· · · · · · · · · · · · · · · · · · ·			
Address: City: Leawood State: KS ZIP: 66211					10701 Metcalf Avenue, Overland Park, KS			
3 LOCATE WELL								
WITH "X" IN			APLETED WELL:		ft. 5 Latitue	łe: 38.9338	17(decimal degrees	
SECTION BOX:	Depth(s) Gr	oundwater	Encountered: 1)	ude:94.666	7.5.8(decimal degrees			
N	WELL'S STATIC WATER LEVEL:  below land surface, measured on (mo-day-yr)  above land surface, measured on (mo-day-yr)					ntal Datum: ☐ WGS 8	4 □ NAD 83 □ NAD 2	
						tt. Source for Latitude/Longitude: yr). 1/9/20		
NW NE						) (WAAS enabled?  Yes No)		
	Pump test data: Well water was				□ La	☐ Land Survey ☐ Topographic Map		
W	aner	after hours pumping gpm Well water was						
SW SE	after	offer hours summing						
	Estimated Y	Estimated Yield:						
S	Bore Hole D	Bore Hole Diameter:8.25 in. to						
1 mile  in. to ft. ■ Other .Google Maps								
7 WELL WATER TO BE USED AS: 1. Domestic: 5. Public Water Supply: well ID								
Household	6. Dewatering: how many wells?							
Lawn & Garden	7. ☐ Aquifer Recharge: well ID ☐ Cased ☐ Uncased ☐ Geotechnical 8. ■ Monitoring: well ID ☐ LMW-1 12. Geothermal: how many bores?							
Livestock	8.							
2. ☐ Irrigation 3. ☐ Feedlot	9. Er	9. Environmental Remediation: well ID						
4. Industrial	☐ Air Sparge ☐ Soil Vapor Extraction ☐ Surface Discharge ☐ Inj. of Water ☐ Recovery ☐ Injection ☐ I3. ☐ Other (specify):							
and the state of t								
Was a chemical/bacteriological sample submitted to KDHE? ☐ Yes ■ No If yes, date sample was submitted:								
8 TYPE OF CASING USED: Steel PVC Other CASING JOINTS: Glued Clamped Welded Threaded								
Casing diameter								
Casing diameter 2.0 in to ft., Diameter in to								
1 YPE OF SCREEN OR PERFORATION MATERIAL:								
☐ Steel ☐ Stainless Steel ☐ Fiberglass ☐ PVC ☐ Other (Specify)								
☐ Brass ☐ Galvanized Steel ☐ Concrete tile ☐ None used (open hole)  SCREEN OR PERFORATION OPENINGS ARE:								
☐ Continuous Slot  Mill Slot ☐ Gauze Wrapped ☐ Torch Cut ☐ Drilled Holes ☐ Other (Specify)								
Louvered Shutter   Key Punched   Wire Wranned   Saw Cut   None (Open Hole)								
SCREEN-PERFORATED INTERVALS: From .2.53 ft. to .12.53 ft. From ft. to ft. From ft. fo ft.								
GRAVEL PACK INTERVALS: From								
9 GROUT MATERIAL: Neat cement Cement grout Bentonite Other								
Grout Intervals: From								
Septic Tank		on: Lateral Line	es 🔲 Pit Privy	1	☐ Livestock Pen	e 🖺 Insacti	cida Storaga	
☐ Septic Tank ☐ Lateral Lines ☐ Pit Privy ☐ Livestock Pens ☐ Insecticide Storage ☐ Sewer Lines ☐ Cess Pool ☐ Sewage Lagoon ☐ Fuel Storage ☐ Abandoned Water Well								
☐ Watertight Sewer Lines ☐ Seepage Pit ☐ Feedward ☐ Fertilizer Storage ☐ Oil Well/Gas Well								
Other (Specify) Direction from well? North Distance from well? .97								
10 FROM TO	¥	ITHOLO	Distance from v	vell? .37	то		* DI LICODIO DISSESSE	
	Concrete/gra		GIC TOO	FROM	- 10 -	LITTO: LOG (CONT.) O	r PLUGGING INTERVAL	
	Silty clay fill	4501	***************************************		<del>                                     </del>			
3 9	Silt with clay	********	7		<del>                                     </del>			
	Silty clay							
						··· · · · · · · · · · · · · · · · · ·		
	***************************************							
				Notes:			halle hall the state of the sta	
				_				
11 CONTRACTORIS OF LANDOWNERS CORPUSED AND CONTRACTORIS OF THE CON								
11 CONTRACTOR'S OR LANDOWNER'S CERTIFICATION: This water well was constructed, reconstructed, or plugged under my jurisdiction and was completed on (mo-day-year) .12/1.12/1.9 and this record is true to the best of my knowledge and belief.								
Kansas Water Well Contractor's License No. 722 This Water Well Record was completed on (mo-day-year) I-laste								
Mail I white copy along with a fee of \$5.00 for each constructed well to: Kansas Department of Health and Environment, Bureau of Water, GWTS Section,								
Mail I white copy al	ong with a fee of	\$5.00 for ea	ch constructed well to: K	ansas Departm	ent of Health and I	environment, Bureau of V	Vater, GWTS Section,	
1000 SW Jackson St., Suite 420, Topeka, Kansas 66612-1367. Mail one to Water Well Owner and retain one for your records. Telephone 785-296-5524.  Visit us athttp://www.kdheks.gov/waterwell/index.html KSA 82a-1212 Revised 7/10/2015								
vian us at http://www.kunck	s gov waterwell/i	nacy.nem!		<u> </u>	1212		Revised 7/10/2015	

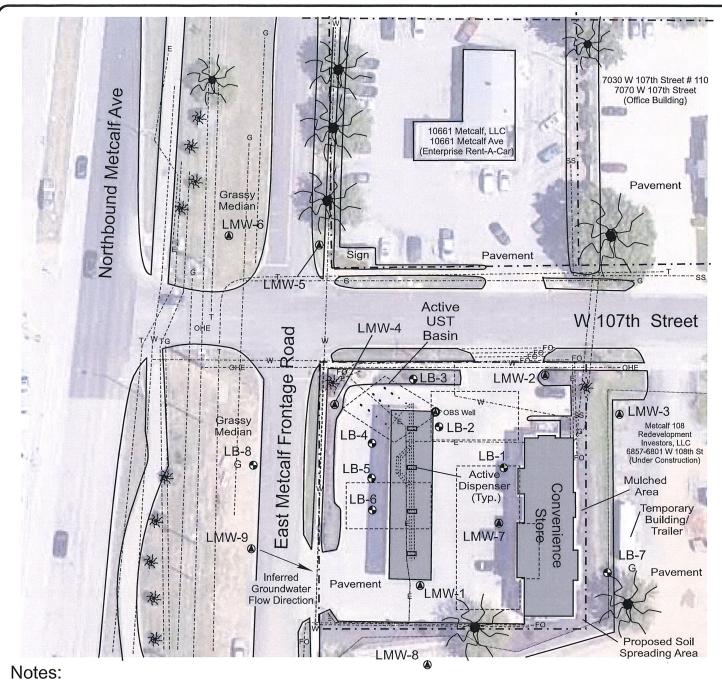

- Proposed Soil Boring Location (borings denoted with (G) for hydrologic samples)
- Tank Basin Observation Well

Proposed Monitoring Well

**Product Line Location** 

**UST Location** 

·- Property Boundary

米 Tree (approx.) Fence

- Buried Storm Sewer Line (3' 5' depth, approx.) StS
- Buried Sanitary Sewer Line (3' 5' depth, approx.) SS
- Т Buried Tele/Fiber Optic Line (3'-5' depth, approx.)
- Buried Gas Line (3' 5' depth, approx.) G
- Buried Water Line (4' depth, approx.) W
- Buried Electric Line (2' 3' depth, approx.) E
- Buried Traffic Line (2' 3' depth, approx.) Tr
- FΩ Buried Fiber Optic Line (2' - 3' depth, approx.)
- OHE Overhead Electric, Cable, & Telephone Line (15' ave height, approx.)

All drilling proposed for site owned by 7-Eleven, Inc..

