

WATER WELL RECORD

Form WWC-5

Division of Water Resources App. No.


Well ID

MW12

Original Record Correction Change in Well Ust

1 LOCATION OF WATER WELL: County Johnson Fraction NW 1/4 SW 1/4 SW 1/4 NE 1/4 Section Number 9 Township Number T 13 S Range Number R 25 E W

2 WELL OWNER: Last Name: Business: Sunshine Fuel, LLC Address: 95 N. Country Rd. City: Palm Beach State: FL ZIP: 33480 Street or Rural Address where well is located (if unknown, distance and direction from nearest town or intersection): If at owner's address, check here: ~130ft N of 10695 Roe Ave., Overland Park, KS

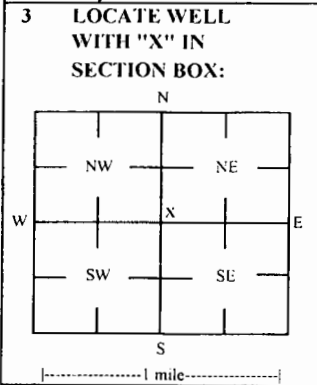

3 LOCATE WELL WITH 'X' IN SECTION BOX: 4 DEPTH OF COMPLETED WELL: 19 ft Depth(s) Groundwater Encountered: 1) 19 ft 2) ft 3) ft, or 4) Dry Well WELL'S STATIC WATER LEVEL: 9.72 ft

5 Latitude: 38.93593 (decimal degrees) Longitude: 94.63947 (decimal degrees) Horizontal Datum: X WGS 84 NAD 83 NAD 27 Source for Latitude/Longitude: GPS (unit make/model:) (WAAS enabled? Yes No) X Land Survey Topographic Map Online Mapper 6 Elevation 857.36 ft Ground Level X TOC Source X Land Survey GPS Topographic Map Other

7 WELL WATER TO BE USED AS: 1 Domestic: Household Lawn & Garden Livestock Irrigation Fecdot Industrial 2 Public Water Supply: well ID 3 Dewatering: how many wells? 4 Aquifer Recharge: well ID 5 Monitoring: well ID MW12 6 Environmental Remediation: well ID Air Sparge Soil Vapor Extractor Recovery Injection 7 Oil Field Water Supply: lease 8 Test Hole: well ID Cased Uncased Geotechnical 9 Geothermal: How many bores? a) Closed Loop Horizontal Vertical b) Open Loop Surface Discharge Inj. of Water Other (specify):

Was a chemical/bacteriological sample submitted to KDHE? Yes No X No If yes, date sample was submitted: Water well disinfected? Yes No X No

8 TYPE OF CASING USED: Steel PVC Other CASING JOINTS: Glued Clamped Welded X Threaded Casing diameter 2 in. to 9 ft. Diameter in. to ft. Diameter in. to ft. Casing height above land surface -0.31 in. Weight lbs./ft. Well thickness or gauge No TYPE OF SCREEN OR PERFORATION MATERIAL: Steel Stainless Steel Fiberglass PVC Other (Specify) SCREEN OR PERFORATION OPENINGS ARE: Continuous Slot X Mill Slot Gauze Wrapped Torch Cut Drilled Holes Other (Specify) Louvered Shutter Key Punched Wire Wrapped Saw Cut None (Open Hole) SCREEN-PERFORATED INTERVALS: From 9 ft. to 19 ft. From ft. to ft. From ft. to ft. GRAVEL PACK INTERVALS: From 7 ft. to 19 ft. From ft. to ft. From ft. to ft.

9 GROUT MATERIAL: Neat cement Cement grout X Bentonite X Other Concrete: 0-0.5' Grout intervals: From 0.5 ft. to 7 ft. From ft. to ft. From ft. to ft.

Nearest source of possible contamination: Septic Tank Lateral Lines Pit Privy Livestock Pens Insecticide Storage Sewer Lines Cess Pool Sewage Lagoon X Fuel Storage Abandoned Water Well Watertight Sewer Lines Seepage Pit Feedyard Fertilizer Storage Oil Well / Gas Well Other (Specify): Direction from well? S-SE Distance from well? ~200 ft

Table with columns: FROM, TO, LITHOLOGIC LOG, FROM, TO, LITHO. LOG (cont.) or PLUGGING INTERVALS. Rows: 0 to 0.5 (Topsoil), 0.5 to 17 (Clay), 17 to 19 (Shale).

Notes: KDHE ID: Texaco #29-126-020; U4-046-10473 Target of monitoring well is shallow groundwater, <20' of grout was installed at the direction of KDHE.

11 CONTRACTOR'S OR LANDOWNER'S CERTIFICATION: This water well was X constructed, reconstructed, or plugged under my jurisdiction and was completed on (mo-day-year) 1/17/22 and this record is true to the best of my knowledge and belief. Kansas Water Well Contractor's License No 757 This Water Well Record was completed on (mo-day-year) 5/25/22 under the business name of Larsen & Associates, Inc. Signature

Johnson

9-12-22

DENNIS L HANDKE

1820 NW 59th Terrace
TOPEKA, KANSAS 66618
785-286-4047 Home

Jess Chapman
Larsen & Assoc.
1311 E. 25th St., Suite B
Lawrence, Kansas, 66046

February 23, 2022

RE: Monitor Well Elevation Survey
10695 Roe Ave., Overland Park, Kansas

Proj. 22-00J
Texaco #29-126-020
KDHE ID U4-046-10473


Bench Mark: Chisled X on NE corner of concrete signal light base on the NE corner of 107th & Roe.
Elev: 862.15 North 2673.96 West 2593.44 (from SE Cor. Sec. 9-13-25E)

MW-10	rim	860.38	North	2684.23	SW1/4,SW1/4,SW1/4,NE1/4
	top pipe	860.18	West	2475.88	Lat= 38.93496 Long = 94.63905
MW-11	rim	858.43	North	2874.83	NE1/4,SE1/4,SE1/4,NW1/4
	top pipe	858.20	West	2771.94	Lat= 38.93548 Long = 94.64009
MW-12	rim	857.67	North	3037.83	NW1/4,SW1/4,SW1/4,NE1/4
	top pipe	857.36	West	2596.12	Lat= 38.93593 Long = 94.63947

Lat & Long derived from Lenexa 7.5' quad map. WGS 84.

Elevation established from existing proj. NAVD 88

If you have any questions, please feel free to call me. Thank you for the opportunity to be of service.

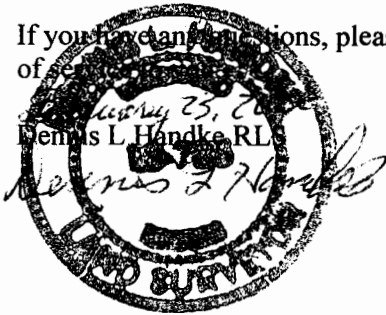

NOTE: Figures exhibited within this report are only to be used within the context of this report. Placement of property lines, wells, structures, and roads is based on the available information from county appraiser maps, surveys, site visits, and/or previous vendor reports and should be considered approximate.

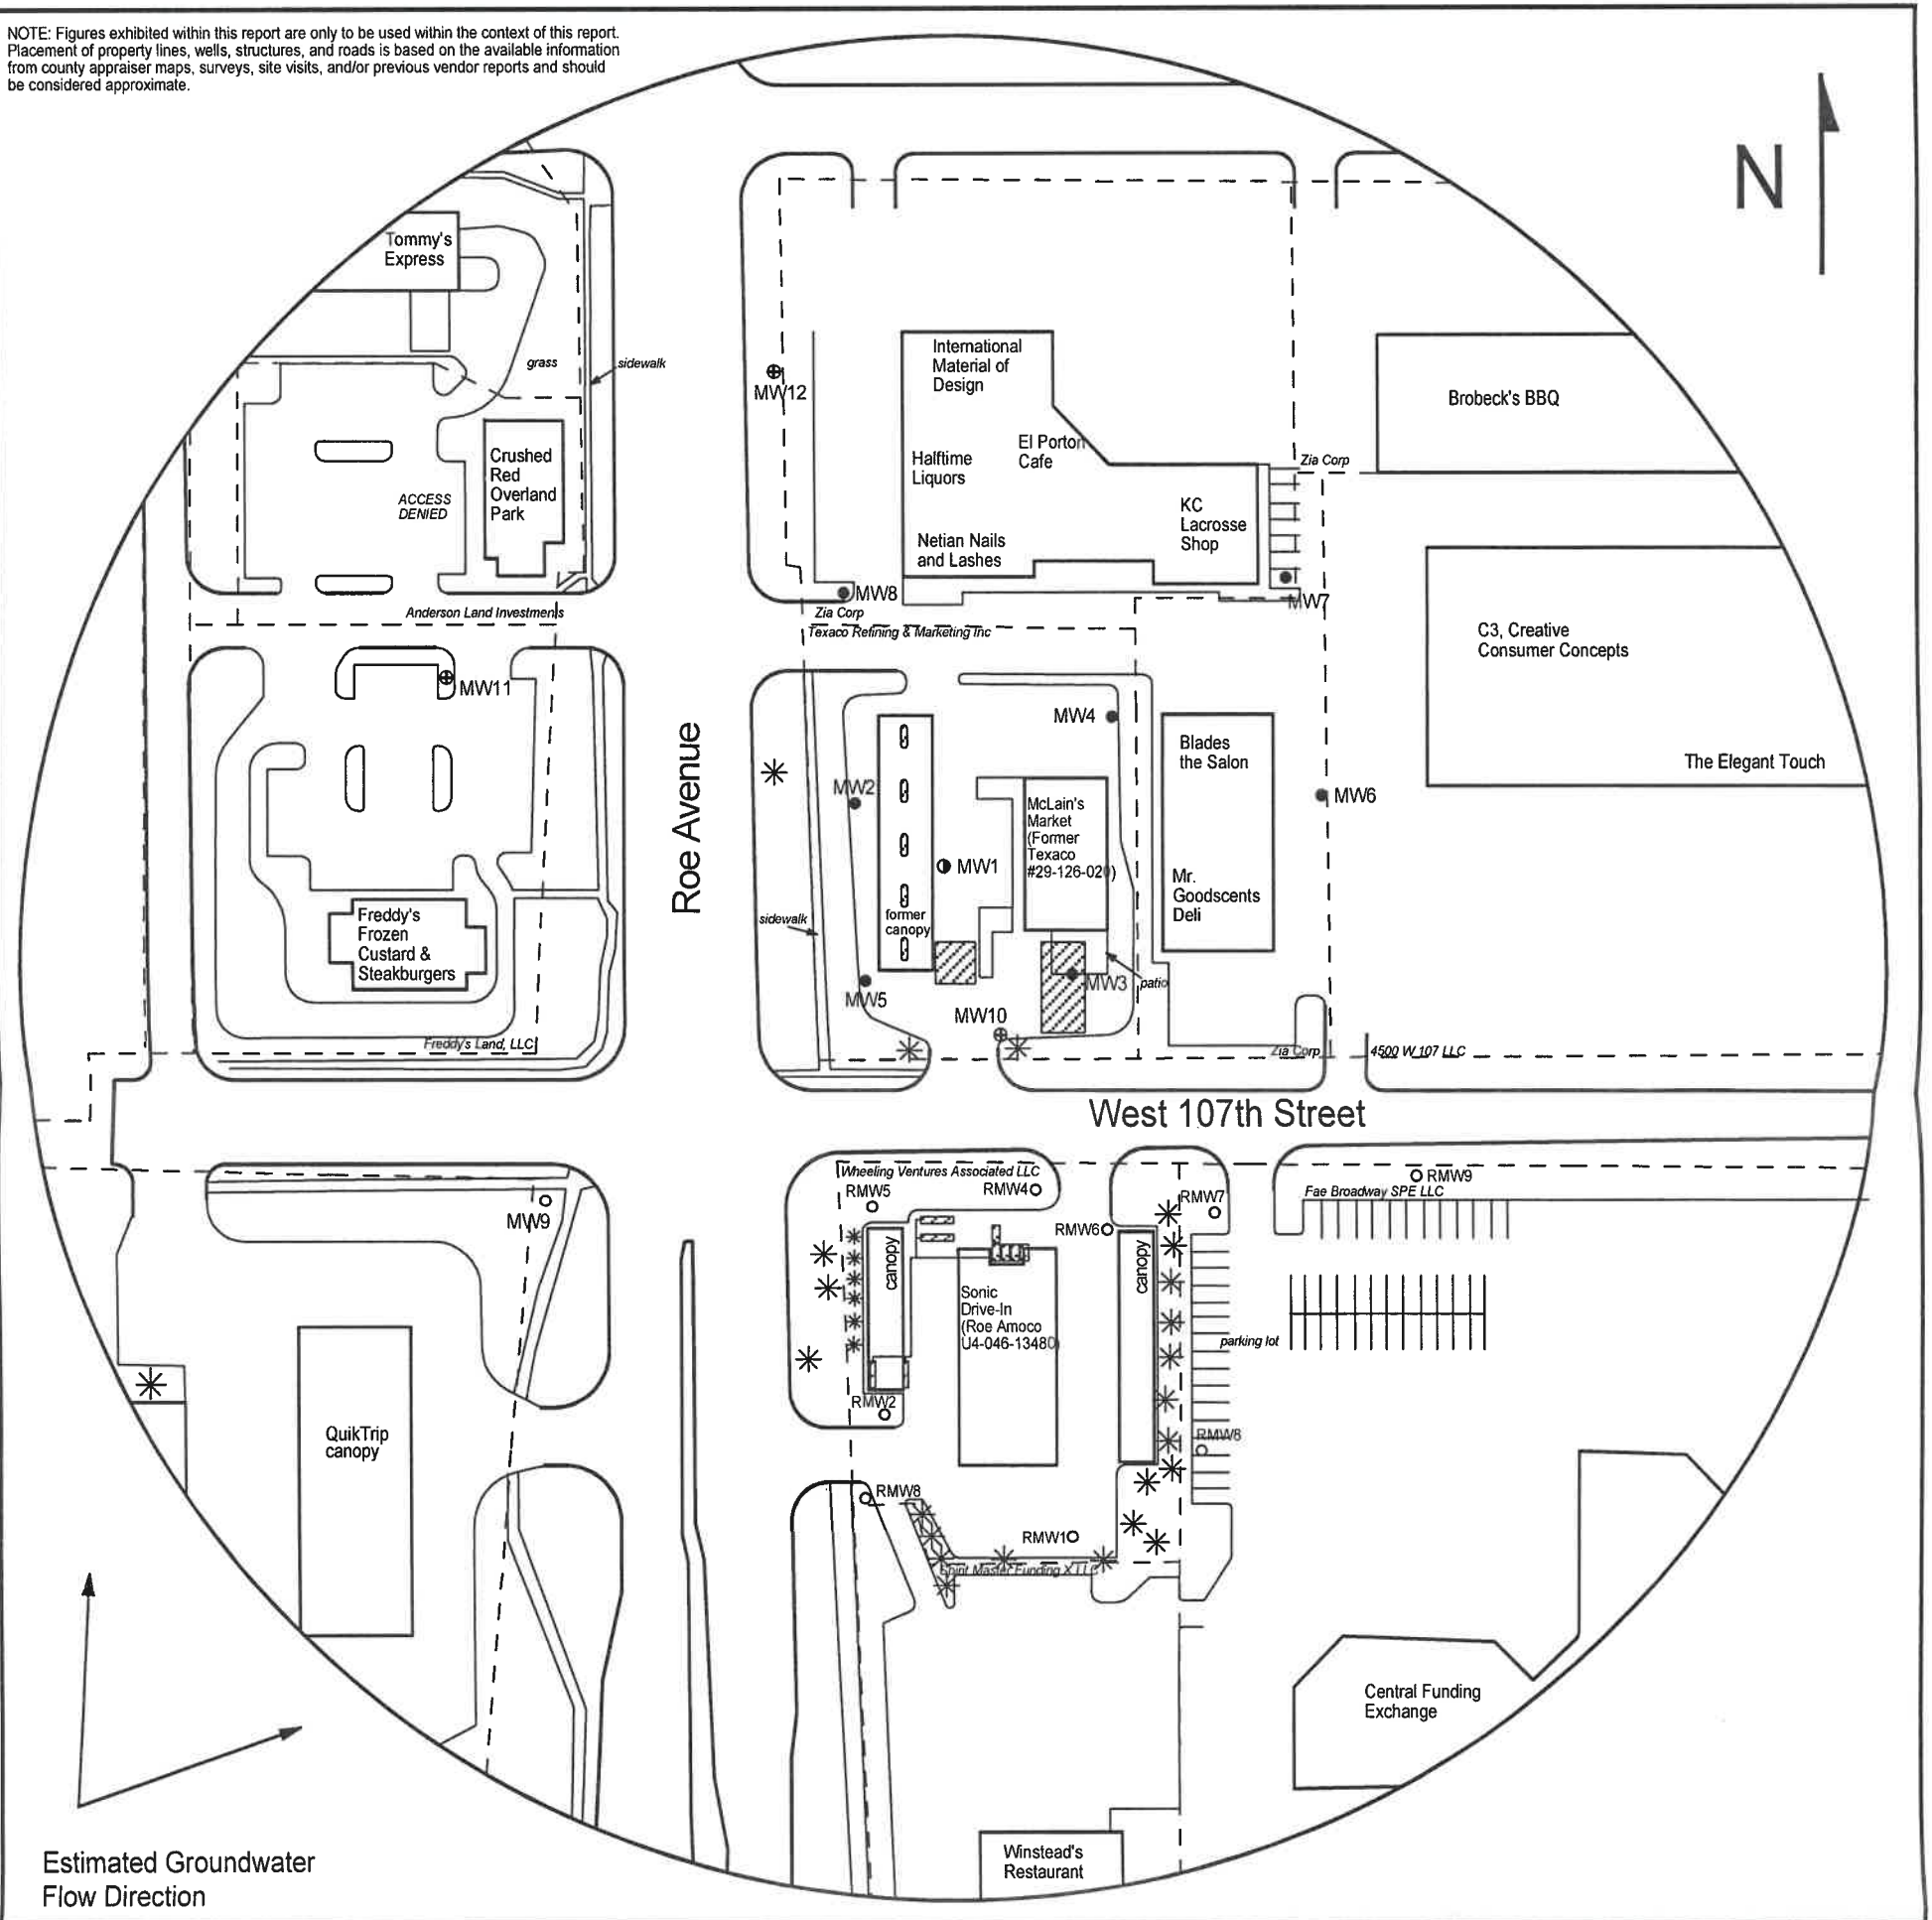


FIGURE 1 - 500 FT RADIUS AREA BASE MAP

LEGEND

- Approximate Location of Former UST Basin, Product Lines & Pump Islands
- Building with Basement
- Approximate Location of Property Line
- Existing Monitoring Well
- Plugged Monitoring Well
- New Monitoring Well (Installed 1/17/22)



PROJECT:

Texaco #29-126-020
 10695 Roe Ave.
 Overland Park, KS
 KDHE ID: U4-046-10473
 Date: 1/17/22



1311 E 25th St., Suite B 785-841-8707 office
 Lawrence, KS 66046 785-865-4282 fax