
WATER	WELL F	RECORD	Form '	WWC-5		Div	ision of Wa	ter	l.				
		Correction		e in Well Use		Reso	urces App.	No.		Well ID	)		
1 LOCATION OF WATER WELL: Fraction							tion Numb	er	Township Numb		ange Number		
-	: Dickinsor			SE 1/4 SE 1/4 NE									
							Street or Rural Address where well is located (if unknown, distance and						
							direction from nearest town or intersection): If at owner's address, check here:						
Address: Address:	4th St.			2326 Center	326 Center Street, Detroit								
1	City: Abilene State: KS ZIP: 67410												
3 LOCATE	00 -			20.0227	E								
	WITH "Y" IN 4 DEPTH OF COMPLETED WELL:99												
SECTIO	SECTION BOX:         Depth(s) Groundwater Encountered: 1)												
N				TER LEVEL:							D 83 □ NAD 27		
			below land surface, measured on (mo-day-yr)					Source for Latitude/Longitude:  GPS (unit make/model:)					
NW	NF		above land surface, measured on (mo-day-yr).					(WAAS enabled? ☐ Yes ☐ No)					
	1		Pump test data: Well water was ft.				☐ Land Survey ☐ Topographic Map						
W	E	after	after hours pumping gpi				■ Online Mapper: Google Earth						
SW	SE	offen.	Well water was ft. after hours pumping gpn										
	1		Estimated Yield:gpm				6 Elevation:ft. ☐ Ground Level ☐ TOC						
S Bore Ho			re Hole Diameter: 9 in. to 60			ft and							
1 m		Bore more	in. to										
7 WELL WATER TO BE USED AS:													
1. Domestic:		5.	Public Wa	ater Supply: well ID			10. 🔲 (	Dil Fi	eld Water Supply: le	ease			
	☐ Household 6. ☐ Dewatering: how many wells?						11. Test Hole: well ID						
					echarge: well ID			☐ Cased ☐ Uncased ☐ Geotechnical					
	Livestock 8. Monitoring: well ID								nal: how many bores				
3. ☐ Feedlot	2. ☐ Irrigation 9. Environmental Remediation: well ID 3. ☐ Feedlot ☐ Air Sparge ☐ Soil Vapor Ext								Loop Horizont				
	4. Industrial Recovery Injection							b) Open Loop					
Was a chemical/bacteriological sample submitted to KDHE? ☐ Yes ■ No If yes, date sample was submitted:													
8 TYPE OF CASING USED: Steel PVC Other CASING JOINTS: Glued Clamped Welded Threaded													
Casing diameter													
Casing height above land surface													
TYPE OF SCREEN OR PERFORATION MATERIAL:													
☐ Steel ☐ Stainless Steel ☐ Fiberglass ☐ PVC ☐ Other (Specify)													
☐ Brass ☐ Galvanized Steel ☐ Concrete tile ☐ None used (open hole)													
SCREEN OR PERFORATION OPENINGS ARE:													
☐ Continuous Slot ☐ Mill Slot ☐ Gauze Wrapped ☐ Torch Cut ☐ Drilled Holes ☐ Other (Specify)													
	red Shutter						Ione (Open			0			
	SCREEN-PERFORATED INTERVALS: From												
GRAVEL PACK INTERVALS: From													
9 GROUT MATERIAL: ☐ Neat cement ☐ Cement grout ☐ Bentonite ☐ Other													
Nearest sour	rce of possib	le contaminat	ion:	10, 1 10111		11. 10	10., 1 101.			11.			
☐ Septic 7			Lateral Line	es 🔲 Pit Privy	7		Livestock F	ens	☐ Insection	cide Stora	ige		
Sewer I			Cess Pool	☐ Sewage			Fuel Storag						
	☐ Watertight Sewer Lines ☐ Seepage Pit ☐ Feedyard ☐ Fertilizer Storage ☐ Oil Well/Gas Well												
☐ Other (Specify)  Direction from well? South Distance from well? .100 ft.													
10 FROM	TO TO		LITHOLO	GIC LOG	we	FROM	ТО	1 17	π. ΓΗΟ. LOG (cont.) οι	PI LICC	ING INTERVALS		
		Clay, Dark E		GIC LUG		36	40		ale, Yel Brn w/thi				
		Clay, Bark E				40	43		nestone, Gray Br				
				//Yel Shale strngr	S	43	46		ale, Yellow Brow		July Ollett		
				estone stringers	5	46	49	_	ale, Dark Gray				
						49	55			Limest	one stringers		
		Limestone, Lt. Gray to Yellow Brown Shale, Yellow w/Limestone stringer			55	60		Shale, Yellow w/thin Limestone stringers Shale, Pale Green					
		Limestone, very hard			Notes: 6								
	34 Shale, Yel Brn w/Gray Limestone strngrs												
34 36 Limestone, Gray Brown													
11 CONTRACTOR'S OR LANDOWNER'S CERTIFICATION: This water well was constructed, reconstructed, or plugged													
under my jurisdiction and was completed on (mo-day-year) .4/3/2020 and this record is true to the best of my knowledge and belief.													
Kansas Water Well Contractor's License No. 527  This Water Well Record was completed on (mo-day-year) 4/8/2020													
under the business name of .GeoCore, LLC.  Signature													
Mail I	SW Jackson	ong with a fee of	neka Kansas	66612-1367 Mail one	kan to V	Water Well Own	or Health an	one f	or your records. Talant	none 785-2	96-5524		
1000 SW Jackson St., Suite 420, Topeka, Kansas 66612-1367. Mail one to Water Well Owner and retain one for your records. Telephone 785-296-5524.  Visit us at http://www.kdheks.gov/waterwell/index.html  KSA 82a-1212  Revised 7/10/20													

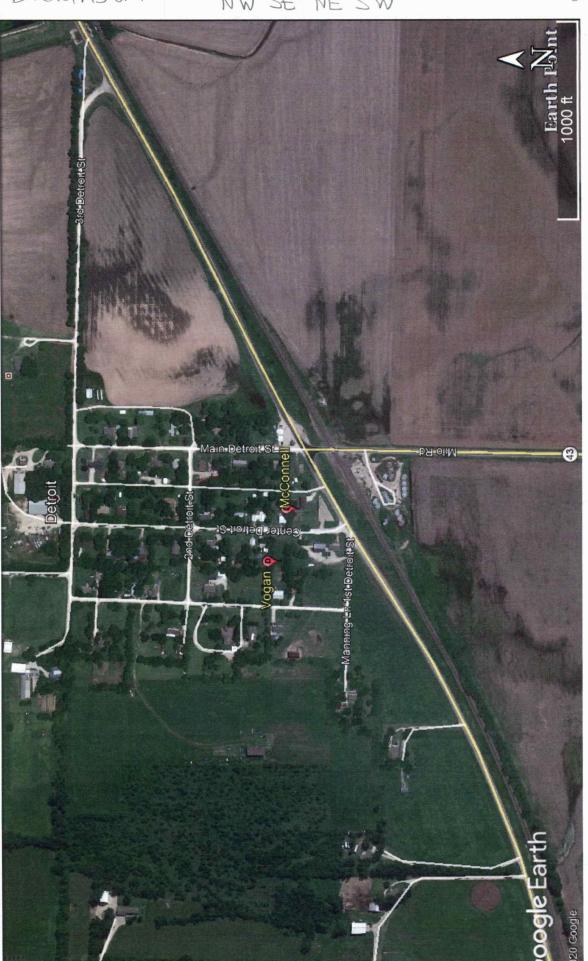

RECEIVED
MAY: 8 6 2020
BUREAU OF WATER

Domestic Wells – Detroit, Kansas GPS Coordinates:

Roy McConnell - 2326 Center Street: 38.93375, -97.12197 Dennis Vogan - 2300 Center Street: 38.93399, -97.12291