

WATER WELL RECORD

Form WWC-5

Division of Water Resources; App. No.

1 LOCATION OF WATER WELL: County: <u>Johnson</u>	Fraction <u>SW 1/4 NW 1/4 NW 1/4</u>	Section Number <u>01</u>	Township Number <u>T 14 S</u>	Range Number <u>R 23 D</u>
Distance and direction from nearest town or city street address of well if located within city? <input checked="" type="checkbox"/>		Global Positioning Systems (decimal degrees, min. of 4 digits) Latitude: <u>38° 52' 02.07" N</u> Longitude: <u>94° 48' 54.88" W</u> Elevation: <u>1040 ft</u> Datum: _____ Data Collection Method: <u>Google</u>		
2 WATER WELL OWNER: <u>Dept. of Public Safety</u> RR#, St. Address, Box # : <u>501 E Old 56 Highway</u> City, State, ZIP Code : <u>Olathe, Ks 66061</u>				

3 LOCATE WELL'S LOCATION WITH AN "X" IN SECTION BOX: N <table border="1" style="width: 100%; text-align: center; border-collapse: collapse;"><tr><td>W</td><td> </td><td> </td><td> </td><td>E</td></tr><tr><td></td><td>NW</td><td>--</td><td>NE</td><td></td></tr><tr><td></td><td> </td><td> </td><td> </td><td></td></tr><tr><td></td><td>SW</td><td>--</td><td>SE</td><td></td></tr><tr><td></td><td> </td><td> </td><td> </td><td></td></tr><tr><td></td><td>S</td><td></td><td></td><td></td></tr></table>	W				E		NW	--	NE								SW	--	SE								S				4 DEPTH OF COMPLETED WELL ... <u>500</u> ft. Depth(s) Groundwater Encountered (1)..... ft. (2)..... ft. (3)..... ft. WELL'S STATIC WATER LEVEL..... ft. below land surface measured on mo/day/yr..... Pump test data: Well water was.....ft. after..... hours pumping..... gpm Est. Yield.....gpm: Well water was.....ft. after..... hours pumping..... gpm WELL WATER TO BE USED AS: 5 Public water supply <input checked="" type="radio"/> 8 Air conditioning 11 Injection well 1 Domestic 3 Feedlot 6 Oil field water supply 9 Dewatering 12 Other (Specify below) 2 Irrigation 4 Industrial 7 Domestic (lawn & garden) 10 Monitoring well Was a chemical/bacteriological sample submitted to Department? Yes No <input checked="" type="checkbox"/> : If yes, mo/day/yr Sample was submitted..... Water well disinfected? Yes No <input checked="" type="checkbox"/>
W				E																											
	NW	--	NE																												
	SW	--	SE																												
	S																														

5 TYPE OF CASING USED <u>none</u> 1 Steel 2 PVC 3 RMP (SR) 4 ABS	5 Wrought Iron 6 Asbestos-Cement 7 Fiberglass	8 Concrete tile 9 Other (specify below)	CASING JOINTS: Glued..... Clamped..... Welded..... Threaded.....
Blank casing diameter in. to ft., Diameter..... in. to ft., Diameter..... in. to ft.		Casing height above land surface..... in., Weight lbs./ft. Wall thickness or gauge No.	
TYPE OF SCREEN OR PERFORATION MATERIAL: 1 Steel 3 Stainless Steel 5 Fiberglass 7 PVC 9 ABS 11 Other (Specify) 2 Brass 4 Galvanized Steel 6 Concrete tile 8 RM (SR) 10 Asbestos-Cement 12 None used (open hole)			
SCREEN OR PERFORATION OPENINGS ARE: 1 Continuous slot 3 Mill slot 5 Gauzed wrapped 7 Torch cut 9 Drilled holes 11 None (open hole) 2 Louvered shutter 4 Key punched 6 Wire wrapped 8 Saw Cut 10 Other (specify)			
SCREEN-PERFORATED INTERVALS: From..... ft. to ft., From..... ft. to ft. From..... ft. to ft., From..... ft. to ft.			
GRAVEL PACK INTERVALS: From..... ft. to ft., From..... ft. to ft. From..... ft. to ft., From..... ft. to ft.			

6 GROUT MATERIAL: 1 Neat cement 2 Cement grout 3 Bentonite 4 Other Thermal grout

Grout Intervals: From ft. to ft., From ft. to ft., From ft. to ft.

What is the nearest source of possible contamination:
1 Septic tank 4 Lateral lines 7 Pit privy 10 Livestock pens 13 Insecticide Storage 16 Other (specify below)
2 Sewer lines 5 Cess pool 8 Sewage lagoon 11 Fuel storage 14 Abandoned water well below
3 Watertight sewer lines 6 Seepage pit 9 Feedyard 12 Fertilizer Storage 15 Oil well/gas well


Direction from well? How many feet?

FROM	TO	LITHOLOGIC LOG	FROM	TO	PLUGGING INTERVALS
0	5	black dirt	500	5	Thermal grout
5	17	Clay			
17	125	limestone			
125	200	shale			
200	325	limestone			
325	375	shale			
375	425	limestone			
425	500	shale			

36 holes total

7 CONTRACTOR'S OR LANDOWNER'S CERTIFICATION: This water well was constructed, reconstructed, or plugged under my jurisdiction and was completed on (mo/day/year) 9/21/09 and this record is true to the best of my knowledge and belief. Kansas Water Well Contractor's License No. 6661..... This Water Well Record was completed on (mo/day/year) 10/29/09 under the business name of Ground Source Systems, Inc by (signature) [Signature]



INSTRUCTIONS: Use typewriter or ball point pen. PLEASE PRESS FIRMLY and PRINT clearly. Please fill in blanks, underline or circle the correct answers. Send top three copies to Kansas Department of Health and Environment, Bureau of Water, Geology Section, 1000 SW Jackson St., Suite 420, Topeka, Kansas 66612-1367. Telephone 785-296-5522. Send one to WATER WELL OWNER and retain one for your records. Fee of \$5.00 for each constructed well. Visit us at <http://www.kdheks.gov/waterwell/index.html>.

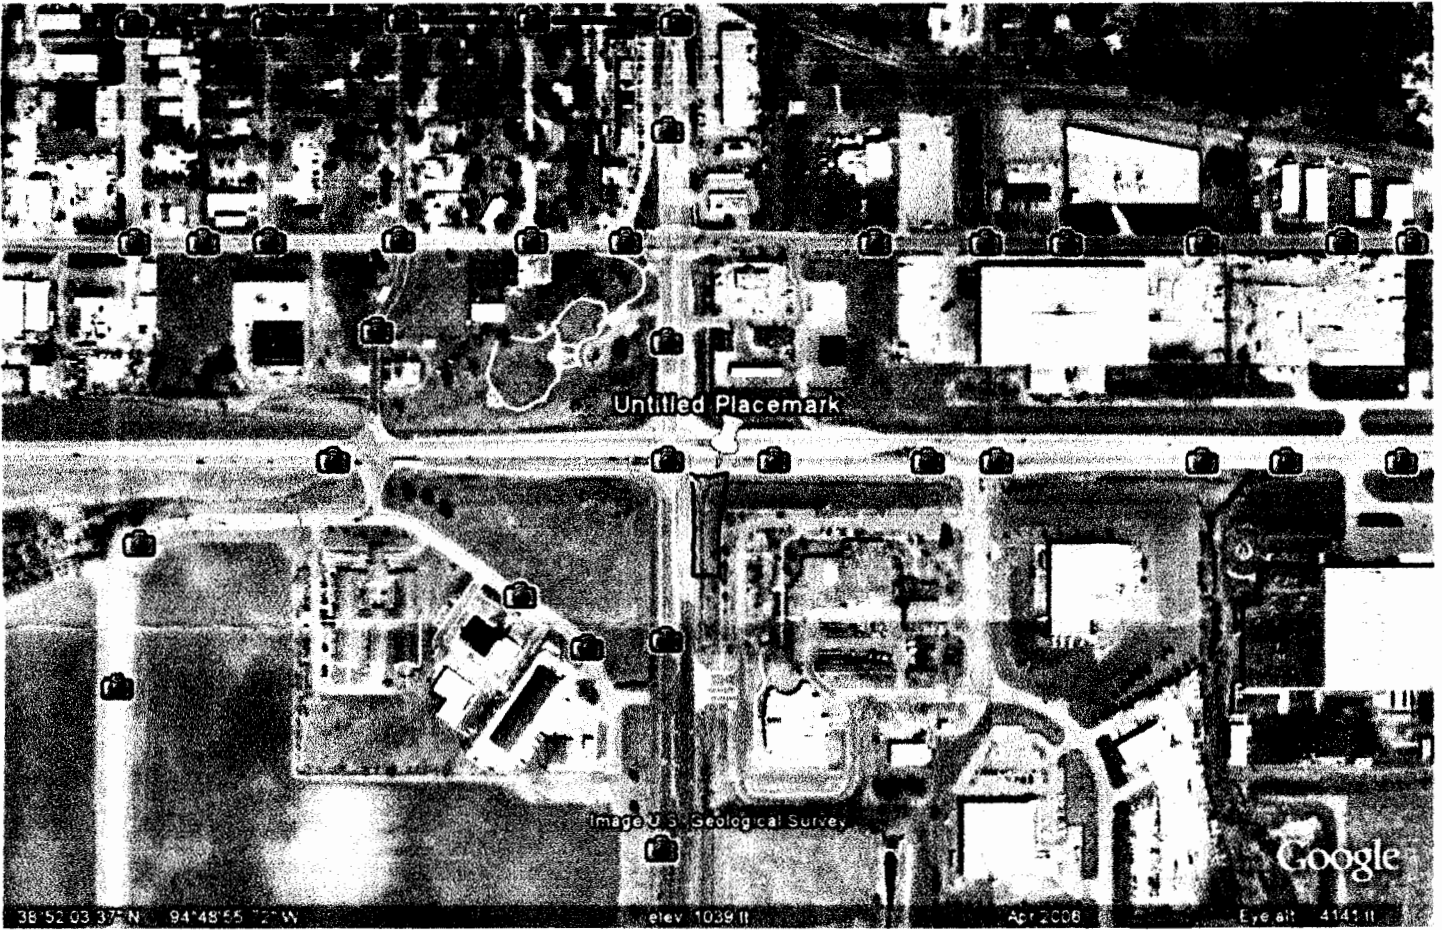

On the Public Safety Bldg. 501 E. Oak Hwy > 6
 Olathe, Ks. 66061

Contact Capt David Biddulph
 913-971-7500

Brock Henderson
 913-742-5668

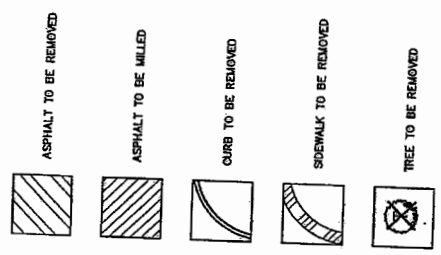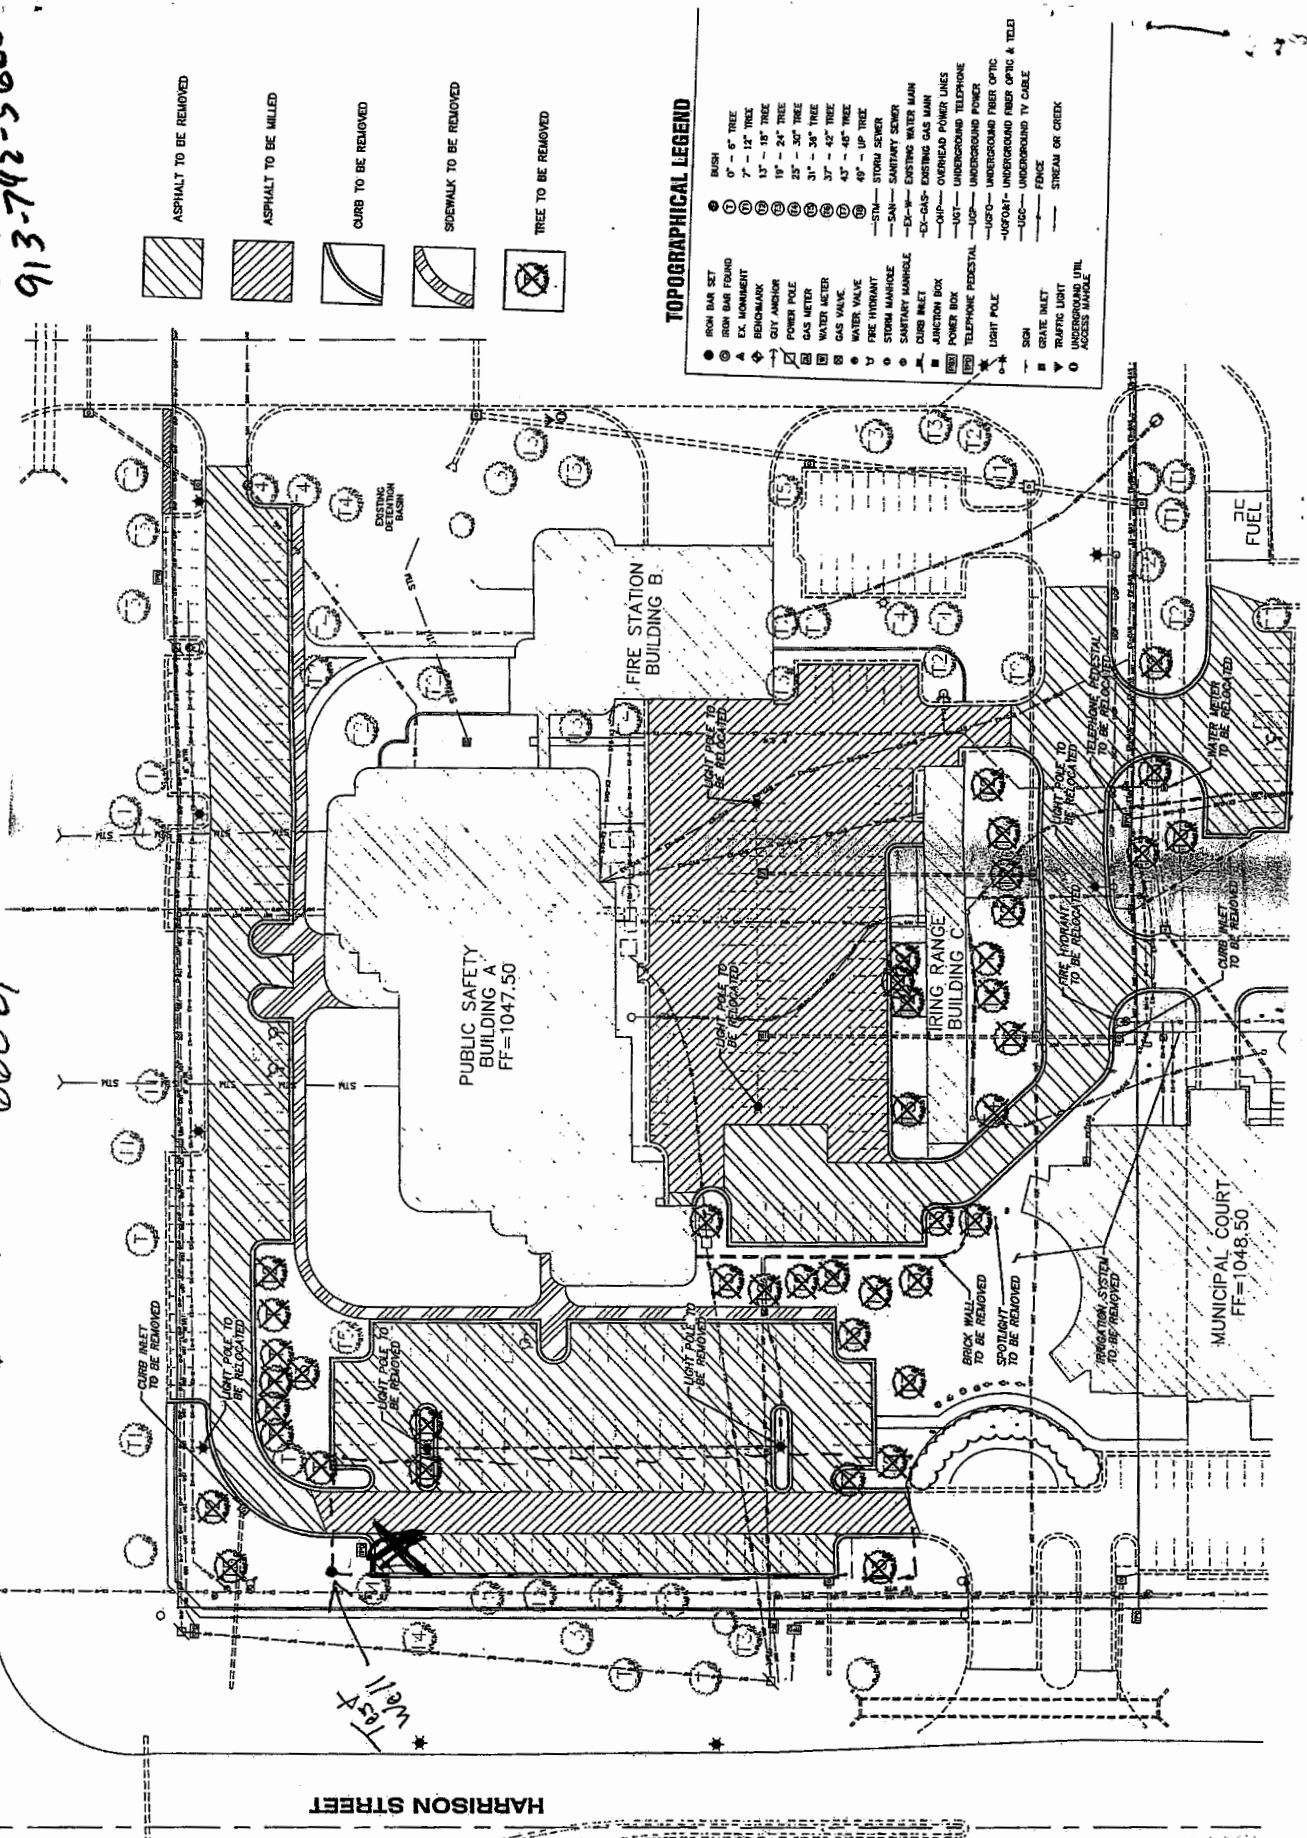

TOPOGRAPHICAL LEGEND

- IRON BAR SET
- ▲ EX. MONUMENT
- ⊙ BENCHMARK
- ⊙ CITY ANCHOR
- ⊙ POWER POLE
- ⊙ GAS METER
- ⊙ WATER METER
- ⊙ GAS VALVE
- ⊙ WATER VALVE
- ⊙ FIRE HYDRANT
- ⊙ STORM MANHOLE
- ⊙ SANITARY MANHOLE
- ⊙ CURB INLET
- ⊙ JUNCTION BOX
- ⊙ POWER BOX
- ⊙ TELEPHONE PEDestal
- ⊙ TELEPHONE POLE
- ⊙ LIGHT POLE
- ⊙ SIGN
- ⊙ GATE INLET
- ⊙ TRAFFIC LIGHT
- ⊙ UNDERGROUND UTIL
- ⊙ FACED INHALE
- 0" - 6" TREE
- 7" - 12" TREE
- 13" - 18" TREE
- 19" - 24" TREE
- 25" - 30" TREE
- 31" - 36" TREE
- 37" - 42" TREE
- 43" - 48" TREE
- 49" - UP TREE
- STORM SEWER
- SANITARY SEWER
- EXISTING WATER MAIN
- EXISTING GAS MAIN
- OVERHEAD POWER LINES
- UNDERGROUND TELEPHONE
- UNDERGROUND POWER
- UNDERGROUND FIBER OPTIC & TELL
- UNDERGROUND TV CABLE
- FENCE
- STREAM OR CREEK