

123

Bushong

Redline

Chap el jd


USE TYPEWRITER OR BALL POINT PEN-PRESS FIRMLY, PRINT CLEARLY.

WATER WELL RECORD KSA 82a-1201-1215

Kansas Department of Health and Environment-Division of Environment (Water well Contractors) Topeka, Kansas 66620

1. Location of well:	County Wabaunsee	Fraction SW 1/4 SW 1/4 NE 1/4	Section number 13	Township number T 15 S	Range number R 9
----------------------	----------------------------	---	-----------------------------	----------------------------------	----------------------------

2. Distance and direction from nearest town or city: Street address of well location if in city: 6 east- 7 north Council Grove Ks.	3. Owner of well: Ed Mahoney R.R. or street: RR City, state, zip code: Council Grove, Kansas
--	---

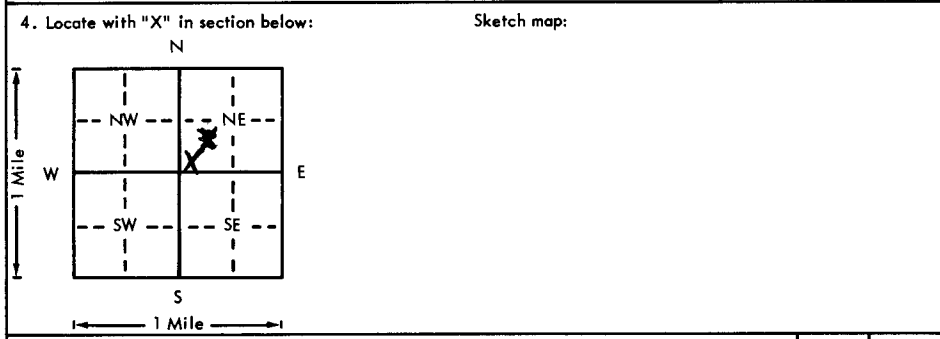

6. Bore hole dia. 8 in. Completion date 6/1/78 Well depth 100 ft.
7. <input checked="" type="checkbox"/> Cable tool <input type="checkbox"/> Rotary <input type="checkbox"/> Driven <input type="checkbox"/> Dug <input type="checkbox"/> Hollow rod <input type="checkbox"/> Jetted <input type="checkbox"/> Bored <input type="checkbox"/> Reverse rotary
8. Use: <input type="checkbox"/> Domestic <input type="checkbox"/> Public supply <input type="checkbox"/> Industry <input type="checkbox"/> Irrigation <input type="checkbox"/> Air conditioning <input checked="" type="checkbox"/> Stock <input type="checkbox"/> Lawn <input type="checkbox"/> Oil field water <input type="checkbox"/> Other
9. Casing: Material pit Height: 48 Above or below Threaded <input type="checkbox"/> Welded gl Surface 48 in. RMP <input type="checkbox"/> PVC <input checked="" type="checkbox"/> Weight <input type="checkbox"/> lbs./ft. Dia. 6 in. to 100 ft. depth Wall Thickness: inches or Dia. <input type="checkbox"/> in. to <input type="checkbox"/> ft. depth gage No. 3

5. Type and color of material	From	To
top soil black	0	5
limestone broken/ tan	5	12
shale grey	12	19
shale red	19	25
limestone soft/ tan	25	32
shale grey	32	41
rock soft/ tan	41	43
shale grey	43	51
shale soft/ green	51	65
shale blue/grey	65	73
shale grey	73	85
shale dark grey	85	100
(Use a second sheet if needed)		

10. Screen: Manufacturer's name Shop perf. Type slot Dia. 6 Slot/gauze 3/16 Length 10ft. Set between 25 ft. and 33 ft. Gravel pack? yes Size range of material 3/8 ft.
11. Static water level: 22 ft. below land surface Date 6/1/78 mo./day/yr.
12. Pumping level below land surfaces: ____ ft. after ____ hrs. pumping ____ g.p.m. ____ ft. after ____ hrs. pumping ____ g.p.m. Estimated maximum yield 5 g.p.m.
13. Water sample submitted: ____ mo./day/yr. <input type="checkbox"/> Yes <input checked="" type="checkbox"/> No Date ____
14. Well head completion: <input checked="" type="checkbox"/> Pitless adapter 48 inches above grade
15. Well grouted? yes With: <input checked="" type="checkbox"/> Neat cement <input type="checkbox"/> Bentonite <input type="checkbox"/> Concrete Depth: From 5 ft. to 15 ft.
16. Nearest source of possible contamination: ft. 2000 Direction east Type cattle Well disinfected upon completion? <input checked="" type="checkbox"/> Yes <input type="checkbox"/> No
17. Pump: <input checked="" type="checkbox"/> Not installed Manufacturer's name _____ Model number _____ HP _____ Volts _____ Length of drop pipe _____ ft. capacity _____ g.p.m. Type: <input type="checkbox"/> Submersible <input type="checkbox"/> Turbine <input type="checkbox"/> Jet <input type="checkbox"/> Reciprocating <input type="checkbox"/> Centrifugal <input type="checkbox"/> Other

18. Elevation: **1370**
Topography:
 Hill
 Slope
 Upland
 Valley

19. Remarks:
1370

20. Water well contractor's certification:
This well was drilled under my jurisdiction and this report is true to the best of my knowledge and belief.
Bledsoe Drilling Co. 349
Business name license No.
Address **RR Cottonwood Falls**
Signed **John A. Bledsoe** date **7-22-78**
Authorized representative

15-9-13
T
R
W
S
1/4
1/4
1/4
1/4
SUBSCRIBE

Forward the white, blue and pink copies to the Department of Health and Environment

Form WWC-5