
WATER WELL RECORD Form WWC-5				ision of Water		W-1170	MW-13		
Original Record Correction Change in Well Use				ources App. No.		Well ID	ge Number		
1 LOCATION OF WATER WELL: Fraction SE 1/4 SE 1/4 SW			Section Number Township Number Range Number Range Number T 18 S R 11 ⊠ E [
County: Lyon 2 WELL OWNER: I	art Nama	First:			here well is located				
Business: Kansas	Turnpike Authori				tersection): If at owner				
Address: 9401 Ke		•		MP 132 I-335, Emporia, KS					
Address:	State:	KS ZIP: 67207		•					
City: Wichita			20						
3 LOCATE WELL WITH "X" IN	4 DEPTH OF	COMPLETED WELL:	£	. 5 Latitud	e:38.4/114		(decimal degrees)		
SECTION BOX:	Depth(s) Groundw	ater Encountered: 1)	y n.	n. Longitude: 30.10070 (decimal degrees)					
N	2)	1. 3)	Dry Well						
		WATER LEVEL:2.1. rface, measured on (mo-day		8. Source for Latitude/Longitude: GPS (unit make/model:					
NWNE		rface, measured on (mo-day			(WAAS enabled? Yes No)				
X		ell water was		□ Land Survey □ Topographic Map					
W ^ E		hours pumping			Online Mapper:				
SWSE		/ell water was							
	Estimated Yield: .	hours pumping	. gpm	6 Elevation	on:1160.81ft	. Ground	Level X TOC		
S	Rore Hole Diamet	gpm er:8.25 in. to30	ft and	Source:		GPS T	pographic Map		
1 mile		in. to			☐ Other				
7 WELL WATER TO									
1. Domestic:	5. 🔲 Publi	c Water Supply: well ID			ield Water Supply: 10				
☐ Household		atering: how many wells?			le: well ID				
Lawn & Garden	7. ☐ Aqui	fer Recharge: well ID toring: well IDMW	.13		d Uncased 0				
Livestock	8. KI Moni	mental Remediation: well I	n		mal: how many bore: ed Loop 🏻 Horizon				
2. Irrigation 3. Feedlot	9. Environ				n Loop 🔲 Surface Di				
4. Industrial	Reco		Extraction		r (specify):				
		ubmitted to KDHE?	Yes XI No		ample was submitte				
Water well disinfected			100 20110	11) 00, 0010 0	·		•••••		
8 TYPE OF CASING	USED: Steel	PVC Other	CASI	NG JOINTS:	□ Glued □ Clampe	d □ Welded	i 🕅 Threaded		
Casing diameter2	in. to20	ft., Diameter							
Casing height above land	surface0.5	in. Weight	lbs./ft.	Wall thickne	ess or gauge NoS.C.	1.40			
TYPE OF SCREEN O				5 0.1					
☐ Steel ☐ Stainless Steel ☐ Fiberglass ☑ PVC ☐ Other (Specify)									
Brass Gal			usea (open noie	;)					
Continuous Slot			orch Cut. 🖂 D	rilled Holes [Other (Specify)				
Louvered Shutter				one (Open Hol		,			
SCREEN-PERFORAT	ED INTERVALS:	From 20 ft. to 30	ft., From	ft. to	ft., From				
GRAVEL PACK INTERVALS: From									
9 GROUT MATERIA	L: Neat cement	Cement grout B	entonite 🔲 C	ther					
Grout Intervals: From 18 ft. to 16 ft., From 16 ft. to 1 ft., From ft. to ft.									
Nearest source of possib	te contamination:	Lines Pit Privy	. п	Livestock Pens	[] Incesti	cide Storage			
Septic rank	Cess Po			Fuel Storage	_	oned Water	Well		
☐ Watertight Sewer Li	nes 🗍 Seepag	e Pit		Fertilizer Storag		II/Gas Well			
Other (Specify) .C.	ontaminated site.	U3-056-13023/-14555	On-	cito					
	On-site	Distance from w	rell? 0!!-	**************	ft.		C DIMEDILLI C		
10 FROM TO 0.5	Asphalt	LOGIC LOG	FROM	TO L	ITHO. LOG (cont.) or	PLUGGIN	GINTERVALS		
		to red brn, firm				······································			
0.5 30 TD 30	Silly Clay, bill	to rea biri, iiiiii	- 						
15 30			1						
			1						
			Notes:	-					
11 CONTRACTOR'S OR LANDOWNER'S CERTIFICATION: This water well was constructed, reconstructed, or plugged under my jurisdiction and was completed on (mo-day-year)6/25/18 and this record is true to the best of my knowledge and belief.									
Kansas Water Well Co.	under my jurisdiction and was completed on (mo-day-year)								
under the business nam	e of Associated	Environmental, Inc.	Si	gnature	Sandley John	 ,,,			
Mail 1 white copy al	ong with a fee of \$5.00 f	or each constructed well to: Ka	nsas Department	of Health and En	vironment, Bureau of W	ater, GWTS S	ection,		
		ansas 66612-1367. Mail one to	Water Well Own	er and retain one	for your records. Teleph	one 785-296-	5524. 7/10/2015		
Visit us at http://www.kdhek	s.gov/waterwell/index.ht	m1	KSA 82a-12	14		VEAISEG	II IUI AUI J		



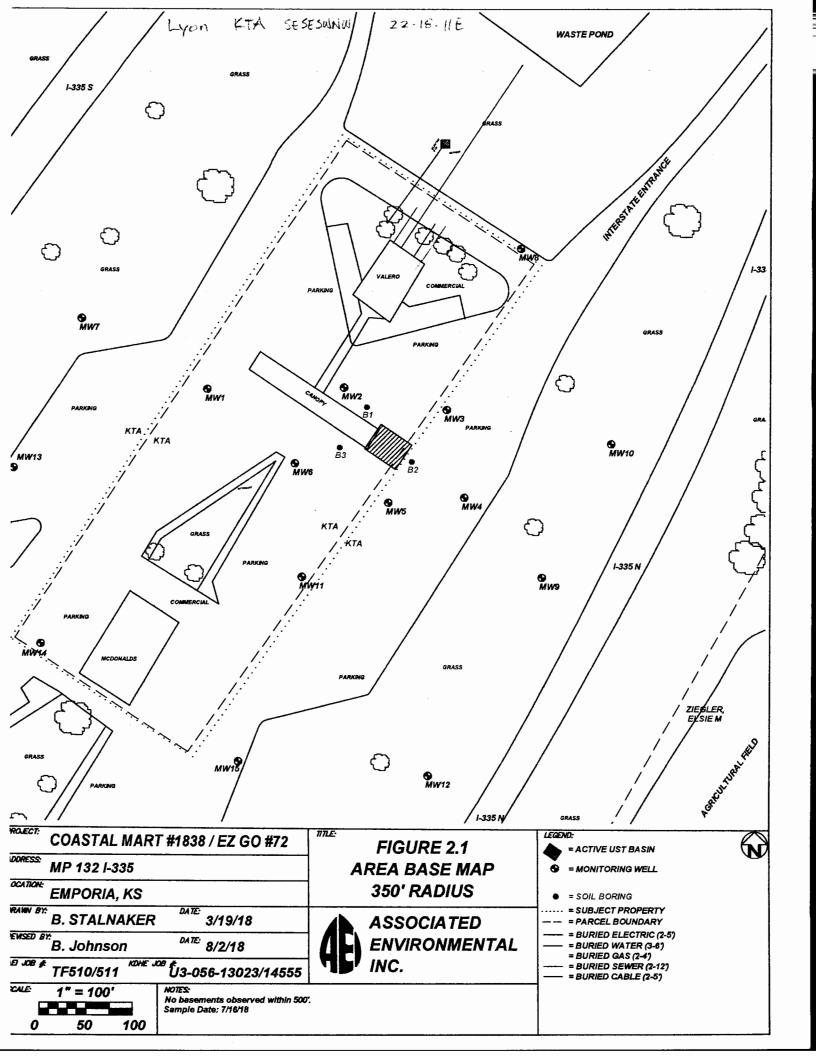

July 18, 2018

Associated Environmental, Inc.
Cole Roe
404 Pottawatomie
Manhattan, Kansas 66502
Email: cole_taylor@sbcglobal.com

RE:

Project No. 1807MN1182

Cole:

The following is the information requested on a Monitoring Well Site, Coastal Mart #1838 / EZ Go #72, Emporia, Lyon County, Kansas.

Point	North Coord.	East Coord.	Distance SE Cor. North	From S.22 West	Elev. Top Of Rim or PK Nail	Elev. Top of PVC Pipe	Latitude North	Longitude West
SE Corner S.22-T18S-R11E	5000	5000			· · · · · · · · · · · · · · · · · · ·	-		•
MW13	7711.75	753.17	2711.75	4246.83	1161.13	1160.81	38.47114	96.18570
MW14	7521.71	842.52	2521.71	4157.48	1162.88	1162.56	38.47056	96.18561
MW15	7439.63	1084.26	2439.62	3915.74	1162.25	1161.92	38.47014	96.18491
Site BM	7828.34	1112.26	2828.34	3887.74	BM Elevation = 1163.91			

BM Description: " \square " Square cut on southeast corner of eastern most pump island.

MW13 is in the:

SE¼ SE¼ SW¼ NW¼ S.22-T18S-R11E

MW14 is in the:

NE¼ NE¼ NW¼ SW¼ S.22-T18S-R11E

MW15 is in the:

NW¼ NW¼ NE¼ SW¼ S.22-T18S-R11E

If you have any questions, please do not hesitate in giving us a call. Sincerely,



Tim Sloan, L.S. SMH CONSULTANTS