
	ELL RECORD	Form '	WWC-5		ision of Water		mw-9	
	cord Correction		e in Well Use		urces App. No		- Well ID -	
	N OF WATER WE	LL:	Fraction		tion Number	Township Numb		
County: M			NEW NEW SWW					
2 WELL OWNER: Last Name: First: Street or Rural Address where well is located (if unknown, distance and								
	oop Grain & Supply	/		direction from nearest town or intersection): If at owner's address, check here:				
Address:	13 W. Main Street							
1	ehiah	State: KS	ZIP:					
3 LOCATE W	ARY T			40 -		20 272	50	
WITH "X"	IN 4 DEPT		IPLETED WELL: .		5 Latitude: 38.372' 50 (decimal degrees)			
SECTION E		Encountered: 1)		Longiti	Longitude: 97.30 30 (decimal degrees) Horizontal Datum: WGS 84 □ NAD 83 □ NAD 27			
N		2)						
	■ below	below land surface, measured on (mo-day-yr). Slla!				for Latitude/Longitude	ž:)	
NW 1			, measured on (mo-day-			(WAAS enabled?		
Pump test data: Well v			vater was fi	i.	Lan	■ Land Survey ☐ Topographic Map		
			s pumping		☐ Onl	☐ Online Mapper:		
SW	SE	vater was f						
Estimated Yield:			s pumping	gpm	6 Elevati	6 Elevation: .15.31ft. Ground Level TOC		
S Bore Hole Diameter:			8.75 in to 16	ft. and		Source: Land Survey GPS Topographic Map		
1 mile-	mile							
7 WELL WATER TO BE USED AS:								
1. Domestic:	5.	Public Wa	ater Supply: well ID		10. 🔲 Oil 1	Field Water Supply: 1	ease	
☐ Household			ig: how many wells?			ole: well ID		
ı —	☐ Lawn & Garden 7. ☐ Aquifer Re			N-0		☐ Cased ☐ Uncased ☐ Geotechnical		
	☐ Lawn & Garden ☐ Livestock 2. ☐ Irrigation 7. ☐ Aquifer Recharge: well ID				12. Geothermal: how many bores?			
			al Remediation: well IL e) Closed Loop		
4. Industrial		Recovery		Sanaction			ischarge 11 mj. of water	
Was a chemical/bacteriological sample submitted to KDHE? ☐ Yes ■ No If yes, date sample was submitted:								
8 TYPE OF CASING USED: PVC Other CASING JOINTS: Glued Clamped Welded Threaded								
Casing diameter								
Casing height above land surface								
TYPE OF SCREEN OR PERFORATION MATERIAL:								
☐ Steel ☐ Stainless Steel ☐ Fiberglass ■ PVC ☐ Other (Specify)								
☐ Brass ☐ Galvanized Steel ☐ Concrete tile ☐ None used (open hole)								
SCREEN OR PERFORATION OPENINGS ARE:								
☐ Continuous Slot								
☐ Louvered Shutter ☐ Key Punched ☐ Wire Wrapped ☐ Saw Cut ☐ None (Open Hole) SCREEN-PERFORATED INTERVALS: From								
GRAVEL PACK INTERVALS: From 4 ft. to 16 ft., From ft. to ft., From ft. to ft.								
9 GROUT MATERIAL: Neat cement Cement Grout Bentonite Other								
Grout Intervals: From								
Nearest source of possible contamination:								
☐ Septic Tank ☐ Lateral Lines ☐ Pit Privy ☐ Livestock Pens ☐ Insecticide Storage								
Sewer Lines Cess Pool Sewage Lagoon Fuel Storage Abandoned Water Well								
☐ Watertight Sewer Lines ☐ Seepage Pit ☐ Feedyard ☐ Fertilizer Storage ☐ Oil Well/Gas Well								
☐ Other (Specify) Direction from well?								
10 FROM	ТО	LITHOLO	GIC LOG	FROM			r PLUGGING INTERVALS	
0 15				11000			I LOGGING INTERVALS	
15 16				 				
- · · ·								
						· · · · · · · · · · · · · · · · · · ·		
				Notes:				
11 CONTRACTOR'S OR LANDOWNER'S CERTIFICATION: This water well was constructed, reconstructed, or plugged								
under my jurisdiction and was completed on (mo-day-year) 5-13-2019 and this record is true to the best of my knowledge and belief. Kansas Water Well Contractor's License No. 604 This Water Well Record was completed on (mo-day-year) (224.1.1)								
Kansas Water	well Contractor's Li	cense No. 5	riority Service, Inc.	iter Well Rec	ord was comp	pleted on imo-day-y	ear) 101.414.11	
Mail 1 wh	nite copy along with a fee	of \$5.00 for ea	ch constructed well to Kan	sas Denartment	of Health and F	vironment Rureau of W	/ater. GWTS Section	
Mail 1 white copy along with a fee of \$5.00 for each constructed well to: Kansas Department of Health and Environment, Bureau of Water, GWTS Section, 1000 SW Jackson St., Suite 420, Topeka, Kansas 66612-1367. Mail one to Water Well Owner and retain one for your records. Telephone 785-296-5524.								
Visit us at http://www.kdhcks.gov/waterwell/index.html KSA 82a-1212 Revised 7/10/2015								

Warion

27-14-KIE

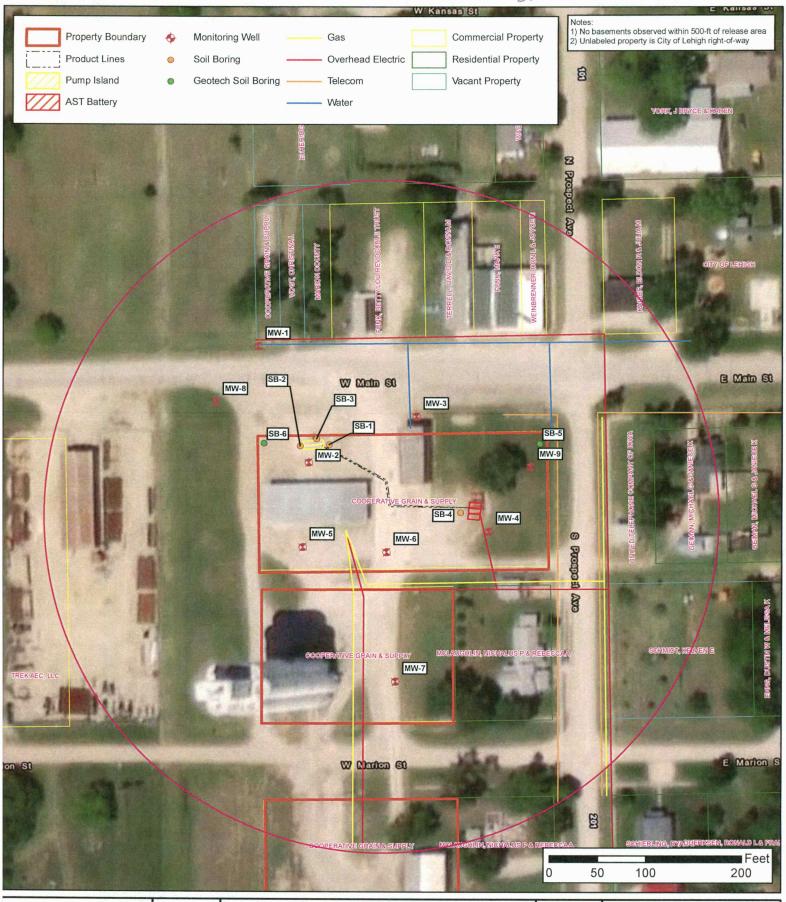

DESIGNED BY: CC

DRAWN BY: CC

CHECKED BY: RW

APPROVED BY: CC

DATE: JUNE 2019



Area Base Map (350-ft radius)
Cooperative Grain and Supply Co.



A5-057-40489 113 W. Main Street Lehigh, KS FIGURE

2.1

LSA Report