
WATER WELL RI	= -		ivision of Water		Wall MW-Z		
Original Record		e in Well Use		sources App. No.	TL. N	Well ID	
1 LOCATION OF WA	TER WELL:	Fraction SE 1/4 SW 1/4		ection Number 27	Township Number	er Range Number R 1 ■ E □ W	
County: Marion							
2 WELL OWNER: Last Name: First: Street or Rural Address where well is located (if unknown, distance and direction from nearest town or intersection): If at owner's address, check here:							
Address: 113 W. Main Street							
Address:							
City: Lehiah	State: KS	ZIP:					
3 LOCATE WELL 4 DEPTH OF COMPLETED WELL:16					38.37	213 (decimal degrees)	
WITH "X" IN	Donth(a) Groundwater Engagement 1)				Longitude: -97.3036 9 (decimal degrees)		
SECTION BOX:	ON BUA:				Horizontal Datum: WGS 84 NAD 83 NAD 27		
IN .	WELL'S STATIC WATER LEVEL: 1.71 ft.				Source for Latitude/Longitude:		
	, measured on (mo-day-	· · · · · · · · · · · · · · · · · · ·			)		
NW NE					(WAAS enabled? ☐ Yes ☐ No)		
X	Pump test data: Well water was				Land Survey Topographic Map		
W	Well water was ft.				Online Mapper:		
SW   SE	E   offer house number						
	Estimated Yield:			6 Elevation: 1530, 122  Ground Level To			
S	8.75 in to 16	ft. and Source: Land Survey GPS Topographic I					
mile		in. to	ft.		_ Other		
7 WELL WATER TO BE USED AS:							
1. Domestic:		ter Supply: well ID				ase	
☐ Lawn & Garden	Household 6. Dewatering: how many wells?				11. Test Hole: well ID Geotechnical		
· · · · · · · · · · · · · · · · · · ·	☐ Lawn & Garden 7. ☐ Aquifer Recharge: well ID			Case	12. Geothermal: how many bores?		
2. Irrigation					a) Closed Loop		
3. ☐ Feedlot ☐ Air Sparge ☐ Soil Vapor Extraction					b) Open Loop  Surface Discharge  Inj. of Water		
4. Industrial	☐ Recovery	☐ Injection		13. 🔲 Othe	r (specify):	•••••	
Was a chemical/bacteriological sample submitted to KDHE?  Yes No If yes, date sample was submitted:							
Water well disinfected? ☐ Yes ■ No							
8 TYPE OF CASING USED: ☐ Steel ■ PVC ☐ Other							
Casing diameter 2 in. to 6. ft., Diameter in. to ft., Diameter in. to ft.							
Casing height above land surface							
TYPE OF SCREEN OR PERFORATION MATERIAL:							
☐ Steel ☐ Stainless Steel ☐ Fiberglass ☐ PVC ☐ Other (Specify)							
SCREEN OR PERFORATION OPENINGS ARE:							
☐ Continuous Slot ■ Mill Slot ☐ Gauze Wrapped ☐ Torch Cut ☐ Drilled Holes ☐ Other (Specify)							
☐ Louvered Shutter ☐ Key Punched ☐ Wire Wrapped ☐ Saw Cut ☐ None (Open Hole)							
SCREEN-PERFORATE	D INTERVALS: From	1.6 ft. to .16	ft., From	ft. to	ft., From	ft. to ft.	
GRAVEL PACK INTERVALS: From							
9 GROUT MATERIAL: Neat cement Cement grout Bentonite Other							
Grout Intervals: From O ft. to ft., From ft., From ft., From ft., From ft., From ft.							
Nearest source of possible contamination:							
☐ Septic Tank ☐ Sewer Lines	☐ Lateral Line. ☐ Cess Pool	s ☐ Pit Privy ☐ Sewage Lag	_	Livestock Pens Fuel Storage		ide Storage	
☐ Sewer Lines ☐ Cess Pool ☐ Sewage Lagoon ☐ Fuel Storage ☐ Abandoned Water Well ☐ Watertight Sewer Lines ☐ Seepage Pit ☐ Feedyard ☐ Fertilizer Storage ☐ Oil Well/Gas Well							
Other (Specify)	1 0	,	••••		<del>-</del>	J Gus Wen	
Direction from well?		Distance from we	11?		ft.		
10 FROM TO	LITHOLOG	HC LOG	FROM	TO L	THO. LOG (cont.) or	PLUGGING INTERVALS	
	ravel, slight fuel odor	· · · · · · · · · · · · · · · · · · ·	<u> </u>		······································		
	o recovery	<del></del>	<u> </u>				
	av,tan, damp, diesel		ļ				
13 16 SI	nale, tan to gray, wea	athered	ļ <u>.</u>	<del>                                     </del>			
		<del></del>	<del> </del>	1			
			-				
Notes:							
11 CONTRACTORIS OR LANDOURIERIS OF PRINTICAL MICH.							
11 CONTRACTOR'S OR LANDOWNER'S CERTIFICATION: This water well was constructed, reconstructed, or plugged under my jurisdiction and was completed on (mo-day-year) 2-11-2019 and this record is true to the best of my knowledge and belief.							
Kansas Water Well Cont	ractor's License No. 6	04 Thic Wa	ter Well P	a uns record is t ecord was comp	iue to tile best of my leted on (mo-dav-ve	ar) 2/2//	
under the business name	of Environmental Pr	iority Service, Inc	S	Signature	A. Y. T.	· · · · · · · · · · · · · · · · · · ·	
Mail 1 white copy alon	g with a fee of \$5.00 for eac	h constructed well to: Kan	sas Departme	nt of Health and En	vironment, Bureau of Wa	ter, GWTS Section,	
	Suite 420, Topeka, Kansas				for your records. Telepho		
Visit us at http://www.kdh.cks.gov/waterwell/index.html KSA 82a-1212 Revised 7/10/2015							

Warion

27-14-KIE

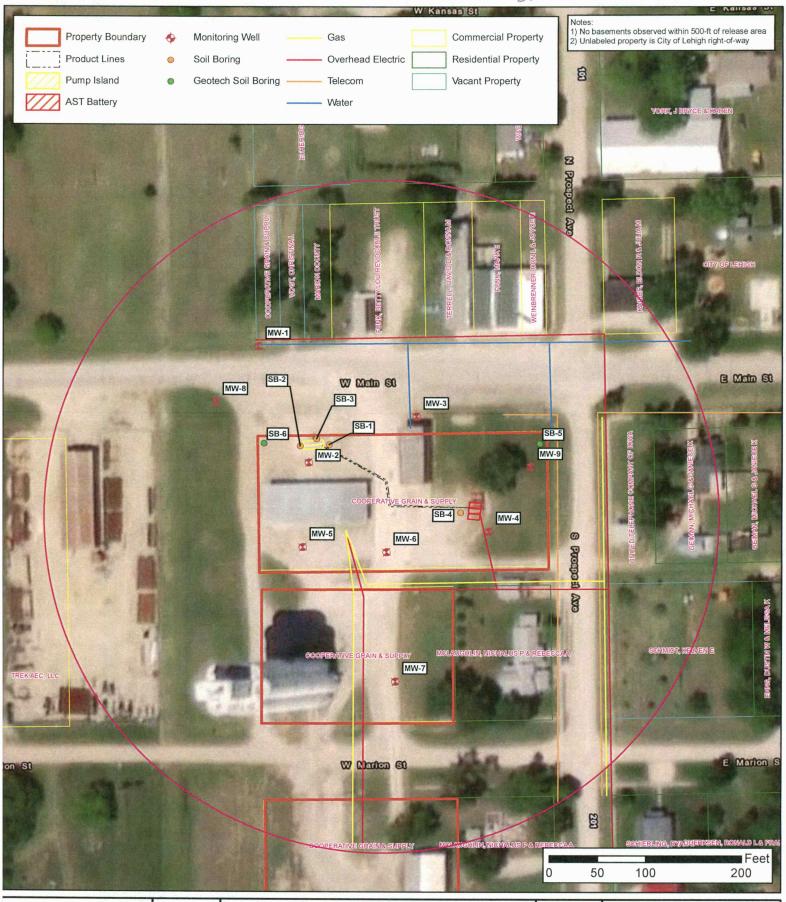

DESIGNED BY: CC

DRAWN BY: CC

CHECKED BY: RW

APPROVED BY: CC

DATE: JUNE 2019



Area Base Map (350-ft radius)
Cooperative Grain and Supply Co.



A5-057-40489 113 W. Main Street Lehigh, KS FIGURE

2.1

**LSA Report**