
WAIER WELL RI		WWC-5		vision of Water		Well ID mw-b		
Original Record LOCATION OF WA		e in Well Use Fraction		ources App. No.				
County: Marion	AIER WELL:	SE'4 NE 4 SW 4	I .	ction Number 27	Township Number T 19 S	Range Number R 1 ■ E □ W		
V —								
2 WELL OWNER: Last Name: First: Street or Rural Address where well is located (if unknown, distance and direction from nearest town or intersection): If at owner's address, check here:								
Address: 113 W. Main Street								
Address:								
City: Lehigh	State: KS	ZIP:			<u></u>			
3 LOCATE WELL	4 DEPTH OF COM	IPLETED WELL:	16 f	5 Latitud	38.37	206(decimal degrees)		
WITH "X" IN		Encountered: 1)		Longitude: -97.303(2.7 (decimal degrees)				
SECTION BOX:	SECTION BOX: 2)				Horizontal Datum: WGS 84 NAD 83 NAD 27			
WELL'S STATIC WATER LEVEL:				Source for Latitude/Longitude:				
	below land surface, measured on (mo-day-yr)				GPS (unit make/model:			
NW NE	above land surface, measured on (mo-day-yr).				· · · · · · · · · · · · · · · · · · ·			
				■ Land Survey ☐ Topographic Map				
W E				L Onli	Conline Mapper:			
SW SE	Well water was							
	Estimated Yield:gpm			6 Elevation:1.5.30>.2ft. ■ Ground Level □ TOC				
S	8.75 in to 16							
mile		in. to						
7 WELL WATER TO BE USED AS:								
1. Domestic:		ter Supply: well ID		10. 🔲 Oil F	ield Water Supply: leas	e		
☐ Household	6. Dewaterin	g: how many wells?			e: well ID			
☐ Lawn & Garden				☐ Cased ☐ Uncased ☐ Geotechnical				
				12. Geothermal: how many bores?				
2. Trigation 9. Environmental Remediation: well ID				a) Closed Loop ☐ Horizontal ☐ Vertical b) Open Loop ☐ Surface Discharge ☐ Inj. of Water				
3. Feedlot		Soil Vapor E	xtraction					
4. Industrial Recovery Injection 13. Other (specify):								
Was a chemical/bacteriological sample submitted to KDHE? Yes No If yes, date sample was submitted:								
Water well disinfected? ☐ Yes ■ No								
8 TYPE OF CASING USED: ☐ Steel ■ PVC ☐ Other								
Casing diameter 2 in to 6 ft., Diameter in to ft., Diameter in to ft., Diameter in to ft. Casing height above land surface 0 in Weight lbs/ft. Wall thickness or gauge No. Sch. 40								
TYPE OF SCREEN OR PERFORATION MATERIAL: □ Steel □ Fiberglass ■ PVC □ Other (Specify)								
☐ Steel ☐ Stainless Steel ☐ Fiberglass ☐ PVC ☐ Other (Specify)								
SCREEN OR PERFORATION OPENINGS ARE:								
☐ Continuous Slot								
☐ Louvered Shutter ☐ Key Punched ☐ Wire Wrapped ☐ Saw Cut ☐ None (Open Hole)								
SCREEN-PERFORATED INTERVALS: From 6 ft to ft From ft to ft From ft to ft								
GRAVEL PACK INTERVALS: From 4 ft. to 16 ft., From ft. to ft., From ft. to ft.								
9 GROUT MATERIAL: Neat cement Cement grout Bentonite Other								
Grout Intervals: FromQ								
Nearest source of possible contamination:								
Septic Tank	Lateral Line			Livestock Pens	☐ Insecticide			
Sewer Lines	Cess Pool	☐ Sewage Lag		Fuel Storage		d Water Well		
☐ Watertight Sewer Lines ☐ Seepage Pit ☐ Feedyard ☐ Fertilizer Storage ☐ Oil Well/Gas Well								
☐ Other (Specify) Direction from well? Distance from well? ft.								
10 FROM TO	LITHOLOG	CIC I OC	FROM			LUGGING INTERVALS		
	ravel & fill	JIO LOU	i KOW	10 LI	TITO. LOG (COIII.) OF PL	COOLING INTERVALS		
	lay, dark brown, mois	st plastic etropo	 					
	dor	אני הומפתרי פתחות	 					
	lay, tan to brown, mo	niet plaetic etrope	 		· · · · · · · · · · · · · · · · · · ·			
	dor	non piasuo, suony	 					
	nale, tan-gray, dry, w	reathered						
10 01	icio, tair gray, dry, W	Califored	Notes:	L				
Notes:								
11 CONTRACTOR'S OR LANDOWNER'S CERTIFICATION: This water well was constructed, reconstructed, or plugged								
under my jurisdiction and was completed on (mo-day-year) 2-11-2019 and this record is true to the best of my knowledge and belief.								
Kansas Water Well Contractor's License No. 994. This Water Well Record was completed on (mo-day-year)								
under the business name	of Environmental Pr	iority Service, Inc	Si	gnature J tz.	ma			
Mail 1 white copy along with a fee of \$5.00 for each constructed well to: Kansas Department of Health and Environment, Bureau of Water, GWTS Section, 1000 SW Jackson St., Suite 420, Topeka, Kansas 66612-1367. Mail one to Water Well Owner and retain one for your records. Telephone 785-296-5524.								
Visit us at http://www.kdheks.g	tov waterwell index.html	I	KSA 82a-12	12		Revised 7/10/2015		

Warion

27-14-KIE

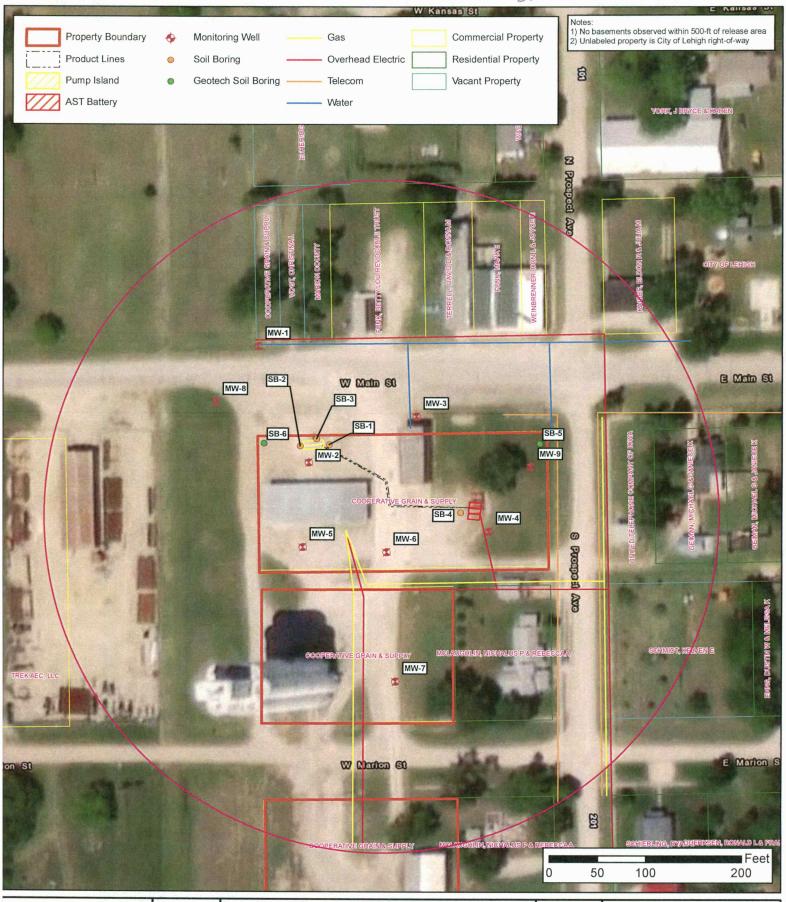

DESIGNED BY: CC

DRAWN BY: CC

CHECKED BY: RW

APPROVED BY: CC

DATE: JUNE 2019



Area Base Map (350-ft radius)
Cooperative Grain and Supply Co.



A5-057-40489 113 W. Main Street Lehigh, KS FIGURE

2.1

LSA Report