
WATER	R WELL F	RECORD	Form V	WWC-5	D	ivision of Wate	r	mw-8	
	al Record [e in Well Use	Re	sources App. N		Well ID	
		ATER WEI	LL:	Fraction	1	ection Number			
Count	y: Marion			STAN/4 NE 1/4 SW 1/2		27	T 19 S	R 1 BE W	
	OWNER:			First:				(if unknown, distance and	
Business: Coop Grain & Supply direction from nearest town or intersection): If at owner's address, check here:									
	Address: 113 W. Main Street Address:								
City: Lehigh State: KS ZIP:									
3 LOCAT									
WITH					ETED WELL: 16 ft. 5 Latitude: 38.37 211 (decim			(decimal degrees)	
1	ON BOX:			Encountered: 1)			Longitude: -97.30' 409 (decimal degrees)		
	N			3) ft or 4) [4 □ NAD 83 □ NAD 27	
below land surface,				TER LEVEL			Source for Latitude/Longitude:		
) h							GPS (unit make/model:		
\w-	Pump test data: Well w						Land Survey Topographic Marie		
l whether				pumping			Online Mapper:		
CIV	Well w			ter was ft.					
SW	SW SE after hours			pumping	gpm	6 Florest	ion 1579 7 6	Ground Lovel D TOC	
L	Estimated Yield:			gpm			6 Elevation: 1529.25.ft. ☐ Ground Level ☐ TOC Source: ☐ Land Survey ☐ GPS ☐ Topographic Map		
mile (f. Other									
1. Domestic				tor Cumbic wall ID		10 🗆 00	Field Water Supply: I	ence	
☐ House		ter Supply: well ID g: how many wells?			10. Oil Field Water Supply: lease				
				charge: well ID		. II. Test I	☐ Cased ☐ Uncased ☐ Geotechnical		
. —	☐ Lawn & Garden 7. ☐ Aquifer Re ☐ Livestock 8. ■ Monitoring				N-8	. 12. Geoth	ermal: how many bores		
2. 🗌 Irrigation 9. Environmenta				Remediation: well ID					
3. Feedlot Air Sparge					☐ Soil Vapor Extraction b) Open Loop ☐ Surface Discharge ☐ Inj. of				
4. 🔲 Indust	rial		Recovery	☐ Injection		13. 🔲 Otl	ner (specify):		
Was a chemical/bacteriological sample submitted to KDHE? ☐ Yes ■ No If yes, date sample was submitted:									
Water well disinfected? Tives No									
8 TYPE OF CASING USED: Steel PVC Other CASING JOINTS: Glued Clamped Welded Threaded									
Casing diameter 2 in to 6 ft., Diameter in to ft., Diameter in to ft., Diameter in to ft. Casing height above land surface 0 in Weight lbs/ft. Wall thickness or gauge No. Sch 40									
Casing height above land surface									
TYPE OF SCREEN OR PERFORATION MATERIAL:									
☐ Steel ☐ Stainless Steel ☐ Fiberglass ☐ PVC ☐ Other (Specify)									
☐ Brass ☐ Galvanized Steel ☐ Concrete tile ☐ None used Open hole) SCREEN OR PERFORATION OPENINGS ARE:									
☐ Continuous Slot									
Louvered Shutter Key Punched Wire Wrapped Saw Cut None (Open Hole)									
SCREEN-PERFORATED INTERVALS: From .6									
GRAVEL PACK INTERVALS: From 4 ft. to 16 ft., From ft. to ft., From ft. to ft.									
9 GROUT MATERIAL: Neat cement Cement grout Bentonite Other									
Grout Intervals: From . Q									
Nearest source of possible contamination:									
Septic Tank Lateral Lines Pit Privy Livestock Pens Insecticide Storage									
Sewer			Cess Pool	☐ Sewage La		Fuel Storage		oned Water Well	
☐ Watertight Sewer Lines ☐ Seepage Pit ☐ Feedyard ☐ Fertilizer Storage ☐ Oil Well/Gas Well									
☐ Other (Specify) Direction from well?									
10 FROM	TO		ITHOLOG		FROM			PLUGGING INTERVALS	
0				sandy clay loam,	1 KOW	+ 10 +	ETTIO. LOG (coll.) of	FEOGGING INTERVALS	
		noist, no od		Sandy Clay Idam,	 -	++			
1				noist, plastic, no	+	 			
·	+ · · · · · · · · · · · · · · · · · · ·	odor	to black, i	noist, plastic, no		+			
7			low moist	, slity, plastic, no		 			
	 	odor	iow, moisi	, only, plastic, no	 	+			
13			vellow si	lty, weathered, no	Notes:	<u> </u>			
		odor	YCHOW, SI	ity, weathered, no	- 110163.				
									
11 CONTRACTOR'S OR LANDOWNER'S CERTIFICATION: This water well was constructed, reconstructed, or plugged									
under my jurisdiction and was completed on (mo-day-year) 2-11-2019 and this record is true to the best of my knowledge and belief									
Kansas Wa	iter Well Co	itractor's Lice	ense No. 6	04 This Wa	ater Well Re	ecord was com	pleted on (mo-day-ve	ear) 2/21/17	
under the b	usiness nam	e of ⊫nviron	mental Pr	ionity Service. Inc.		SignatureT	A M		
Mail 1 white copy along with a fee of \$5.00 for each constructed well to: Kansas Department of Health and Environment, Bureau of Water, GWTS Section, 1000 SW Jackson St., Suite 420, Topeka, Kansas 66612-1367. Mail one to Water Well Owner and retain one for your records. Telephone 785-296-5524.									
				56612-1367. Mail one to			e for your records. Teleph		
visit us at hit	p://www.kdhek.	gov waterwell i	ndex.html		KSA 82a-1	414		Revised 7/10/2015	

Warion

27-14-KIE

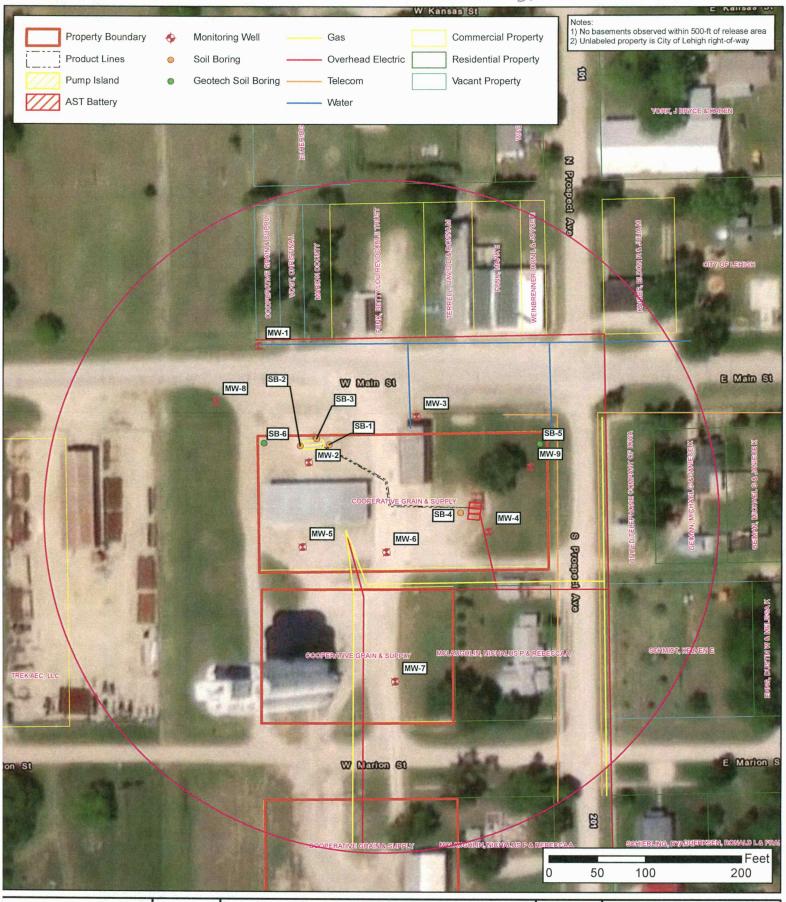

DESIGNED BY: CC

DRAWN BY: CC

CHECKED BY: RW

APPROVED BY: CC

DATE: JUNE 2019



Area Base Map (350-ft radius)
Cooperative Grain and Supply Co.



A5-057-40489 113 W. Main Street Lehigh, KS FIGURE

2.1

LSA Report