

WATER WELL RECORD Form WWC-5

Original Record Correction Change in Well Use

Division of Water Resources App. No.

Well ID

1 LOCATION OF WATER WELL: County: Lyon	Fraction SW ¼ SE ¼ SE ¼ NW ¼	Section Number 10	Township Number T 19 S	Range Number R 11 <input checked="" type="checkbox"/> E <input type="checkbox"/> W
--	---------------------------------	----------------------	---------------------------	---

2 WELL OWNER: Last Name: First: Business: Chevron Environmental Management Company Address: 4800 Fournace Place City: Bellaire State: TX ZIP: 77401	Street or Rural Address where well is located (if unknown, distance and direction from nearest town or intersection): If at owner's address, check here: <input type="checkbox"/> Former Chevron Station (CVS Pharmacy #10294) 12th and Merchant St. Emporia, KS 66801
---	--

3 LOCATE WELL WITH "X" IN SECTION BOX:
N

NW	NE
SW	SE

S
1 mile

4 DEPTH OF COMPLETED WELL:24..... ft.
Depth(s) Groundwater Encountered: 1) ft.
2) ft. 3) ft., or 4) Dry Well
WELL'S STATIC WATER LEVEL:12.13..... ft.
 below land surface, measured on (mo-day-yr).....
 above land surface, measured on (mo-day-yr).....
Pump test data: Well water was ft.
after..... hours pumping gpm
Well water was ft.
after..... hours pumping gpm
Estimated Yield: gpm
Bore Hole Diameter: 8.25 in. to 24.0 ft. and
..... in. to ft.

5 Latitude:38.41250.....(decimal degrees)
Longitude:96.18238.....(decimal degrees)
Horizontal Datum: WGS 84 NAD 83 NAD 27
Source for Latitude/Longitude:
 GPS (unit make/model:)
(WAAS enabled? Yes No)
 Land Survey Topographic Map
 Online Mapper:

6 Elevation: 1165.35 ft. Ground Level TOC
Source: Land Survey GPS Topographic Map
 Other

7 WELL WATER TO BE USED AS:

1. Domestic: <input type="checkbox"/> Household <input type="checkbox"/> Lawn & Garden <input type="checkbox"/> Livestock	5. <input type="checkbox"/> Public Water Supply: well ID	10. <input type="checkbox"/> Oil Field Water Supply: lease
2. <input type="checkbox"/> Irrigation	6. <input type="checkbox"/> Dewatering: how many wells?	11. Test Hole: well ID
3. <input type="checkbox"/> Feedlot	7. <input type="checkbox"/> Aquifer Recharge: well ID	<input type="checkbox"/> Cased <input type="checkbox"/> Uncased <input type="checkbox"/> Geotechnical
4. <input type="checkbox"/> Industrial	8. <input checked="" type="checkbox"/> Monitoring: well ID MW-3	12. Geothermal: how many bores?
	9. Environmental Remediation: well ID	a) Closed Loop <input type="checkbox"/> Horizontal <input type="checkbox"/> Vertical
	<input type="checkbox"/> Air Sparge <input type="checkbox"/> Soil Vapor Extraction	b) Open Loop <input type="checkbox"/> Surface Discharge <input type="checkbox"/> Inj. of Water
	<input type="checkbox"/> Recovery <input type="checkbox"/> Injection	13. <input type="checkbox"/> Other (specify):


Was a chemical/bacteriological sample submitted to KDHE? Yes No If yes, date sample was submitted:
Water well disinfected? Yes No

8 TYPE OF CASING USED: Steel PVC Other CASING JOINTS: Glued Clamped Welded Threaded
Casing diameter2..... in. to9..... ft., Diameter in. to ft., Diameter in. to ft.
Casing height above land surface0..... in. Weight lbs./ft. Wall thickness or gauge No. Sched. 40
TYPE OF SCREEN OR PERFORATION MATERIAL:
 Steel Stainless Steel Fiberglass PVC Other (Specify)
 Brass Galvanized Steel Concrete tile None used (open hole)
SCREEN OR PERFORATION OPENINGS ARE:
 Continuous Slot Mill Slot Gauze Wrapped Torch Cut Drilled Holes Other (Specify)
 Louvered Shutter Key Punched Wire Wrapped Saw Cut None (Open Hole)
SCREEN-PERFORATED INTERVALS: From .9..... ft. to 24..... ft., From ft. to ft., From ft. to ft.
GRAVEL PACK INTERVALS: From 7..... ft. to 24..... ft., From ft. to ft., From ft. to ft.


9 GROUT MATERIAL: Neat cement Cement grout Bentonite Other
Grout Intervals: From 2..... ft. to 7..... ft., From ft. to ft., From ft. to ft.
Nearest source of possible contamination:
 Septic Tank Lateral Lines Pit Privy Livestock Pens Insecticide Storage
 Sewer Lines Cess Pool Sewage Lagoon Fuel Storage Abandoned Water Well
 Watertight Sewer Lines Seepage Pit Feedyard Fertilizer Storage Oil Well/Gas Well
 Other (Specify)
Direction from well? East Distance from well? 125..... ft.

10 FROM	TO	LITHOLOGIC LOG	FROM	TO	LITHO. LOG (cont.) or PLUGGING INTERVALS
0	5	Air knifed no description available			
5	10	Silty clay, gray to brown, fat damp, no odor			
10	19	Silty clay, brown to gray, fat with interbedded shale/limestone fragments and organic matter, damp, no odor			
19	24	Shale bedrock			
Notes:					

11 CONTRACTOR'S OR LANDOWNER'S CERTIFICATION: This water well was constructed, reconstructed, or plugged under my jurisdiction and was completed on (mo-day-year) 2-28-2017..... and this record is true to the best of my knowledge and belief. Kansas Water Well Contractor's License No. 759..... This Water Well Record was completed on (mo-day-year) 3-30-2017..... under the business name of RAZEK Environmental, LLC..... Signature *[Signature]*

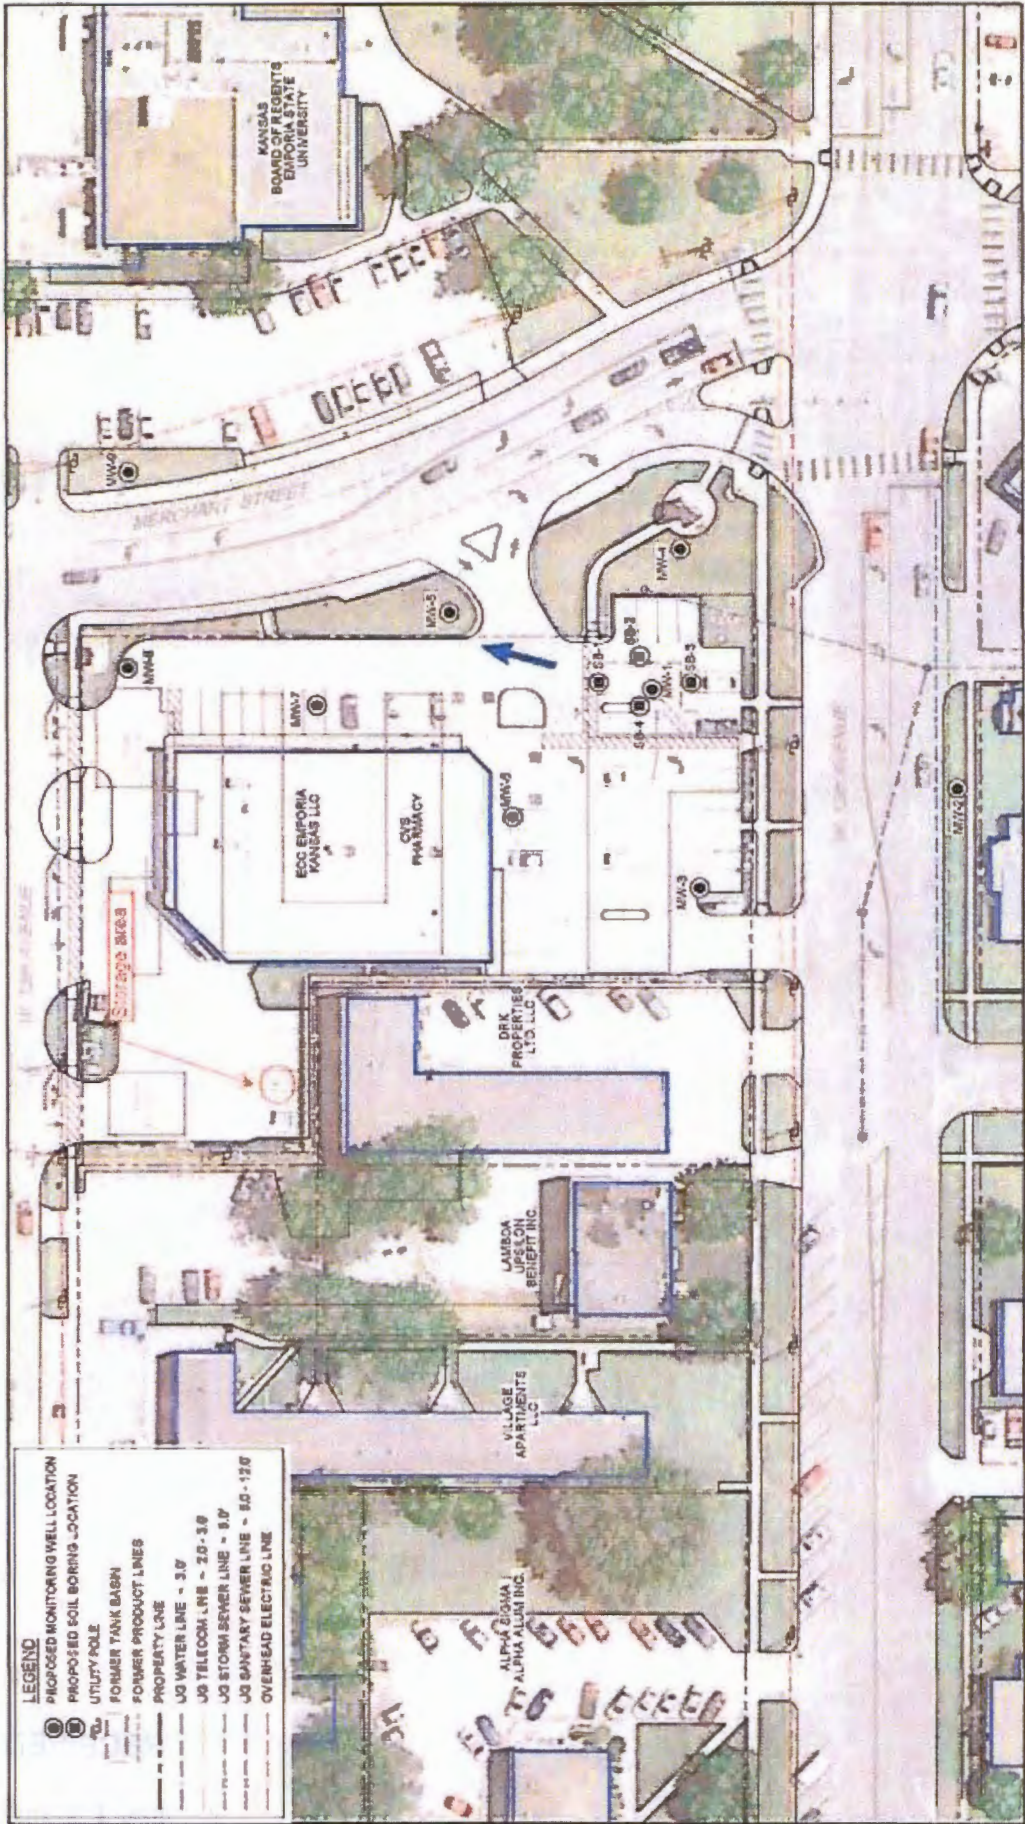

- LEGEND**
- PROPOSED MONITORING WELL LOCATION
 - PROPOSED SOIL BORING LOCATION
 - UTILITY POLE
 - FORMER TANK BASIN
 - POWER PRODUCT LINES
 - PROPERTY LINE
 - UG WATER LINE - 3.0'
 - UG TELECOM LINE - 2.0 - 3.0'
 - UG STORM SEWER LINE - 8.0'
 - UG SANITARY SEWER LINE - 8.0 - 12.0'
 - OVERHEAD ELECTRIC LINE

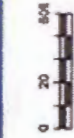

© 2016 GHD. ALL RIGHTS RESERVED. THIS DOCUMENT IS THE PROPERTY OF GHD AND IS NOT TO BE REPRODUCED OR TRANSMITTED IN ANY FORM OR BY ANY MEANS, ELECTRONIC OR MECHANICAL, WITHOUT THE WRITTEN PERMISSION OF GHD.



CVS PHARMACY STORE #10294
 (CHEVRON #373504) US-058-14815
 12th AVENUE & MERCHANT STREET, EMPORIA, KANSAS

SITE PLAN *Lyon County*

11100402
 May 17, 2016

Figure 2