

WATER WELL RECORD Form WWC-5

Division of Water Resources App. No.

[]


MW1R

Original Record [] Correction [] Change in Well Use []

Well ID

1 LOCATION OF WATER WELL: County: LYON Fraction NW 1/4 NE 1/4 SE 1/4 SW 1/4 Section Number 5 Township Number T 19 S Range Number R 11 E W

2 WELL OWNER: Last Name: MILLER First: GRADY Business: SUNSHINE FUELS Address: 95 N. COUNTRY RD. City: PALM BEACH State: FL ZIP: 33480 Street or Rural Address where well is located: 2900 EAGLE CREST, EMPORIA KS

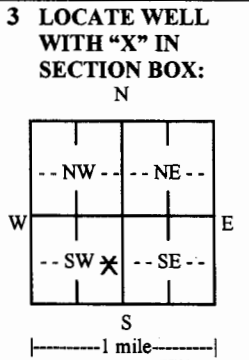

3 LOCATE WELL WITH 'X' IN SECTION BOX: N W E S 1 mile
4 DEPTH OF COMPLETED WELL: 15 ft. Depth(s) Groundwater Encountered: 1) 5 ft. 2) ... ft. 3) ... ft., or 4) Dry Well
WELL'S STATIC WATER LEVEL: 6.97 ft. below land surface, measured on (mo-day-yr) (4/22/19)
Pump test data: Well water was ... ft. after ... hours pumping ... gpm
Estimated Yield: ... gpm Bore Hole Diameter: 8.5 in. to 15 ft. and ... in. to ... ft.

5 Latitude: 38.42233 (decimal degrees) Longitude: 96.21831 (decimal degrees) Horizontal Datum: WGS 84 NAD 83 NAD 27 Source for Latitude/Longitude: GPS (unit make/model: ... (WAAS enabled? Yes No) Land Survey Topographic Map Online Mapper: ...

6 Elevation: 1198.13 ft. Ground Level TOC Source: Land Survey GPS Topographic Map Other

7 WELL WATER TO BE USED AS: 1. Domestic: Household Lawn & Garden Livestock Irrigation Feedlot Industrial 2. Public Water Supply: well ID Dewatering: how many wells? Aquifer Recharge: well ID Monitoring: well ID MW1R Environmental Remediation: well ID Air Sparge Soil Vapor Extraction Recovery Injection Oil Field Water Supply: lease Test Hole: well ID Cased Uncased Geotechnical Geothermal: how many bores? a) Closed Loop Horizontal Vertical b) Open Loop Surface Discharge Inj. of Water Other (specify):

Was a chemical/bacteriological sample submitted to KDHE? Yes No If yes, date sample was submitted: Water well disinfected? Yes No

8 TYPE OF CASING USED: Steel PVC Other CASING JOINTS: Glued Clamped Welded Threaded Casing diameter 2 in. to 5 ft., Diameter in. to ... ft., Diameter in. to ... ft. Casing height above land surface in. Weight lbs./ft. Wall thickness or gauge No. 40

TYPE OF SCREEN OR PERFORATION MATERIAL: Steel Stainless Steel Fiberglass PVC Other (Specify) Brass Galvanized Steel Concrete tile None used (open hole)

SCREEN OR PERFORATION OPENINGS ARE: Continuous Slot Mill Slot Gauze Wrapped Torch Cut Drilled Holes Other (Specify) Louvered Shutter Key Punched Wire Wrapped Saw Cut None (Open Hole)


SCREEN-PERFORATED INTERVALS: From 5 ft. to 15 ft., From ... ft. to ... ft. GRAVEL PACK INTERVALS: From 4 ft. to 15 ft., From ... ft. to ... ft.

9 GROUT MATERIAL: Neat cement Cement grout Bentonite Other Concrete Surface Completion 0-1 Grout Intervals: From 1 ft. to 4 ft., From ... ft. to ... ft.

Nearest source of possible contamination: Septic Tank Lateral Lines Pit Privy Livestock Pens Insecticide Storage Sewer Lines Cess Pool Sewage Lagoon Fuel Storage Abandoned Water Well Watertight Sewer Lines Seepage Pit Feedyard Fertilizer Storage Oil Well/Gas Well Other (Specify) Direction from well? NORTHEAST Distance from well? 600 (SHORT STOP #13) ft.

Table with columns: FROM, TO, LITHOLOGIC LOG, FROM, TO, LITHO. LOG (cont.) or PLUGGING INTERVALS. Rows: 0 to 0.5 CONCRETE, 0.5 to 15 SILTY CLAY. Includes Notes: U3-056-13793-13406


11 CONTRACTOR'S OR LANDOWNER'S CERTIFICATION: This water well was constructed reconstructed, or plugged under my jurisdiction and was completed on (mo-day-year) 4/22/19 and this record is true to the best of my knowledge and belief. Kansas Water Well Contractor's License No. 585 This Water Well Record was completed on (mo-day-year) 5/7/19 under the business name of ASSOCIATED ENVIRONMENTAL INC. Signature

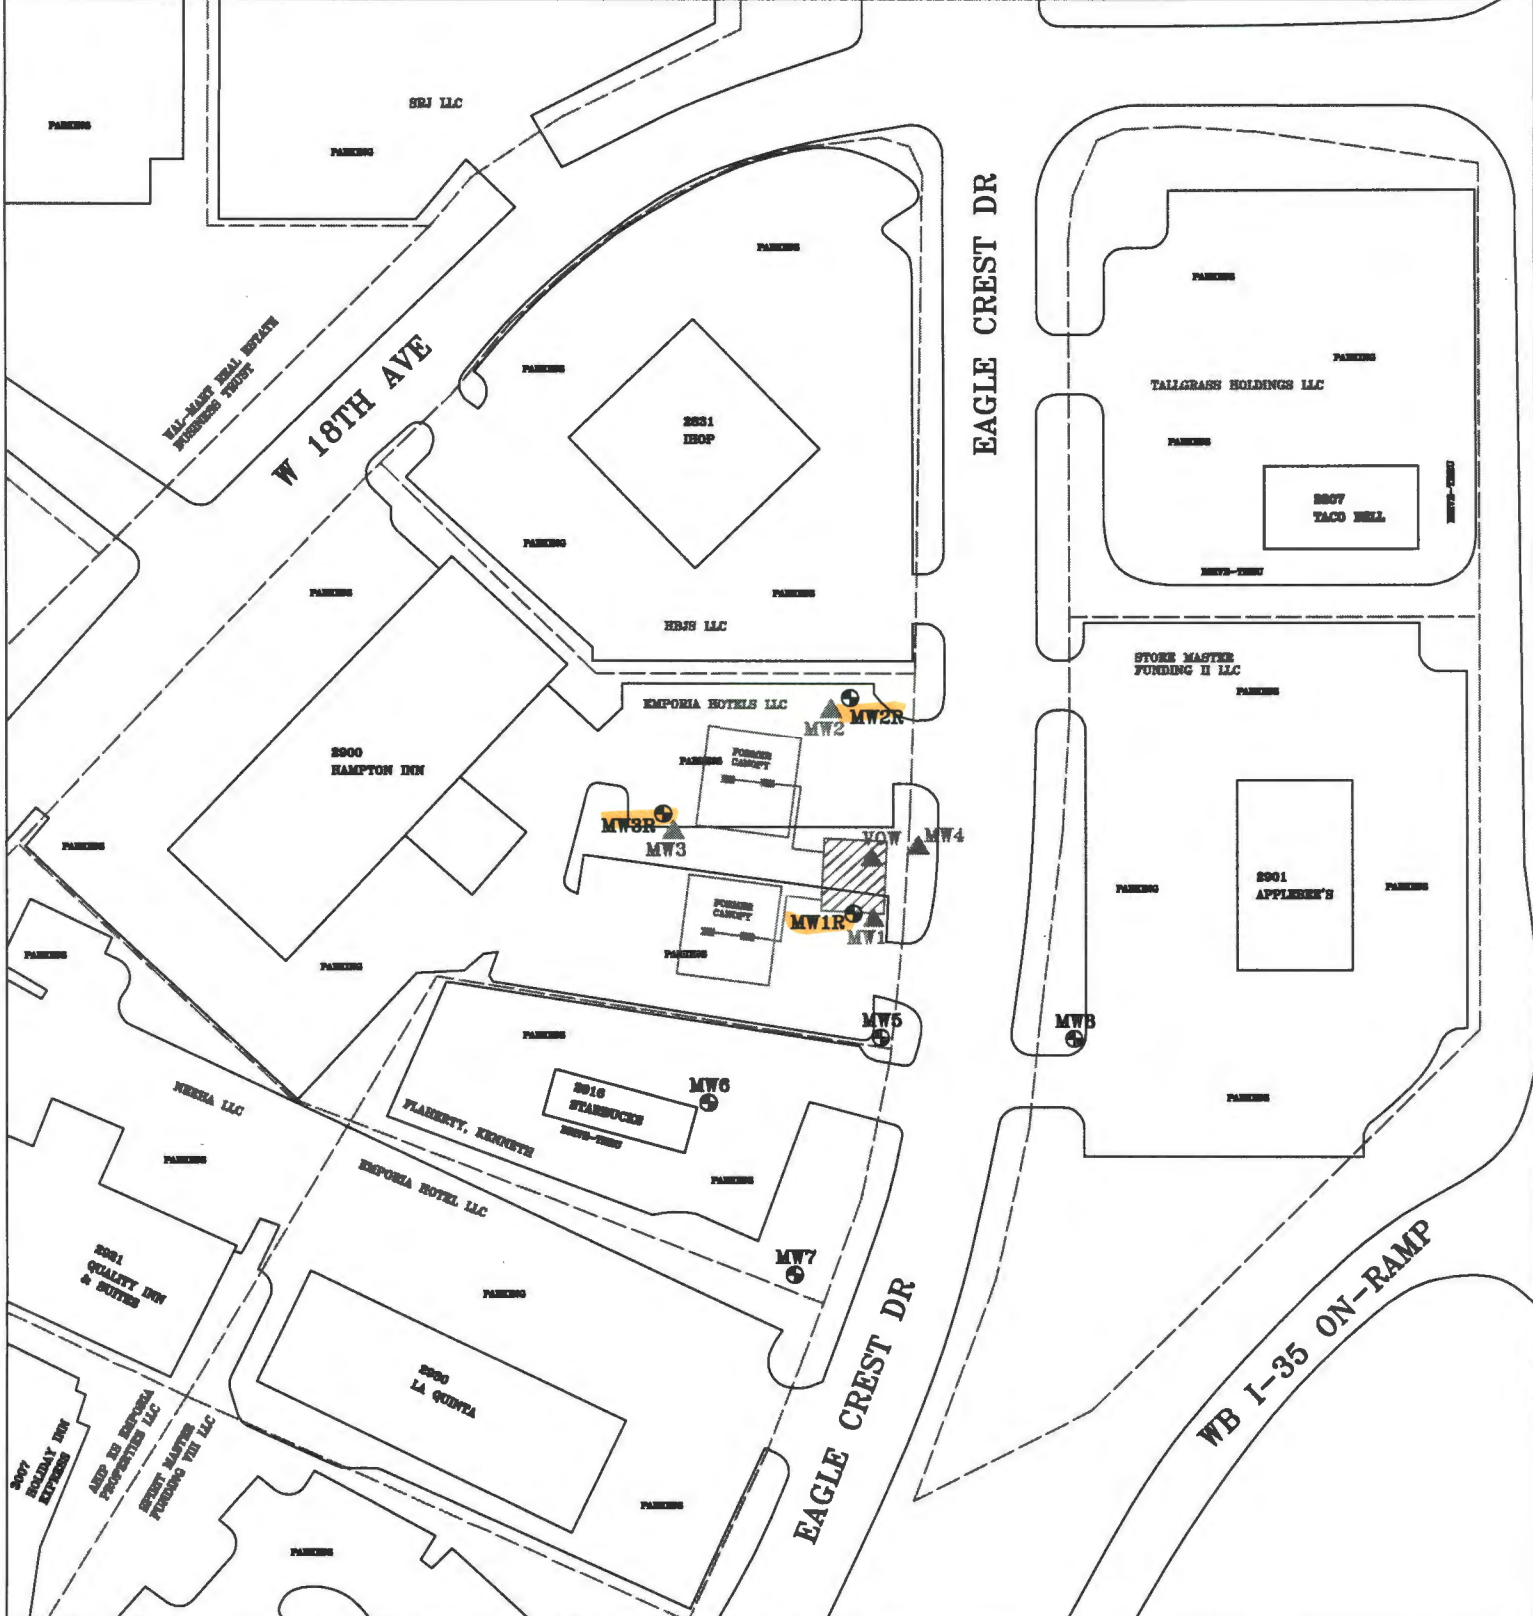

PROJECT: SHELL FOOD MART/TEXACO FOODMART
 ADDRESS: 2900 EAGLE CREST
 LOCATION: EMPORIA, KS
 DRAWN BY: C. ROE DATE: 10/3/18
 REVISED BY: C. ROE DATE: 4/29/19
 AEI JOB #: TF367 KOHE JOB #: U3-056-13406

TITLE:
 ASSOCIATED ENVIRONMENTAL INC.

- LEGEND:
- = FORMER UST BASIN
 - = FORMER DISPENSER & PRODUCT LINES
 - = MONITORING WELL
 - = PLUGGED MONITORING WELL

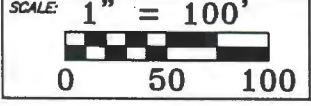

NOTES:

