
WATER WELL RECORD Form WWC-5								Div	ision of Water		7	7 57710	
X			Correction		ige in Well Ust			Reso	urces App. No.		Well ID	MW8	
1	LOCATION OF V	NATE	ER WELL	<b>,:</b>	Fraction NE 1/4	SE ¼	NE !	4 SE 1/4	1	er Township Nu T 19	mber Range S R 1	Number 4 X E W	
2	WELL OWNER:	Last N	ame:		First:	3L /4			<u> </u>	ell is located (if un	i		
	Business: Casey's Retail Company						from nearest town or intersection): If at owner's address, check here:						
	Address: PO Box 3004 Address:							2740 Fauna Road, Lebo, KS					
		keny		ate: IA	ZIP: 500								
3	LOCATE WELL		4 D	EPTH OF	COMPLETED	WELL:	15.5	ft	5 Latitude:		447 (de	cimal degrees)	
	WITH "X" IN SECTION BOX:		Depth(s)	Groundwa (	iter Encountered	: 1) 1	Der Wal	ft	Longitude	95.85 Datum X WGS		cimal degrees)	
	N		WELL'S	STATIC V	3)ft, VATER LEVEL	: 4.8	Biy wei	t.		Latitude/Longitud		33 NAD 21	
	X below land surface, measured on (mo-d							/-yr) 3/7/23 GPS (unit make/model: )					
1  -	NW NE above land surface, measured on (mo-co						y-yr)	(WAAS enabled? Yes No)					
	Pump test data: Well water was  afterhours pumping												
W		⊢ E	"	,	Water well was	S	gpm ft			: iviappei			
_	- SW SE	X	afi	ter	hours pumping	<u>;</u>	gpm		6 Elevation	***********			
			Estim	ated Yield:	gpn	n · .	0		Source X	Land Survey		Topographic Map	
-			Bore I	Hole Diame	eter: 7.25	in to	It, an	ď		Other	••••••	••••••	
	1 mile				***************************************		······· ^` 						
7 WELL WATER TO BE USED AS: 1 Domestic: 5 Public Water Supply: well ID 10 Oil Field Water Supply: lease													
	Household				how many wells				Test Hole: wel		se		
	Lawn & Garden				narge: well ID			•		Uncased	Geotechnic	al	
	Livestock 8 X Monitoring: well ID MW8							12 Geothermal: How many bores?					
	2 Irrigation 9 Environmental Remediation: well ID 3 Feedlot Air Sparge Soil Vapor Extrac							a) Closed Loop Horizontal Vertical ior b) Open Loop Surface Discharge Inj. of Water					
4	Industrial		==	ir Sparge ecovery	Injection	apor Extracti	ior		b) Open Loop		Discharge	Inj. of Water	
Was a chemical/bacteriological sample submitted to KDHE? Yes X No If yes, date sample was submitted:  Water well disinfected? Yes X No													
8 TYPE OF CASING USED: Steel X PVC Other CASING JOINTS: Glued Clampled Welded X Threaded													
Casing diameter 2 in. to 3.5 ft, Diameter in. to ft, Diameter in. to ft,  Casing height above land surface -0.49 in. Weight lbs./ft. Well thickness or gauge No													
TYP	TYPE OF SCREEN OR PERFORATION MATERIAL:												
Steel Stainless Steel Fiberglass X PVC Other (Specify)													
	J	nized S	· · · · · · · · · · · · · · · · · · ·	Concrete	tile Nor	ne used (oper	n hole)						
SCR	EEN OR PERFORA Continuous Slot		OPENING		auze Wrapped	Пт	-l- C-4	Drille					
	Louvered Shutter	Ĥ ĸ	nn Siot ev Punched	H.	ire Wranned				(Open Hole)	Other (Specif	y <u>)</u>		
SCRE	EN-PERFORATED	INTER	VALS: F	rom 5.5	ft. to 1	5.5 ft,	From	ft.	to	ft, From	ft. to	ft,	
	GRAVEL PACK II	VTER'	VALS: F	rom 3.5	ft. to1	5.5 ft,	From	ft.	to	ft, From	ft. to	ft,	
1	ROUT MATERIAL:		Neat ceme	ent	Cement grout		tonite	X Other	Concrete: 0-1'	•••••			
1	intervals: From	1		3.5 ft,	From	ft. to	***************************************	ft, Fron	nft.	toft,			
Neare	est source of possibl Septic Tank	e cont		ı: ıteral Lines	□ p;	Privy			tock Pens	Tu an atiair	. C4		
	Sewer Lines			ess Pool	<del>  </del>	vage Lagoon	1		Storage	Insecticion Abandon	e Storage ed Water Well		
	Watertight Sewer Lin	es		epage Pit		dyard	•		izer Storage		Gas Well		
	Other (Specity)						•••••		Ü	<b>1</b>			
	on from well? SW				***************************************	ance from v	vell?	90		ft			
	ROM TO 0 15.5	Cile	andri dada	LITHOI	LOGIC LOG			FROM	TO		ont.) or PLUGGIN	IG INTERVALS	
<u> </u>	0 13.3	Sitty, S	sandy shale					······································					
		<u> </u>											
										#3919; U3-016-15			
								-	-	hallow groundwat		was installed at	
the direction of KDHE.  CONTRACTOR'S OR LANDOWNER'S CERTIFICATION: This water well was X constructed, or plugged under my													
jur	isdiction and was comp	oleted o	n (mo-day-	year)	2/10/23 and	this record i	is true to	the best of	my knowledge a				
License No. 757 This Water Well Record was completed on (mo-day-year) 3/13/23 under the business name of Larsen & Associates, Inc. Signature													
Mail 1 white copy along with a fee of \$5.00 for each constructed well to: Kansas Department of Health and Environment, Bureau of Water, GWTS Section,													
										ur records. Telephor			
L	Visit us at http://www.kd	heks.go	v/waterwell/i	index.html		KSA 82a	ı-1212				Revised	17/10/2015	

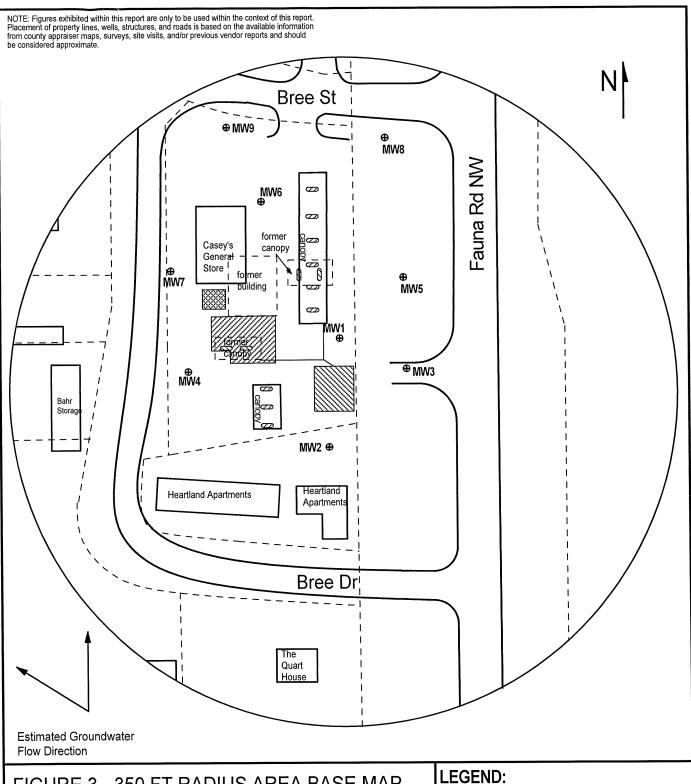

## FIGURE 3 - 350 FT RADIUS AREA BASE MAP



1311 E 25th St., Suite B Lawrence, KS 66046

(785) 841-8707 office (785) 865-4282 fax

## **PROJECT**:

Casey's #3919 2740 Fauna Road Lebo, KS KDHE ID: U3-016-15345 Date: 3/7/23

100 ft

Approximate Location of Active Approximate Location of Acti UST Basin and Pump Island

Approximate Location of Former UST Basin, Product Lines, and Pump Island

Approximate Location of Former Waste Oil UST Basin

 New Monitoring Well (Installed 1/23/23 & 2/8-10/23)

NOTE: Utility depths and locations are approximate.