
WATER WELL RECOR		Division of Water Resources App. No. Well ID MW12
	Correction Change in Well Ust	Nesset ees 7,pp. 76
1 LOCATION OF WATE County Linn		Section Number Township Number Range Number  E ¼ NW ¼ 31 T 21 S R 25 X E W
County Linn  WELL OWNER: Last Na		Street or Rural Address where well is located (if unknown, distance and direction
Business: Pete's Corporation from nearest town or intersection): If at owner's address, check here:		
Address: 1712 Broadway		Holly St, Pleasanton, KS
Address: PO Box 876		
City Parsons	State: KS ZIP: 67357	15 ft 5 Latitude: 38.18041 (decimal degrees)
3 LOCATE WELL WITH "X" IN	4 DEPTH OF COMPLETED WELL: Depth(s) Groundwater Encountered: 1)	
SECTION BOX:	2) ft 3) ft, or 4) Dry	
N SECTION BOX.	WELL'S STATIC WATER LEVEL: 4.40	ft. Source for Latitude/Longitude:
	X below land surface, measured on (mo-day-yr	
NW X NE	above land surface, measured on (mo-day-yr	r) (WAAS enabled? Yes No)
	Pump test data: Well water was	ft X Land Survey Topographic Map
w E	, , , , , , , , , , , , , , , , , , , ,	gpm Online Mapper
	Water well was afterhours pumping	fi gpm 6 Elevation 851.60 ft Ground Level X TOC
SW — SE —	Estimated Yield:gpm	Source X Land Survey GPS Topographic Map
	Bore Hole Diameter: 7.25 in to	
S	in to	ft
j		
7 WELL WATER TO BE US		Oil Field Wesen Complete James
1 Domestic:	Public Water Supply: well ID	10 Oil Field Water Supply: lease
Household Lawn & Garden	Dewatering: how many wells?  Aquifer Recharge: well ID	Cased Uncased Geotechnical
Livestock	8 X Monitoring: well ID MW12	12 Geothermal: How many bores?
2 Irrigation	9 Environmental Remediation: well ID	a) Closed Loop Horizontal Vertical
3 Feedlot	Air Sparge Soil Vapor Extraction	
4 Industrial	Recovery Injection	Other (specify):
Was a chemical/bacteriological sample submitted to KDHE? Yes X No If yes, date sample was submitted:		
Water well disinfected? Yes X No		
8 TYPE OF CASING USED: Steel X PVC Other CASING JOINTS: Glued Clampled Welded X Threaded		
Casing diameter 2 in. to 4 ft, Diameter in. to ft, Diameter in. to ft,		
Casing height above land surface -0.38 in. Weight lbs./ft. Well thickness or gauge No		
TYPE OF SCREEN OR PERFORATION MATERIAL:		
Steel Stainless Steel Fiberglass X PVC Other (Specify)  Brass Galvanized Steel Concrete tile None used (open hole)		
Brass Galvanized Steel Concrete tile None used (open hole)  SCREEN OR PERFORATION OPENINGS ARE:		
Continuous Slot X Mill Slot Gauze Wrapped Torch Cut Drilled Holes Other (Specify)		
Louvered Shutter   Key Punched   Wire Wrapped   Saw Cut   None (Open Hole)		
SCREEN-PERFORATED INTERVALS: From 4 ft. to 15 ft, From ft. to ft, From ft. to ft,		
GRAVEL PACK INTERVALS: From 2.5 ft. to 15 ft, From ft. to ft, From ft. to ft,		
9 GROUT MATERIAL: Neat cement Cement grout X Bentonite X Other Concrete: 0-0.5'		
Grout intervals: From 0.5 ft. to 2.5 ft, From ft. to ft, From ft. to ft,		
Nearest source of possible contamination:		
Septic Tank	Lateral Lines Pit Privy	Livestock Pens Insecticide Storage
Sewer Lines	Cess Pool Sewage Lagoon	X Fuel Storage Abandoned Water Well
Watertight Sewer Lines	Seepage Pit Feedyard	Fertilizer Storage Oil Well / Gas Well
Other (Specity)	District 1	0.05
Direction from well? NW	Distance from well	
10 FROM TO   0.3 Aspha	LITHOLOGIC LOG	FROM TO LITHO. LOG (cont.) or PLUGGING INTERVALS
0.3 6 Silty of		
6 8.5 Sands		
	lay with sand	
10 15 Shale		Notes: KDHE ID: Pete's of Pleasanton d/b/a Pump-N-Pete's; U3-054-12248
		Target of monitoring well is shallow groundwater, <20' of grout was installed at the
		direction of KDHE
11 CONTRACTOR'S OR LANDOWNER'S CERTIFICATION: This water well was X constructed. reconstructed or plugged under my		
jurisdiction and was completed on (mo-day-year) 8/6/18 and this record is true to the best of my knowledge and belief. Kansas Water & Contractor's		
License No 757 This Water Well Record was completed on (mo-day-year) 8/20/18  under the business name of Larsen & Associates, Inc.  Signature		
under the business name of Larsen & Associates. Inc.  Mail 1 white copy along with a fee of \$5.00 for each constructed well to: Kansas Department of Health and Environment. Bureat of Water.		
1000 SW Jackson St., Suite 420. Topeka, Kansas 66612-1367. Mail one to Water Well Owner and retain one for your records. Telephone 785-296-5524.		
Visit us at http://www.kdheks.gov/waterwell/index.html KSA 82a-1212 Revised 7/10/2015		

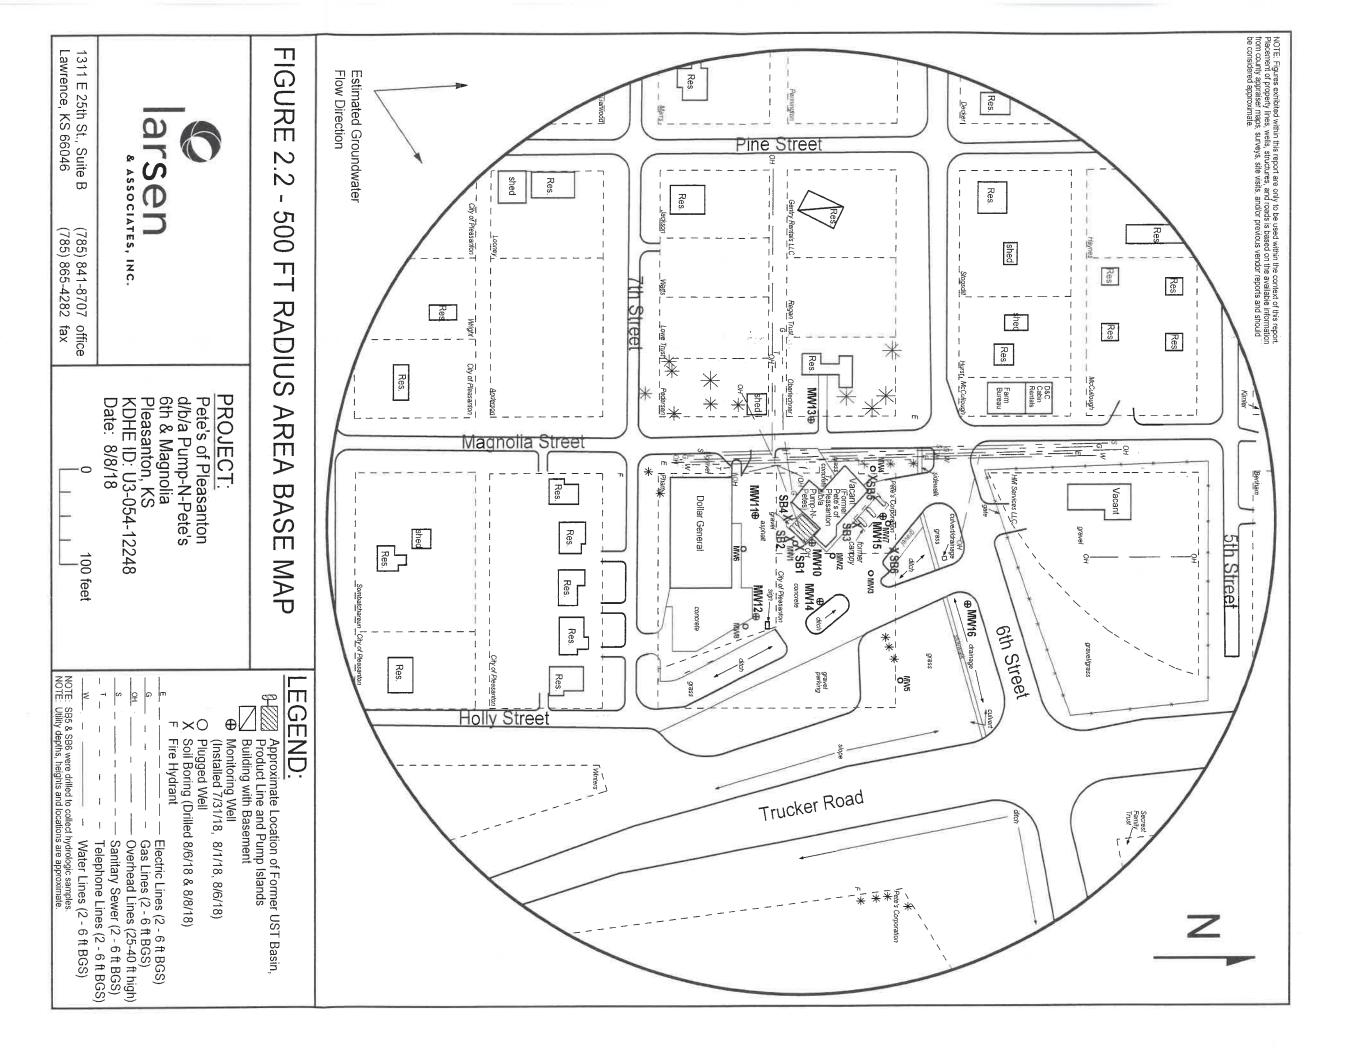

RECEIVED