
						, ,	
WAT	ER WELL RECORD	Form WWC-5		Division of Water	1		MW14
X	Original Record Correction	on Change in Well Ust	R	lesources App. No		Well ID	101 00 14
1	LOCATION OF WATER WI	ELL: Fraction		Section Nu	mber Township Nu		
	County Linn	NE ¼ SE	4 NE 4 NW		T 21		5 X E W
2	WELL OWNER: Last Name:	First:			well is located (if unl		
	Business: Pete's Corporation		from nearest	town or intersecti	on): If at owner's a	ddress, check he	re:
	Address: 1712 Broadway		601 Holly St, Ple	easanton, KS			
	Address: PO Box 876						
	City Parsons	State: KS ZIP: 67357			20.10	0.00	
	LOCATE WELL 4	DEPTH OF COMPLETED WE	LL: <u>25</u> ft	5 Latitud			cimal degrees)
1	WITH "X" IN Dep	oth(s) Groundwater Encountered:	Π Τ	Longitu			cimal degrees) 33 NAD 27
1		2)ft 3)ft, or	4) Dry Well		tal Datum: X WGS for Latitude/Longitud		NAD 27
		LL'S STATIC WATER LEVEL:	3.50 ft.		S (unit make/model:	<u>c.</u>)
		below land surface, measured on			WAAS enabled?	Yes No	/
	NW X NE D	above land surface, measured on	(mo-day-yr)	V 10.	d Survey Topo		,
	. . "		ft		ine Mapper	grapine map	
w	E I	after hours pumping Water well was	gpm fi		me Mapper		
	' '			6 Elevati	on 851.58 ft	Ground Le	evel X TOC
	sw se	after hours pumping hours pumping	gpm		X Land Survey		Topographic Map
		stimated Yield: gpm		Source		_	
	S E	Bore Hole Diameter: 7.25 in	toTI, and	1	Other		***************************************
Ι.	S mile	in in	10				
7 WELL WATER TO BE USED AS:							
1	mestic: 5	Públic Water Supply: well ID		10 Oil Fie	id Water Supply: leas	se	
	Household 6	Dewatering: how many wells?		11 Test Hole:	vell ID		
	Lawn & Garden 7	Aquifer Recharge: well ID		Cased	Uncased	Geotechnic	al
	_	Monitoring: well ID MW14		12 Geothermal:	How many bores?		
	<u>-</u>	Invironmental Remediation: well ID		a) Closed	Loop Horizont	al Vertic	al
3	Feedlot	Air Sparge Soil Vapor	Extraction	b) Open L	oop Surface I	Discharge	Inj. of Water
	Industrial	Recovery Injection		Other (specify):		
Was a chemical/bacteriological sample submitted to KDHE? Yes X No If yes, date sample was submitted:							
Water well disinfected? Yes X No							
8 TYPE OF CASING USED: Steel X PVC Other CASING JOINTS: Glued Clampled Welded X Threaded							
Casing diameter 2 in. to 5 ft, Diameter in. to ft, Diameter in. to ft, Casing height above land surface -0.34 in. Weight lbs./ft. Well thickness or gauge No							
Casing height above land surface -0.34 in. Weight lbs./ft. Well thickness or gauge No							
Steel Stainless Steel Fiberglass X PVC Other (Specify)							
Brass Galvanized Steel Concrete tile None used (open hole)							
SCREEN OR PERFORATION OPENINGS ARE:							
Continuous Slot X Mill Slot Gauze Wrapped Torch Cut Drilled Holes Other (Specify)							
Louvered Shutter							£
SCRE	EN-PERFORATED INTERVAL	S: From 5 ft. to 25	ft, From	ft. to	ft, From	It. to	π,
	GRAVEL PACK INTERVALS	S: From 3 ft. to 25					
9 GROUT MATERIAL: Neat cement Cement grout X Bentonite X Other Concrete: 0-0.7'							
Grout intervals: From 0.7 ft. to 3 ft, From ft. to ft, From ft. to ft,							
Nearest source of possible contamination:							
	Septic Tank	Lateral Lines Pit Priv	y 🗔 :	Livestock Pens	Insectici	de Storage	
lΠ	Sewer Lines	= =	· <u>=</u>	Fuel Storage	Abandor	ed Water Well	
	Watertight Sewer Lines	Seepage Pit Feedya		Fertilizer Storage	Oil Well	/ Gas Well	
	Other (Specity)			Č			
Direction	on from well? W-SW	Distance	e from well? ~65		ft		
10 FI		LITHOLOGIC LOG	FRO	м То	LITHO LOG	(cont.) or PLUGG	ING INTERVALS
10 11		ETHOLOGIC LOG	- IRO		2.11.0. 2.00		
0.							
0.							
7		edded limestone fingers					
Notes: KDHE ID: Pete's of Pleasanton d/b/a Pump-N-Pete's; U3-054-12248							
Target of monitoring well is shallow groundwater, <20' of grout was installed at the							
direction of KDHE.							
11 CONTRACTOR'S OR LANDOWNER'S CERTIFICATION: This water well was X constructed reconstructed or nlugged under my							
jurisdiction and was completed on (mo-day-year) 7/31/18 and this record is true to the best of my knowledge and belief. Kansas Water Well Contractor's License No 757 This Water Well Record was completed on (mo-day-year) 8/20/18							
Lic	ense No 757 T	This Water Well Record was complete	ed on (mo-day-year) _8	5/20/18		$\langle - + -$	
und	er the business name of Larsen &	Associates, inc.		Signature	D. C.W.		
Mail 1 white copy along with a fee of \$5.00 for each constructed well to: Kansas Department of Health and Environment. Bureau of Water. Section. 1000 SW Jackson St., Suite 420, Topeka, Kansas 66612-1367, Mail one to Water Well Owner and retain one for your records. Telephone 785-296-5524.							
1000 SW Jackson St., Suite 420, Topeka, Kansas 66612-1367, Mail one to Water Well Owner and retail one for your records. Telephone 703-230-3324. Well us at http://www.ldhelis.gov/gustervell/index.html KSA 82a-1212 Revised 7/10/2015							

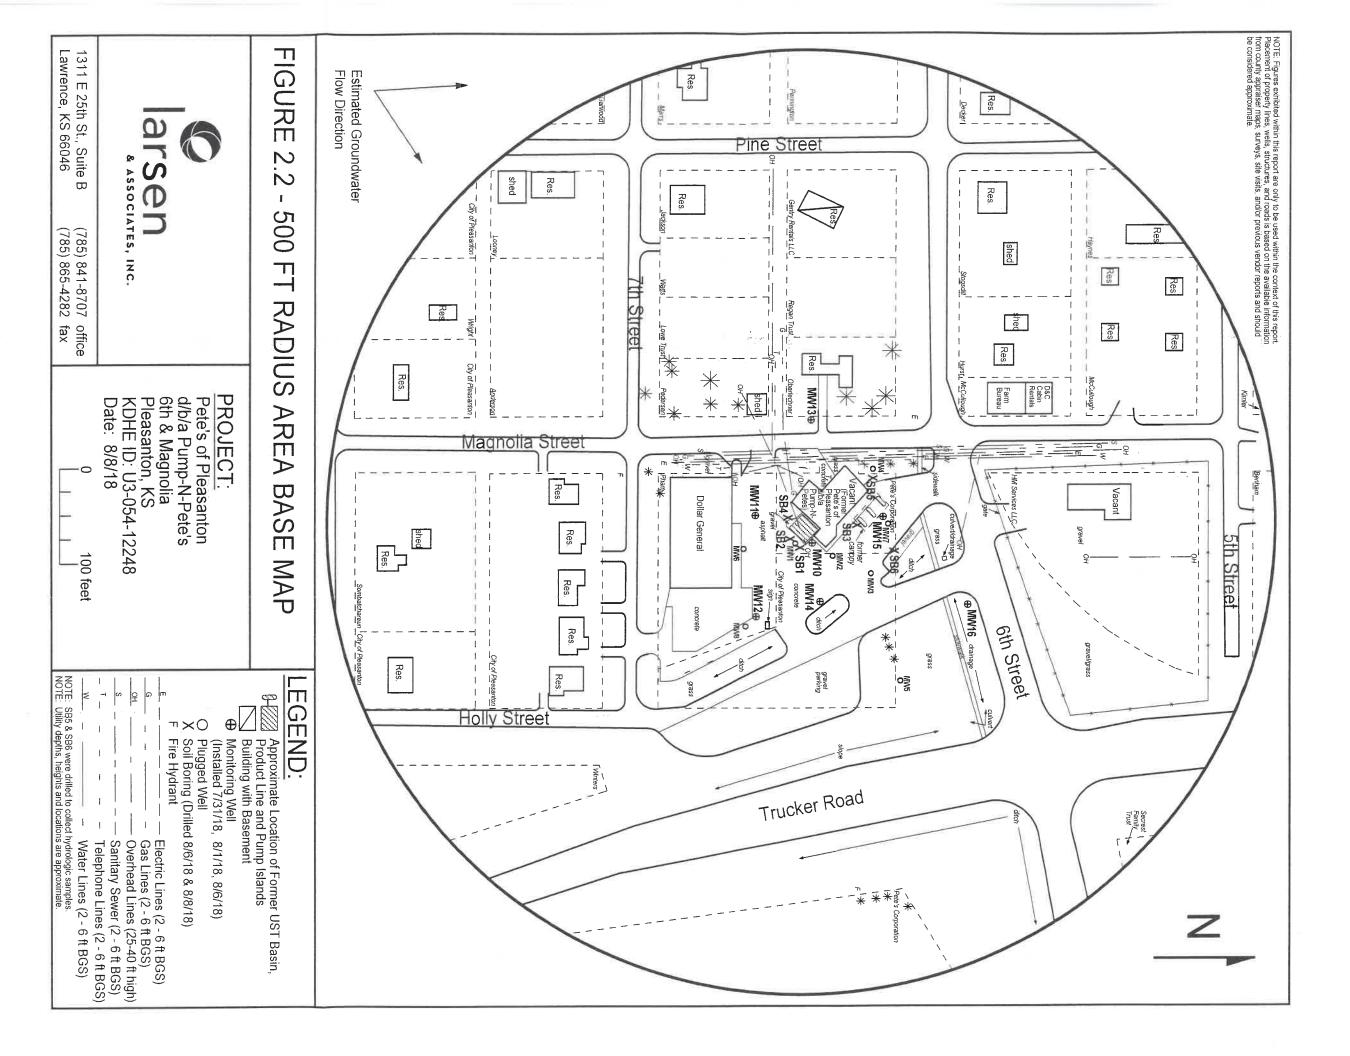

RECEIVED