

WATER WELL RECORD

Form WWC-5


Division of Water

Resources App. No.

Well ID

MW17

☒ Original Record ☐ Correction ☐ Change in Well Use

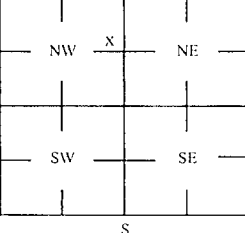1 LOCATION OF WATER WELL: County Linn		Fraction NW ¼ SE ¼ NE ¼ NW ¼	Section Number 31	Township Number T 21 S	Range Number R 25 E <input checked="" type="checkbox"/> W
2 WELL OWNER: Last Name: First: Business: Pete's Corporation Address: 1712 Broadway Address: PO Box 876 City Parsons State: KS ZIP: 67357		Street or Rural Address where well is located (if unknown, distance and direction from nearest town or intersection): If at owner's address, check here: <input type="checkbox"/> NW corner of 7th St. & Magnolia St., Pleasanton, KS			
3 LOCATE WELL WITH "X" IN SECTION BOX: 	4 DEPTH OF COMPLETED WELL: 24 ft Depth(s) Groundwater Encountered: 1) _____ ft 2) _____ ft 3) _____ ft, or 4) <input type="checkbox"/> Dry Well WELL'S STATIC WATER LEVEL: 6.22 ft <input checked="" type="checkbox"/> below land surface, measured on (mo-day-yr) 1/7-8/19 <input type="checkbox"/> above land surface, measured on (mo-day-yr) _____ Pump test data: Well water was _____ ft after _____ hours pumping _____ gpm Water well was _____ ft after _____ hours pumping _____ gpm Estimated Yield: _____ gpm Bore Hole Diameter: 7.25 in to _____ ft, and _____ in to _____ ft	5 Latitude: 38.18009 (decimal degrees) Longitude: 94.70604 (decimal degrees) Horizontal Datum: <input checked="" type="checkbox"/> WGS 84 <input type="checkbox"/> NAD 83 <input type="checkbox"/> NAD 27 Source for Latitude/Longitude: <input type="checkbox"/> GPS (unit make/model: _____) (WAAS enabled? <input type="checkbox"/> Yes <input type="checkbox"/> No) <input checked="" type="checkbox"/> Land Survey <input type="checkbox"/> Topographic Map <input type="checkbox"/> Online Mapper			
		6 Elevation 853.00 ft <input type="checkbox"/> Ground Level <input checked="" type="checkbox"/> TOC Source: <input checked="" type="checkbox"/> Land Survey <input type="checkbox"/> GPS <input type="checkbox"/> Topographic Map <input type="checkbox"/> Other _____			

7 WELL WATER TO BE USED AS: 1 Domestic: <input type="checkbox"/> Household <input type="checkbox"/> Lawn & Garden <input type="checkbox"/> Livestock 2 <input type="checkbox"/> Irrigation 3 <input type="checkbox"/> Feedlot 4 <input type="checkbox"/> Industrial		5 <input type="checkbox"/> Public Water Supply: well ID 6 <input type="checkbox"/> Dewatering: how many wells? 7 <input type="checkbox"/> Aquifer Recharge: well ID 8 <input checked="" type="checkbox"/> Monitoring: well ID MW17 9 Environmental Remediation: well ID <input type="checkbox"/> Air Sparge <input type="checkbox"/> Soil Vapor Extraction <input type="checkbox"/> Recovery <input type="checkbox"/> Injection		10 <input type="checkbox"/> Oil Field Water Supply: lease 11 Test Hole: well ID <input type="checkbox"/> Cased <input type="checkbox"/> Uncased <input type="checkbox"/> Geotechnical 12 Geothermal: How many bores? a) Closed Loop <input type="checkbox"/> Horizontal <input type="checkbox"/> Vertical b) Open Loop <input type="checkbox"/> Surface Discharge <input type="checkbox"/> Inj. of Water <input type="checkbox"/> Other (specify): _____	
---	--	---	--	--	--

Was a chemical/bacteriological sample submitted to KDHE? ☐ Yes ☒ No If yes, date sample was submitted: _____
Water well disinfected? ☐ Yes ☒ No

8 TYPE OF CASING USED: <input type="checkbox"/> Steel <input checked="" type="checkbox"/> PVC <input type="checkbox"/> Other _____ CASING JOINTS: <input type="checkbox"/> Glued <input type="checkbox"/> Clamped <input type="checkbox"/> Welded <input checked="" type="checkbox"/> Threaded Casing diameter 2 in. to 9 ft, Diameter _____ in. to _____ ft, Diameter _____ in. to _____ ft, Casing height above land surface -0.45 in. Weight _____ lbs./ft. Well thickness or gauge No _____	
TYPE OF SCREEN OR PERFORATION MATERIAL: <input type="checkbox"/> Steel <input type="checkbox"/> Stainless Steel <input type="checkbox"/> Fiberglass <input checked="" type="checkbox"/> PVC <input type="checkbox"/> Other (Specify) _____ <input type="checkbox"/> Brass <input type="checkbox"/> Galvanized Steel <input type="checkbox"/> Concrete tile <input type="checkbox"/> None used (open hole)	
SCREEN OR PERFORATION OPENINGS ARE: <input type="checkbox"/> Continuous Slot <input checked="" type="checkbox"/> Mill Slot <input type="checkbox"/> Gauze Wrapped <input type="checkbox"/> Torch Cut <input type="checkbox"/> Drilled Holes <input type="checkbox"/> Other (Specify) _____ <input type="checkbox"/> Louvered Shutter <input type="checkbox"/> Key Punched <input type="checkbox"/> Wire Wrapped <input type="checkbox"/> Saw Cut <input type="checkbox"/> None (Open Hole)	
SCREEN-PERFORATED INTERVALS: From 9 ft. to 24 ft, From _____ ft. to _____ ft, From _____ ft. to _____ ft, GRAVEL PACK INTERVALS: From 7 ft. to 24 ft, From _____ ft. to _____ ft, From _____ ft. to _____ ft,	

9 GROUT MATERIAL: <input type="checkbox"/> Neat cement <input type="checkbox"/> Cement grout <input checked="" type="checkbox"/> Bentonite <input checked="" type="checkbox"/> Other Concrete: 0-0.7 Grout intervals: From 0.7 ft. to 7 ft, From _____ ft. to _____ ft, From _____ ft. to _____ ft,	
--	--

Nearest source of possible contamination:
☐ Septic Tank ☐ Lateral Lines ☐ Pit Privy ☐ Livestock Pens ☐ Insecticide Storage
☐ Sewer Lines ☐ Cess Pool ☐ Sewage Lagoon ☒ Fuel Storage ☐ Abandoned Water Well
☐ Watertight Sewer Lines ☐ Seepage Pit ☐ Feedyard ☐ Fertilizer Storage ☐ Oil Well / Gas Well
☐ Other (Specify) _____
 Direction from well? NE Distance from well? ~175 ft

10 FROM	TO	LITHOLOGIC LOG	FROM	TO	LITHO. LOG (cont.) or PLUGGING INTERVALS
0	0.3	Topsoil			
0.3	11	Silty clay			
11	24	Weathered claystone/shale			

Notes: KDHE ID: Pete's of Pleasanton d/b/a Pump-N-Pete's; U3-054-12248
Target of monitoring well is shallow groundwater, <20' of grout was installed at the direction of KDHE.

11 CONTRACTOR'S OR LANDOWNER'S CERTIFICATION: This water well was <input checked="" type="checkbox"/> constructed, <input type="checkbox"/> reconstructed, or <input type="checkbox"/> plugged under my jurisdiction and was completed on (mo-day-year) 1/7/19 and this record is true to the best of my knowledge and belief. Kansas Water Well Contractor's License No. 757 This Water Well Record was completed on (mo-day-year) 1/28/19 under the business name of Larsen & Associates, Inc. Signature _____	
--	--

Mail 1 white copy along with a fee of \$5.00 for each constructed well to: Kansas Department of Health and Environment, Division of Water, GWWS Section, 1000 SW Jackson St., Suite 420, Topeka, Kansas 66612-1367. Mail one to Water Well Owner and retain one for your records. Telephone 785-296-5524.

Visit us at <http://www.kdheks.gov/waterwell/index.html>

KSA 82a-1212

Revised 7/10/2015

Linn Co Owner: Pete's Corporation

NW SE NE NW 31-21-25E

NOTE: Figures exhibited within this report are only to be used within the context of this report. Placement of property lines, wells, structures, and roads is based on the available information from county appraiser maps, surveys, site visits, and/or previous vendor reports and should be considered approximate.

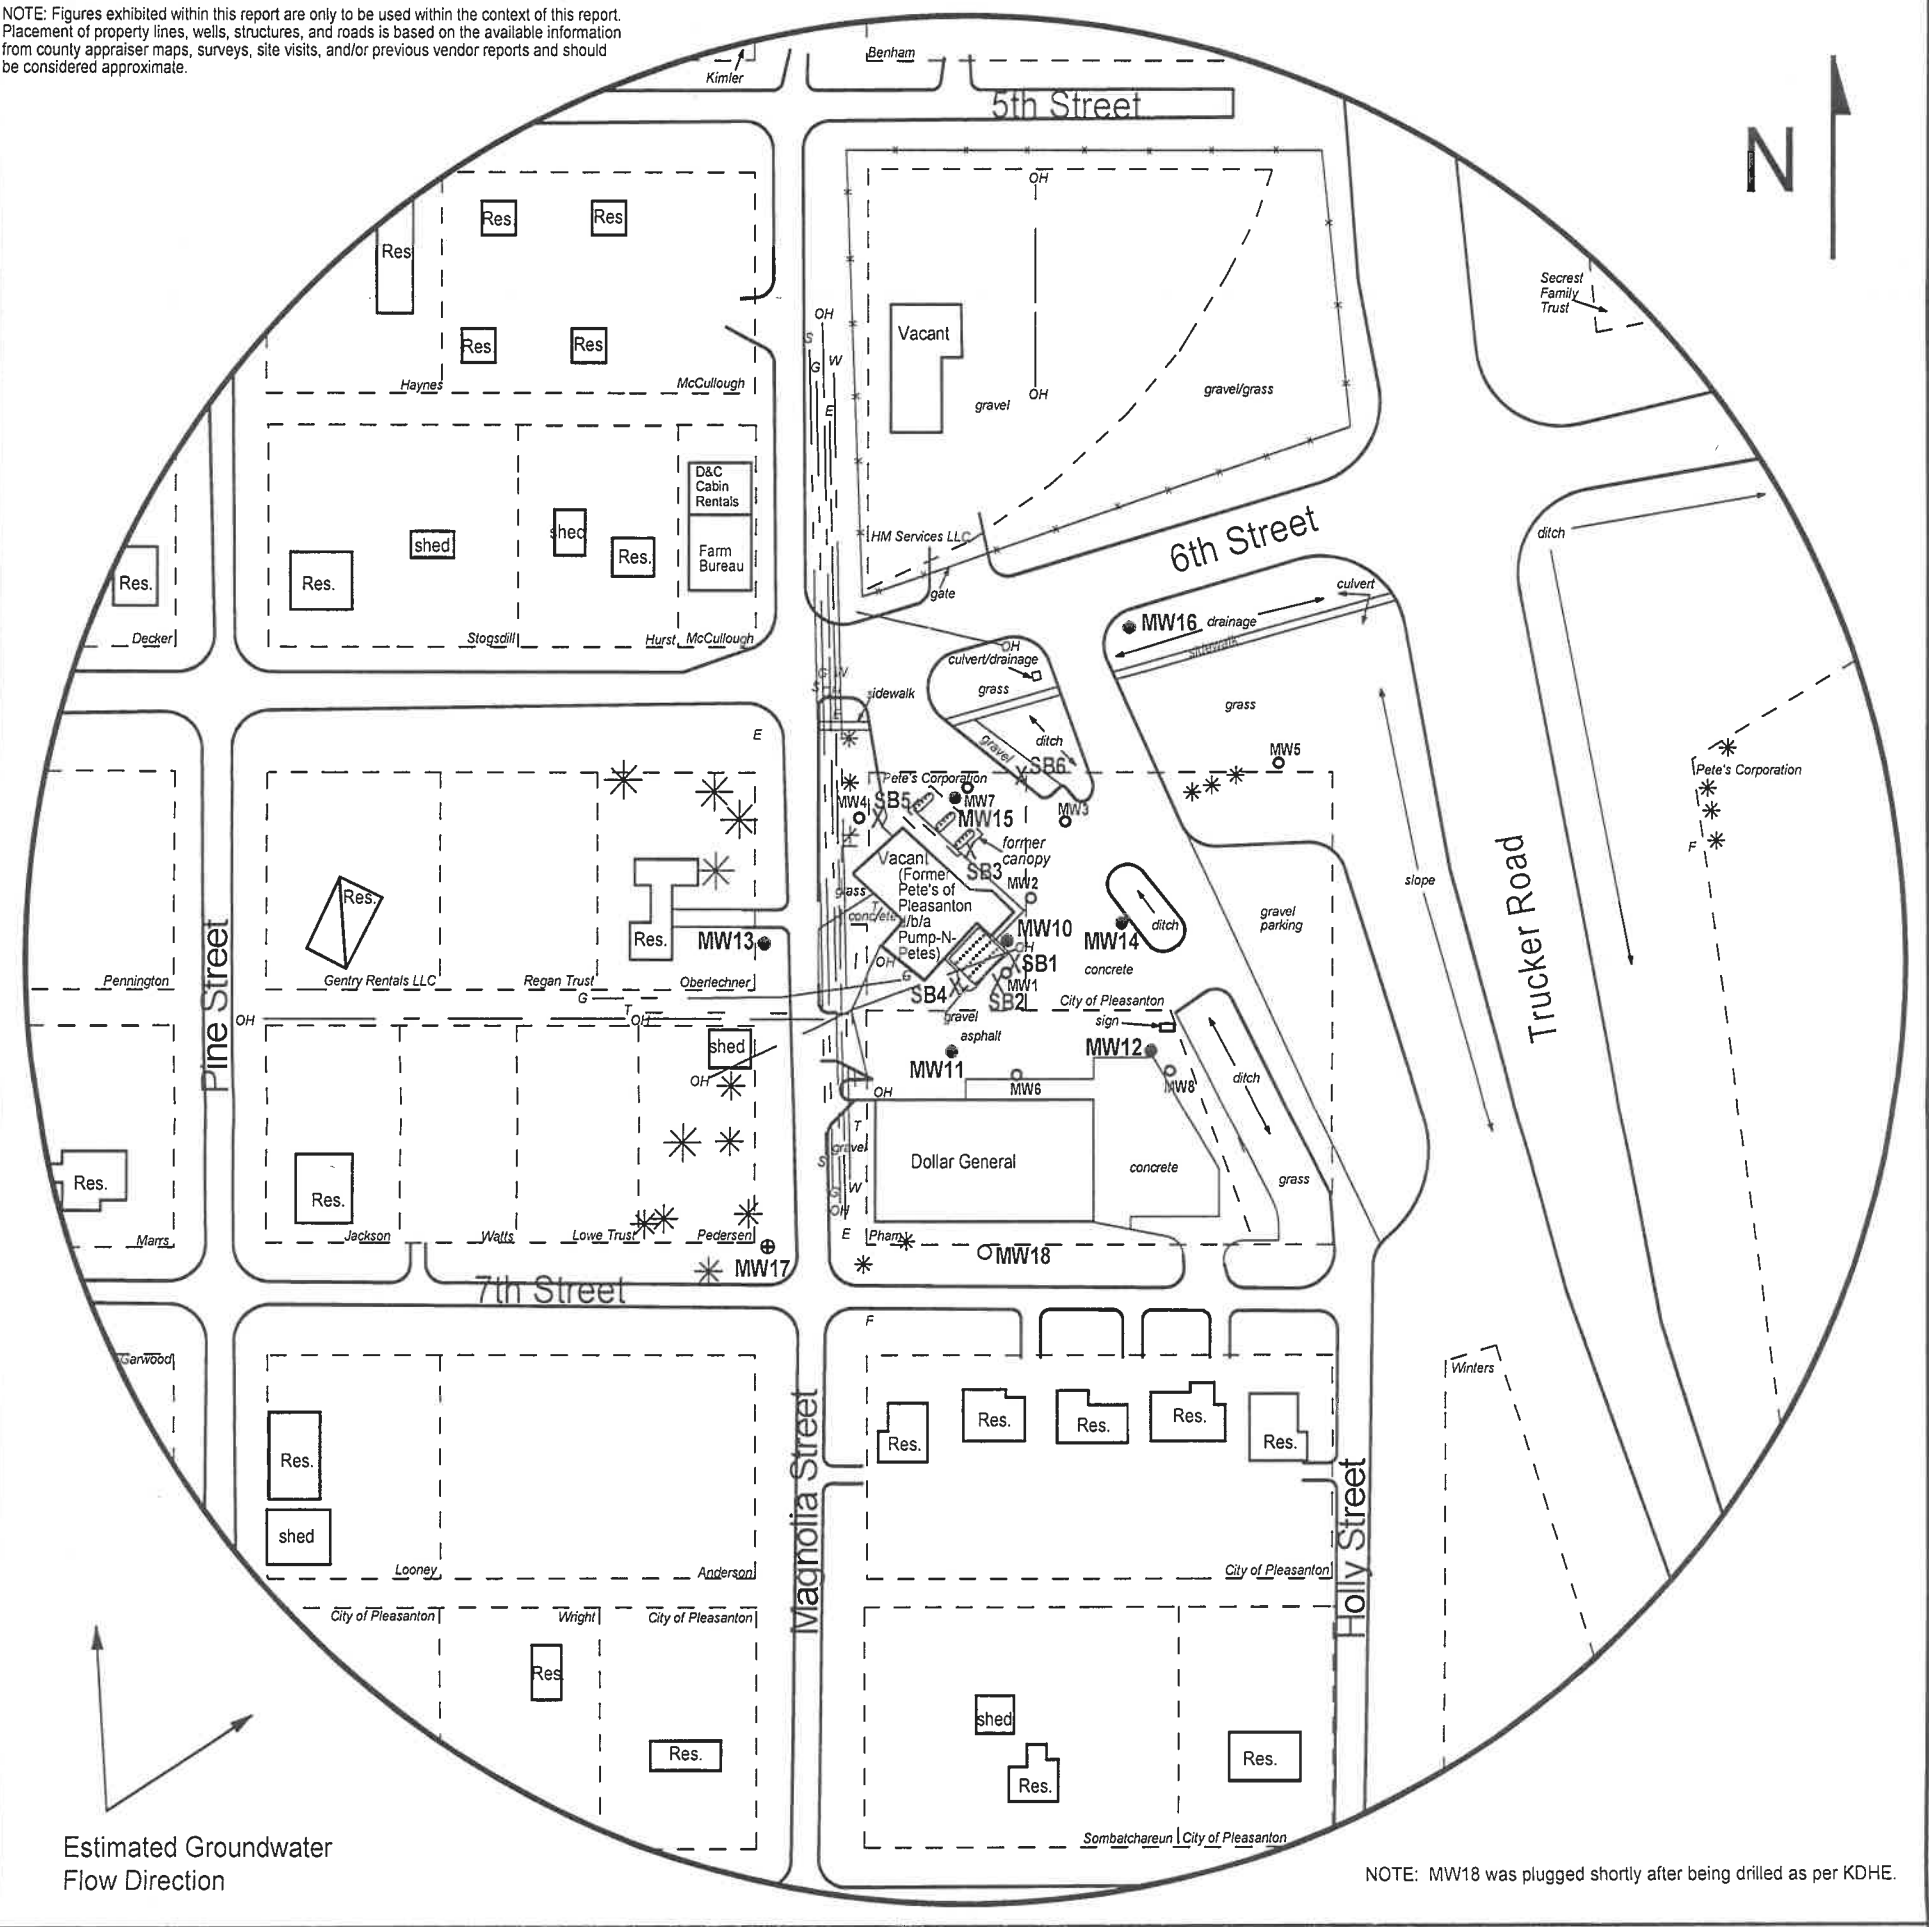


FIGURE 2.2 - 500 FT RADIUS AREA BASE MAP



1311 E 25th St., Suite B (785) 841-8707 office
Lawrence, KS 66046 (785) 865-4282 fax

PROJECT:
Pete's of Pleasanton
d/b/a Pump-N-Pete's
6th & Magnolia
Pleasanton, KS
KDHE ID: U3-054-12248
Date: 1/7-8/19

0 100 feet

LEGEND:

- Approximate Location of Former UST Basin, Product Line and Pump Islands
 - Building with Basement
 - Approximate Location of Property Line
 - Existing Monitoring Well
 - Monitoring Well (Installed 1/7/19)
 - Plugged Well
 - Soil Boring (Drilled 8/6/18 & 8/8/18)
 - Fire Hydrant
 - Electric Lines (2 - 6 ft BGS)
 - Gas Lines (2 - 6 ft BGS)
 - Overhead Lines (25-40 ft high)
 - Sanitary Sewer (2 - 6 ft BGS)
 - Telephone Lines (2 - 6 ft BGS)
 - Water Lines (2 - 6 ft BGS)
- NOTE: Utility depths, heights and locations are approximate.

RECEIVED
FEB 05 2019
BUREAU OF WATER

DENNIS L HANDKE

1820 NW 59th Terrace
TOPEKA, KANSAS 66618
785-286-4047 Home
785-286-1990 Fax

Linn Co
Owner: Pete's Corporation
NW SE NE NW
31-21-25E

Jess Chapman
Larsen & Associates
1311 E. 25th Street, Suite B
Lawrence, Kansas, 66046
RE: Monitor Well Elevation Survey
6h & Magnolia, Pleasanton, Kansas

January 19, 2019

Proj. 19-00D
Pete's of Pleasanton
D/B/A Pump-N-Pete's
U3-054-12248

Bench Mark: Square cut on Southeast Corner of concrete headwall of RCB near NW Corner of property.
Elev: 851.80 North 4729.45 West 3004.19 (from SE Cor. Sec. 31-21-25E)

MW-17	rim	853.45	North	4415.41	NW1/4,SE1/4,NE1/4,NW1/4
	top pipe	853.00	West	3034.85	Lat= 38.18009 Long = 94.70604

Lat & Long derived from Pleasanton 7.5' quad map. WGS84

Elevation established from existing project.

If you have any questions, please feel free to call me. Thank you for the opportunity to be of service to you.

