

WATER WELL RECORD Form WWC-5

Original Record Correction Change in Well Use

Division of Water Resources App. No. []

Well ID []

1 LOCATION OF WATER WELL: County:	Fraction 1/4 1/4 1/4 1/4	Section Number	Township Number T S	Range Number R E W
---	-----------------------------------	----------------	--------------------------	---------------------------

2 WELL OWNER: Last Name: _____ First: _____ Business: _____ Address: _____ Address: _____ City: _____ State: _____ ZIP: _____	Street or Rural Address where well is located (if unknown, distance and direction from nearest town or intersection): If at owner's address, check here: <input type="checkbox"/>
--	---

3 LOCATE WELL WITH "X" IN SECTION BOX: N <table border="1" style="width:100%; height: 60px; text-align: center;"> <tr><td>---</td><td>NW</td><td>---</td><td>NE</td><td>---</td></tr> <tr><td>W</td><td> </td><td> </td><td> </td><td>E</td></tr> <tr><td>---</td><td>SW</td><td>---</td><td>SE</td><td>---</td></tr> <tr><td></td><td>S</td><td></td><td></td><td></td></tr> </table> [-----1 mile-----]	---	NW	---	NE	---	W				E	---	SW	---	SE	---		S				4 DEPTH OF COMPLETED WELL: ft. Depth(s) Groundwater Encountered: 1) ft. 2) ft. 3) ft., or 4) <input type="checkbox"/> Dry Well WELL'S STATIC WATER LEVEL: ft. <input type="checkbox"/> below land surface, measured on (mo-day-yr)..... <input type="checkbox"/> above land surface, measured on (mo-day-yr)..... Pump test data: Well water was ft. after..... hours pumping gpm Well water was ft. after..... hours pumping gpm Estimated Yield:gpm Bore Hole Diameter: in. to ft. and in. to ft.	5 Latitude:(decimal degrees) Longitude:(decimal degrees) Datum: <input type="checkbox"/> WGS 84 <input type="checkbox"/> NAD 83 <input type="checkbox"/> NAD 27 Source for Latitude/Longitude: <input type="checkbox"/> GPS (unit make/model:)(WAAS enabled? <input type="checkbox"/> Yes <input type="checkbox"/> No) <input type="checkbox"/> Land Survey <input type="checkbox"/> Topographic Map <input type="checkbox"/> Online Mapper: 6 Elevation:ft. <input type="checkbox"/> Ground Level <input type="checkbox"/> TOC Source: <input type="checkbox"/> Land Survey <input type="checkbox"/> GPS <input type="checkbox"/> Topographic Map <input type="checkbox"/> Other
---	NW	---	NE	---																		
W				E																		
---	SW	---	SE	---																		
	S																					

7 WELL WATER TO BE USED AS:		
1. Domestic: <input type="checkbox"/> Household <input type="checkbox"/> Lawn & Garden <input type="checkbox"/> Livestock 2. <input type="checkbox"/> Irrigation 3. <input type="checkbox"/> Feedlot 4. <input type="checkbox"/> Industrial	5. <input type="checkbox"/> Public Water Supply: well ID 6. <input type="checkbox"/> Dewatering: how many wells? 7. <input type="checkbox"/> Aquifer Recharge: well ID 8. <input type="checkbox"/> Monitoring: well ID 9. Environmental Remediation: well ID <input type="checkbox"/> Air Sparge <input type="checkbox"/> Soil Vapor Extraction <input type="checkbox"/> Recovery <input type="checkbox"/> Injection	10. <input type="checkbox"/> Oil Field Water Supply: lease 11. Test Hole: well ID <input type="checkbox"/> Cased <input type="checkbox"/> Uncased <input type="checkbox"/> Geotechnical 12. Geothermal: how many bores? a) Closed Loop <input type="checkbox"/> Horizontal <input type="checkbox"/> Vertical b) Open Loop <input type="checkbox"/> Surface Discharge <input type="checkbox"/> Inj. of Water 13. <input type="checkbox"/> Other (specify):

Was a chemical/bacteriological sample submitted to KDHE? Yes No If yes, date sample was submitted:

Water well disinfected? Yes No

8 TYPE OF CASING USED: Steel PVC Other **CASING JOINTS:** Glued Clamped Welded Threaded
 Casing diameter in. to ft., Diameter in. to ft., Diameter in. to ft.
 Casing height above land surface in. Weight lbs./ft. Wall thickness or gauge No.
TYPE OF SCREEN OR PERFORATION MATERIAL:
 Steel Stainless Steel Fiberglass PVC Other (Specify)
 Brass Galvanized Steel Concrete tile None used (open hole)
SCREEN OR PERFORATION OPENINGS ARE:
 Continuous Slot Mill Slot Gauze Wrapped Torch Cut Drilled Holes Other (Specify)
 Louvered Shutter Key Punched Wire Wrapped Saw Cut None (Open Hole)
SCREEN-PERFORATED INTERVALS: From ft. to ft., From ft. to ft., From ft. to ft.
GRAVEL PACK INTERVALS: From ft. to ft., From ft. to ft., From ft. to ft.

9 GROUT MATERIAL: Neat cement Cement grout Bentonite Other
 Grout Intervals: From ft. to ft., From ft. to ft., From ft. to ft.

Nearest source of possible contamination:
 Septic Tank Lateral Lines Pit Privy Livestock Pens Insecticide Storage
 Sewer Lines Cess Pool Sewage Lagoon Fuel Storage Abandoned Water Well
 Watertight Sewer Lines Seepage Pit Feedyard Fertilizer Storage Oil Well/Gas Well
 Other (Specify)

Direction from well? Distance from well? ft.

10 FROM	TO	LITHOLOGIC LOG	FROM	TO	LITHO. LOG (cont.) or PLUGGING INTERVALS

Notes:

11 CONTRACTOR'S OR LANDOWNER'S CERTIFICATION: This water well was constructed, reconstructed, or plugged under my jurisdiction and was completed on (mo-day-year) and this record is true to the best of my knowledge and belief. Kansas Water Well Contractor's License No. This Water Well Record was completed on (mo-day-year) under the business name of

18843 Aug 20 2018

FULL SITE SURVEY


COASTAL MART #2524
PEABODY, KANSAS

Point	North Coordinate	East Coordinate	SE Cor. Sec. 04 North West	Distance From SE Cor. Sec. 04 West	Elev. Top of Rim or PK Nail	Elev. Top of PVC Pipe	Latitude North	Longitude West
SE Cor. Sec. 4-1225-R3E	5000	5000						
MW1	10278.89	2400.06	5278.89	2599.94	1389.39	1389.14	38.17435	97.10690
MW2	10291.25	2330.48	5291.25	2669.52	1390.57	1390.57	38.17439	97.10714
MW3	10245.03	2415.96	5245.03	2584.04	1388.75	1388.37	38.17426	97.10685
MW4	10328.05	2297.28	5328.05	2742.72	1390.31	1390.01	38.17449	97.10740
MW5	10244.35	2352.42	5244.35	2647.58	1389.94	1389.94	38.17426	97.10767
MW6	10293.10	2459.47	5293.10	2640.53	1389.92	1389.38	38.17439	97.10669
MW7	10156.51	2418.94	5156.51	2581.06	1387.88	1387.52	38.17402	97.10684
MW8	10205.61	2454.52	5205.61	2545.48	1388.73	1388.40	38.17415	97.10671
MW9	10006.69	2265.76	5006.69	2734.24	1385.74	1385.19	38.17361	97.10737
MW10	10017.74	2418.14	5017.74	2581.86	1386.07	1385.77	38.17364	97.10684
MW11	10020.84	2807.77	5020.84	2192.23	1392.55	1392.13	38.17364	97.10549
MW12	10288.27	2297.37	5288.27	2702.63	1390.93	1390.32	38.17452	97.10713
MW13	10278.39	2370.53	5278.39	2629.47	1389.62	1389.26	38.17449	97.10688
MW14	10250.93	2334.98	5250.93	2665.02	1389.74	1389.26	38.17442	97.10700
MW15	10263.50	2307.46	5263.50	2692.54	1390.42	1390.17	38.17445	97.10710
AS1	10294.22	2341.28	5294.22	2658.72	1389.73	1389.24	38.17443	97.10698
AS2	10241.64	2326.52	5241.64	2673.48	1389.89	1389.42	38.17439	97.10703
Site BM	10219.08	2290.33	5219.08	2709.67	B.M. Elev. = 1391.56			

Description: "□" Square cut top curb 4' east of NE corner of Coastal Mart building corner

LEGEND

- MW1 ⊕ MONITORING WELL LOCATION
- ⊕ SITE BENCHMARK
- EXIST W --- WATER LINE
- EXIST OE --- OVERHEAD ELECTRIC
- EXIST SS --- SANITARY SEWER
- E/E --- EDGE OF ROAD TO EDGE OF ROAD
- B/B --- BACK TO BACK OF CURB
- ⊕ SIGN
- ⊕ POWER POLE
- ⊕ PP WITH TRANSFORMER
- ↓ DEADMAN ANCHOR
- ⊕ WM WATER METER
- ⊕ SANITARY SEWER MANHOLE

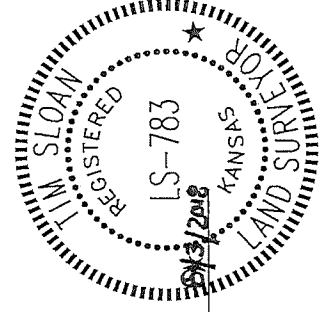

SMH Consultants
By: Tim Sloan
Tim Sloan
Tim Sloan, P.S.
President

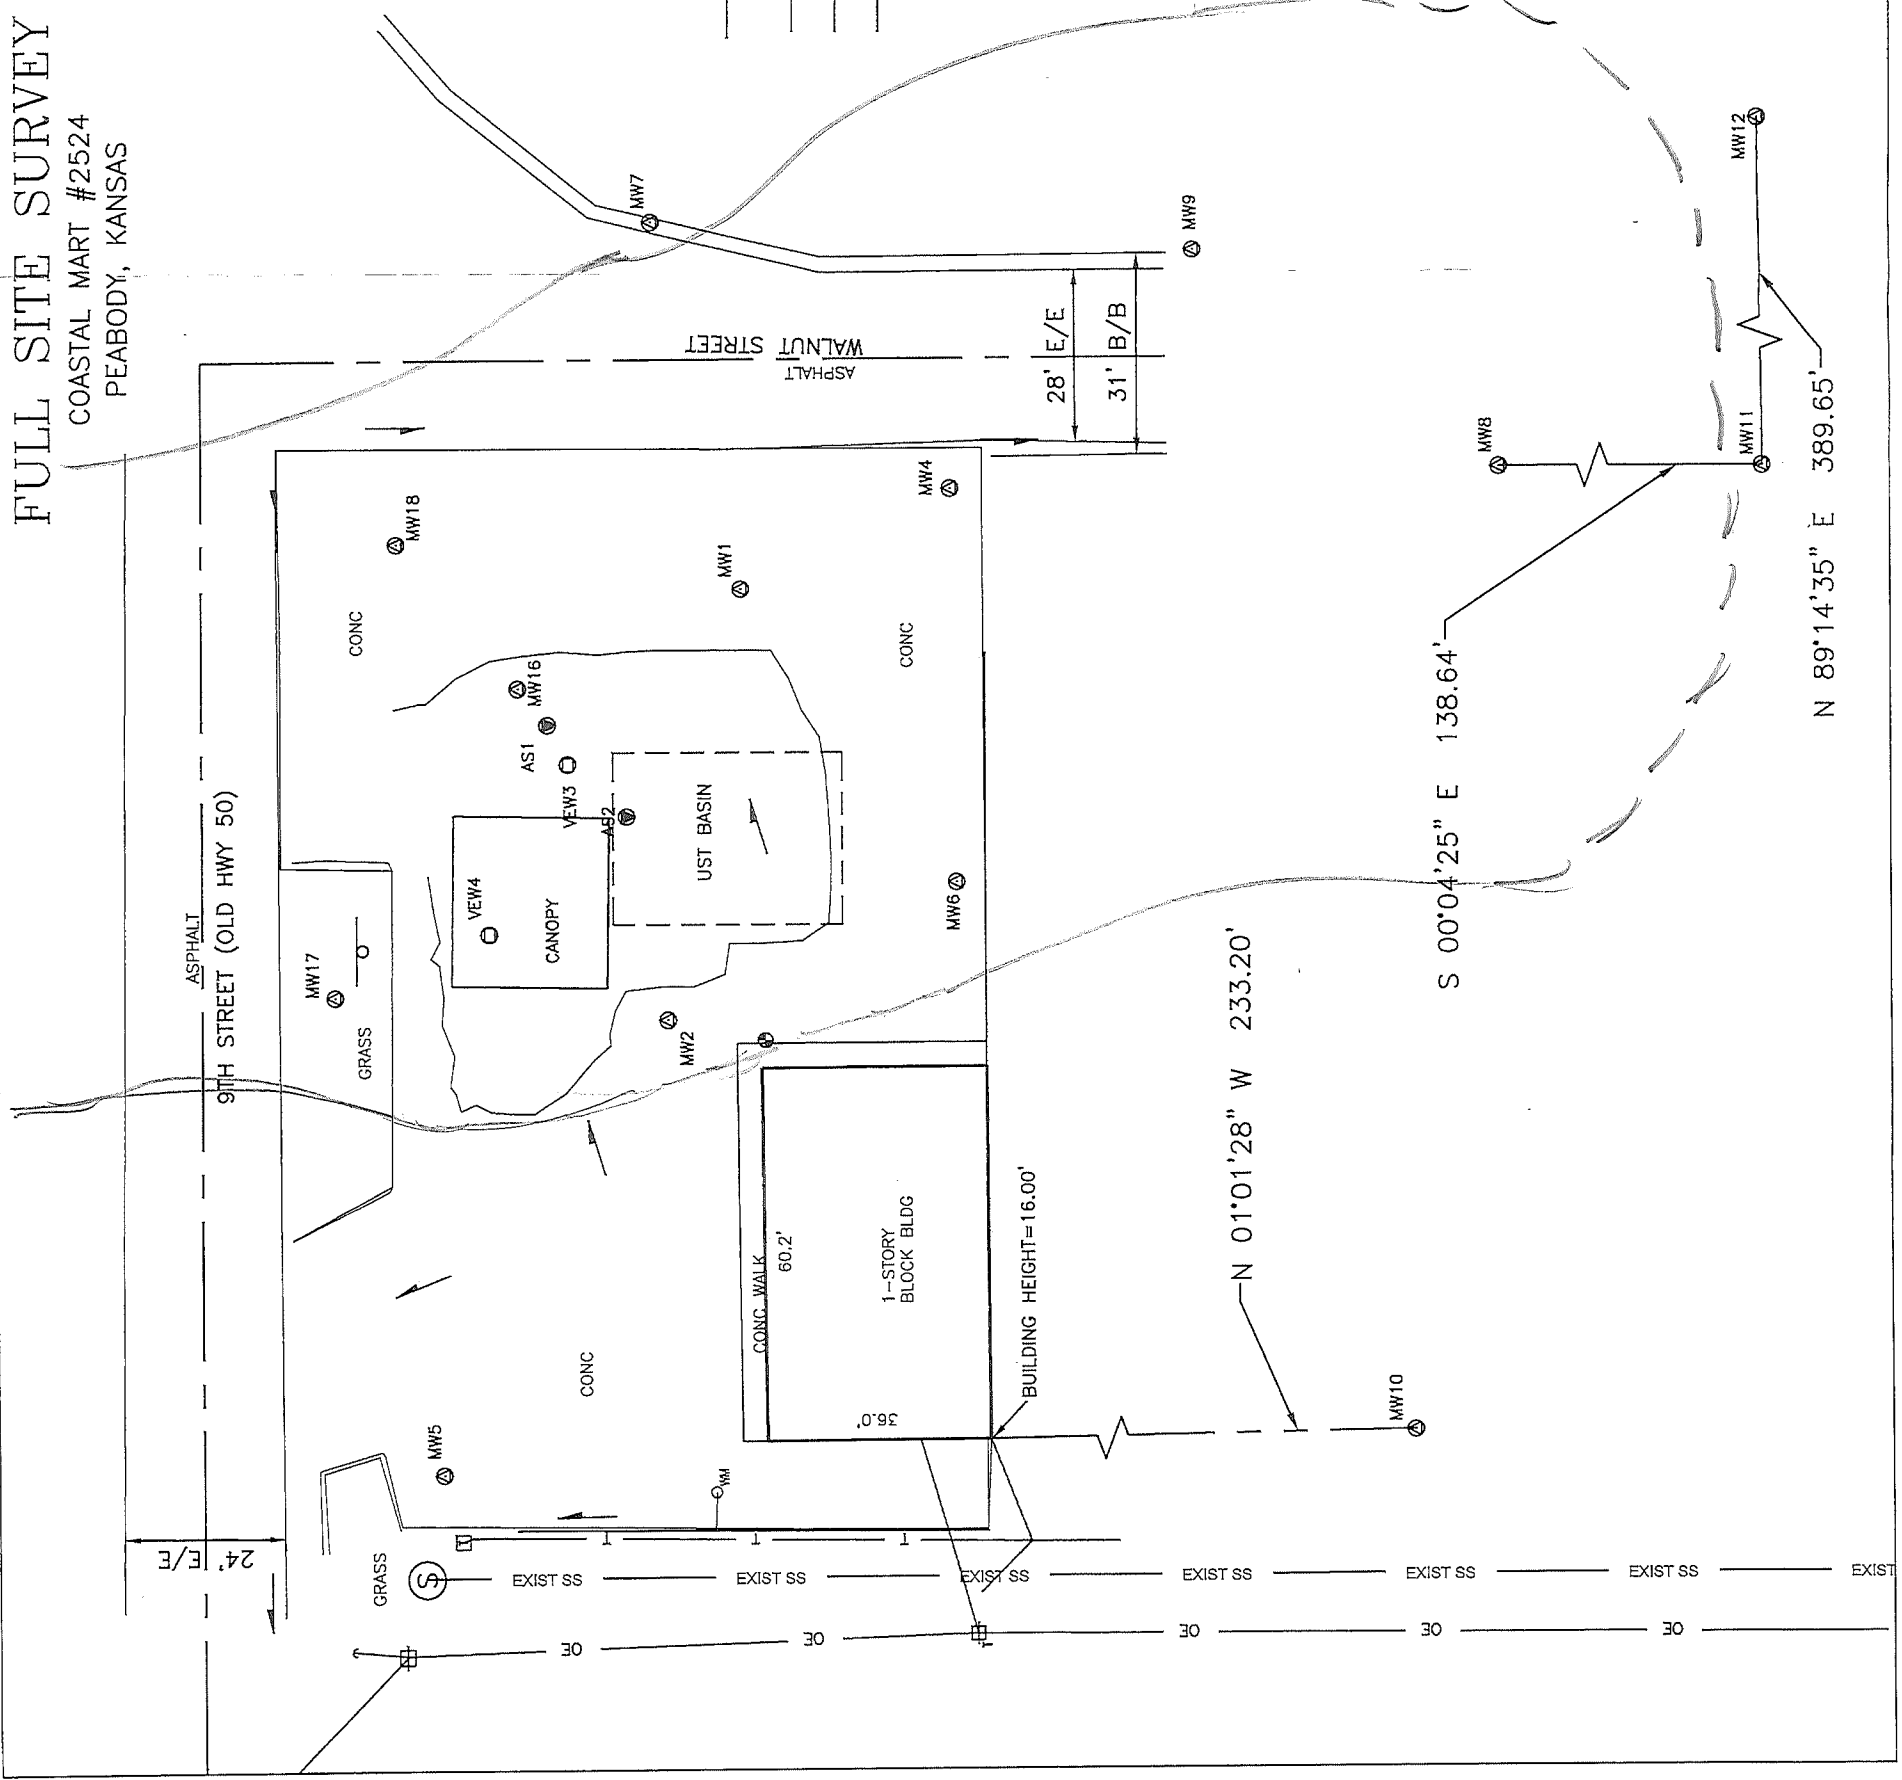


FIGURE 1.3

