

WATER WELL RECORD Form WWC-5

Original Record Correction Change in Well Use

Division of Water Resources App. No.

Well ID

MW8

1 LOCATION OF WATER WELL: County: **MARION** Fraction **NW¼ NW¼ NW¼ SE¼** Section Number **4** Township Number **T 22 S** Range Number **R 3 E W**

2 WELL OWNER: Last Name: **KDHE BER** First: **Address: 1000 SW JACKSON** City: **TOPEKA** State: **KS** ZIP: **66612-1367** Street or Rural Address where well is located (if unknown, distance and direction from nearest town or intersection): If at owner's address, check here: **201 N. Walnut St. Peabody, KS**

3 LOCATE WELL WITH "X" IN SECTION BOX:

N

-- NW --	-- NE --
W	E
-- SW --	-- SE --
S	X

-----1 mile-----

4 DEPTH OF COMPLETED WELL: **20** ft.

Depth(s) Groundwater Encountered: 1) **12** ft. 2) **12.03** ft. 3) **4/3/19** ft., or 4) Dry Well

WELL'S STATIC WATER LEVEL: **12.03** ft.

below land surface, measured on (mo-day-yr) **4/3/19**

above land surface, measured on (mo-day-yr)

Pump test data: Well water was ft. after hours pumping gpm

Well water was ft. after hours pumping gpm

Estimated Yield: gpm

Bore Hole Diameter: **8.5** in. to **20** ft. and in. to ft.

5 Latitude: **38.16638** (decimal degrees)

Longitude: **97.10694** (decimal degrees)

Horizontal Datum: WGS 84 NAD 83 NAD 27

Source for Latitude/Longitude: GPS (unit make/model: (WAAS enabled? Yes No)

Land Survey Topographic Map Online Mapper:

6 Elevation: **1361.75** ft. Ground Level TOC

Source: Land Survey GPS Topographic Map Other

7 WELL WATER TO BE USED AS:

1. Domestic: <input type="checkbox"/> Household <input type="checkbox"/> Lawn & Garden <input type="checkbox"/> Livestock	5. <input type="checkbox"/> Public Water Supply: well ID	10. <input type="checkbox"/> Oil Field Water Supply: lease
2. <input type="checkbox"/> Irrigation	6. <input type="checkbox"/> Dewatering: how many wells?	11. Test Hole: well ID
3. <input type="checkbox"/> Feedlot	7. <input type="checkbox"/> Aquifer Recharge: well ID	<input type="checkbox"/> Cased <input type="checkbox"/> Uncased <input type="checkbox"/> Geotechnical
4. <input type="checkbox"/> Industrial	8. <input checked="" type="checkbox"/> Monitoring: well ID MW8	12. Geothermal: how many bores?
	9. Environmental Remediation: well ID	a) Closed Loop <input type="checkbox"/> Horizontal <input type="checkbox"/> Vertical
	<input type="checkbox"/> Air Sparge <input type="checkbox"/> Soil Vapor Extraction	b) Open Loop <input type="checkbox"/> Surface Discharge <input type="checkbox"/> Inj. of Water
	<input type="checkbox"/> Recovery <input type="checkbox"/> Injection	13. <input type="checkbox"/> Other (specify):

Was a chemical/bacteriological sample submitted to KDHE? Yes No If yes, date sample was submitted:

Water well disinfected? Yes No

8 TYPE OF CASING USED: Steel PVC Other CASING JOINTS: Glued Clamped Welded Threaded

Casing diameter **2** in. to **20** ft., Diameter in. to ft., Diameter in. to ft.

Casing height above land surface **0** in. Weight lbs./ft. Wall thickness or gauge No. **SCH40**

TYPE OF SCREEN OR PERFORATION MATERIAL: Steel Stainless Steel Fiberglass PVC Other (Specify)

Brass Galvanized Steel Concrete tile None used (open hole)

SCREEN OR PERFORATION OPENINGS ARE: Continuous Slot Mill Slot Gauze Wrapped Torch Cut Drilled Holes Other (Specify)

Louvered Shutter Key Punched Wire Wrapped Saw Cut None (Open Hole)

SCREEN-PERFORATED INTERVALS: From **10** ft. to **20** ft., From ft. to ft., From ft. to ft.

GRAVEL PACK INTERVALS: From **8** ft. to **20** ft., From ft. to ft., From ft. to ft.

9 GROUT MATERIAL: Neat cement Cement grout Bentonite Other

Grout Intervals: From **1** ft. to **6** ft., From **6** ft. to **8** ft., From ft. to ft.

Nearest source of possible contamination:


<input type="checkbox"/> Septic Tank	<input type="checkbox"/> Lateral Lines	<input type="checkbox"/> Pit Privy	<input type="checkbox"/> Livestock Pens	<input type="checkbox"/> Insecticide Storage
<input type="checkbox"/> Sewer Lines	<input type="checkbox"/> Cess Pool	<input type="checkbox"/> Sewage Lagoon	<input type="checkbox"/> Fuel Storage	<input type="checkbox"/> Abandoned Water Well
<input type="checkbox"/> Watertight Sewer Lines	<input type="checkbox"/> Seepage Pit	<input type="checkbox"/> Feedyard	<input type="checkbox"/> Fertilizer Storage	<input type="checkbox"/> Oil Well/Gas Well
<input type="checkbox"/> Other (Specify)				

Direction from well? Distance from well? ft.

10 FROM	TO	LITHOLOGIC LOG	FROM	TO	LITHO. LOG (cont.) or PLUGGING INTERVALS
0	0.5	Asphalt			
0.5	12.5	Silty Clay			
12.5	13	Limestone			
13	20	Silty Clay			

Notes:

11 CONTRACTOR'S OR LANDOWNER'S CERTIFICATION: This water well was constructed, reconstructed, or plugged under my jurisdiction and was completed on (mo-day-year) **3-20-19** and this record is true to the best of my knowledge and belief. Kansas Water Well Contractor's License No. **585** This Water Well Record was completed on (mo-day-year) **4-15-19** under the business name of **ASSOCIATED ENVIRONMENTAL INC.** Signature *[Signature]*

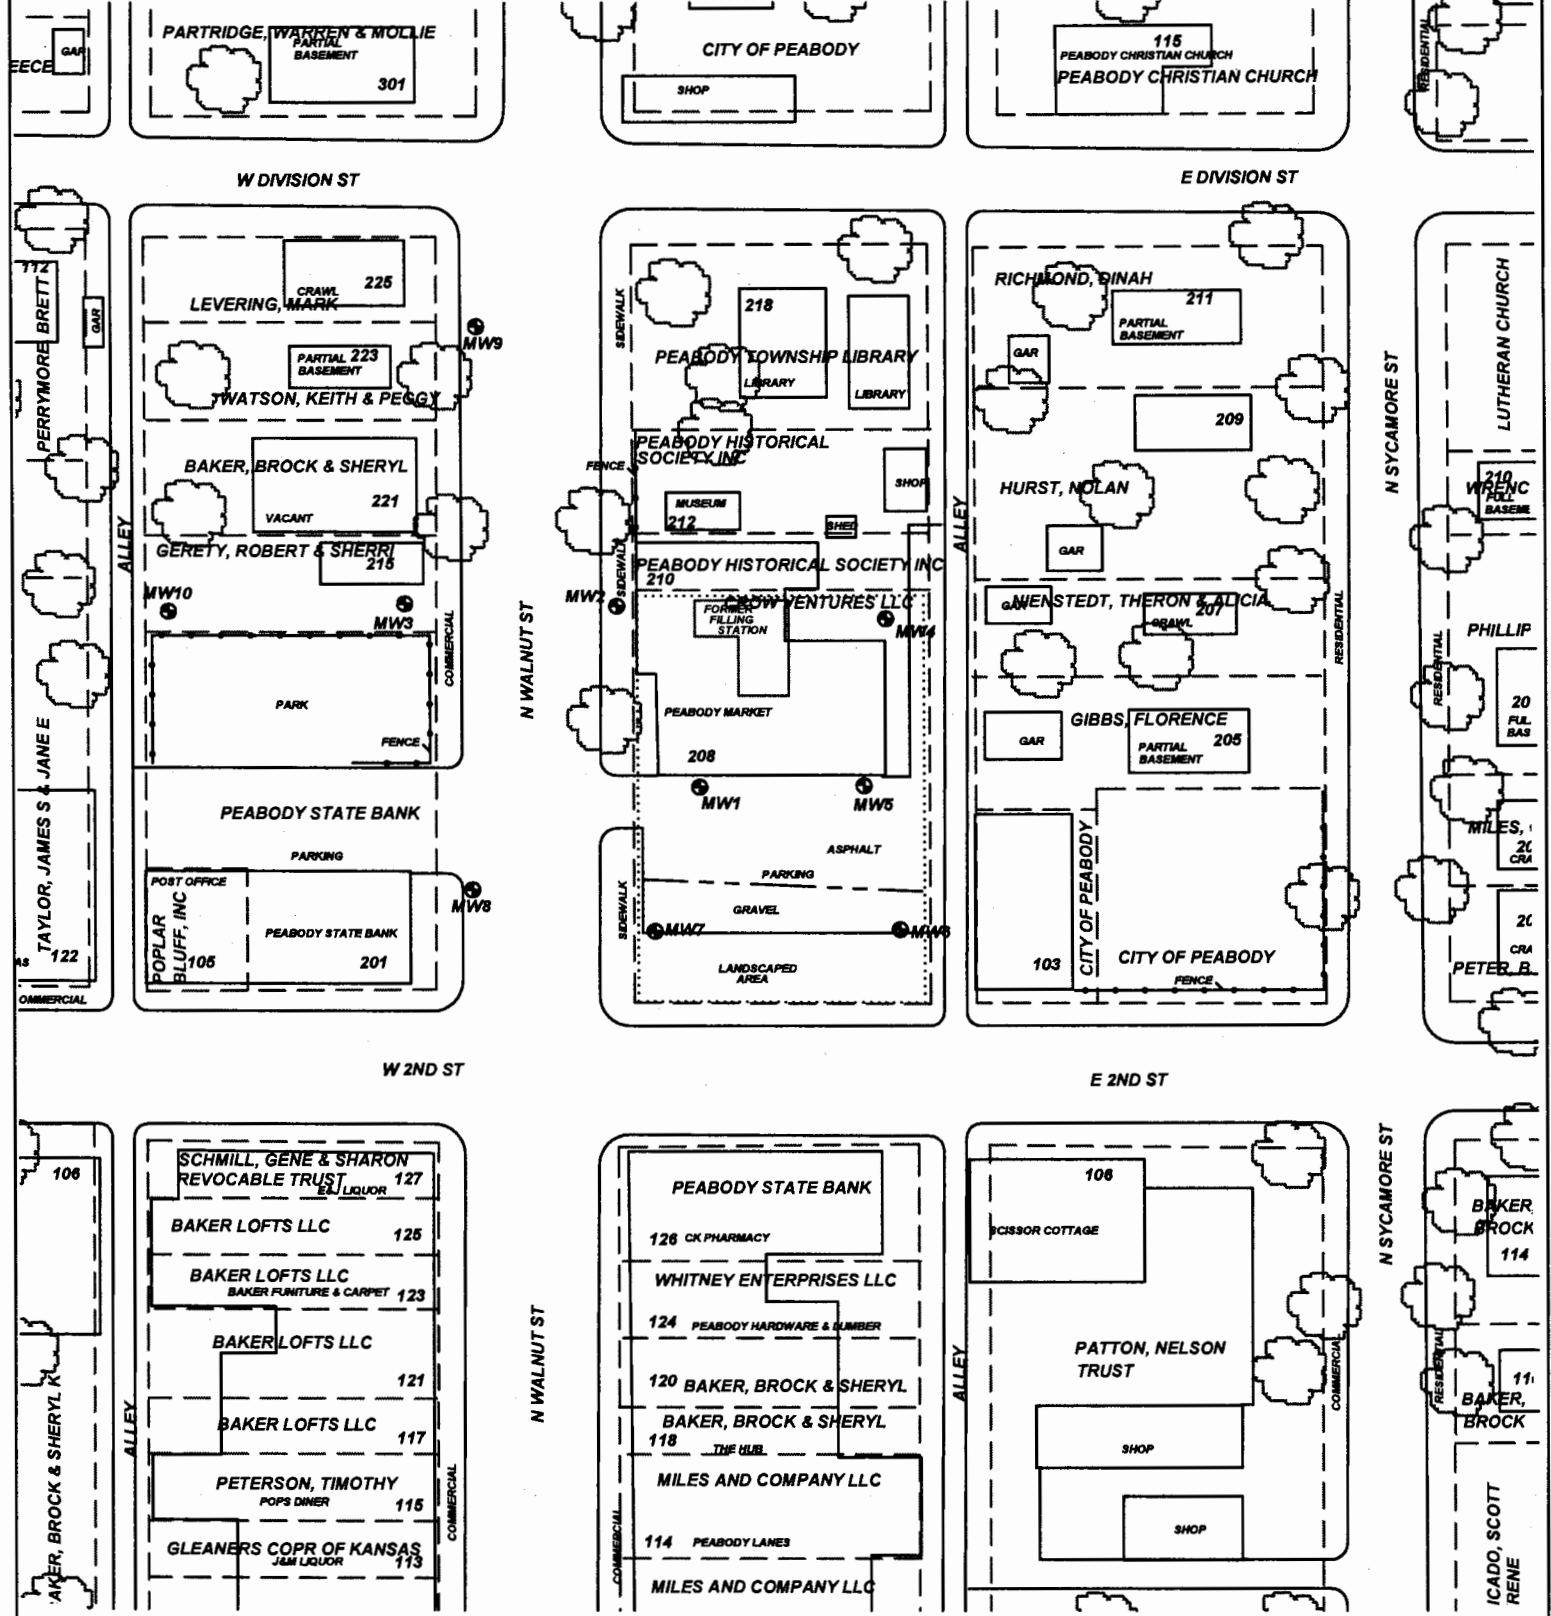

PROJECT: FORMER FILLING STATION-PEABODY

ADDRESS: 208 N. WALNUT ST.

LOCATION: PEABODY, KS

DRAWN BY: B. STALNAKER **DATE:** 11/6/16

REVISED BY: C. ROE **DATE:** 3/27/19

AEI JOB #: TM218 **KDHE JOB #:** U5-057-14895

SCALE: 1" = 100'

NOTES:

TITLE: **FIGURE 2.1**
AREA BASE MAP
350' RADIUS

ASSOCIATED ENVIRONMENTAL INC.

LEGEND:

- = SUBJECT PROPERTY
- - - - - = PARCEL BOUNDARY
- ⊙ = MONITOR WELL

