
			rm WWC-5		vision of Water	I	MW-29d	
			Change in Well Use		ources App. No		Well ID	
	y: Sedgwid	WATER WELL:	Fraction SW 1/4 SE 1/4 NE 1/2		ction Number 15	Township Numb		
	OWNER:						R 1 E W	
		acific Railroad	First:		Street or Rural Address where well is located (if unknown, distance and direction from nearest town or intersection): If at owner's address, check here:			
Address:		52nd Ave.						
Address: N					Murdock & Spruce, Wichita			
City: Denver State: CO ZIP: 80221								
3 LOCATE WELL 4 DEPTH OF COMPLETED WELL:					5 Latitue	37.6976	60 (desired dermos)	
Donth(c) Groundwater E			vater Encountered: 1)1					
SECTION BOX.			t. 3) ft., or 4)				4 \(\sum \) NAD 83 \(\sum \) NAD 27	
WELL'S STATIC WAT			WATER LEVEL:	EVEL: ft. Source for				
			rface, measured on (mo-day				······)	
			rface, measured on (mo-day		.	(WAAS enabled? □		
Pump test data: Well w							aphic Map	
37-11			hours pumping				Earth	
			Vell water washours pumping					
Estimated Yield:				. gpm	6 Elevati	on:ft	. ☐ Ground Level ☐ TOC	
	S	Bore Hole Diamete	er:8 in. to38	ft. and			GPS Topographic Map	
1	mile		2 in. to40	ft.			_ 1 5 1 1	
7 WELL WATER TO BE USED AS:								
1. Domestic			c Water Supply: well ID		10. 🔲 Oil	Field Water Supply: 16	ease	
☐ House	☐ Household 6. ☐ Dewatering: how many wells							
· —	☐ Lawn & Garden 7. ☐ Aquifer Re			Cased Uncased Geotechnical				
Livest			fer Recharge: well ID toring: well ID					
	2. Irrigation 9. Environmental Remediation:				,			
3. Feedlot Air Sparge				Extraction b) Open Loop Surface Discharge Inj. of Water 13. Other (specify):				
4. Indust		☐ Recov						
Was a chemical/bacteriological sample submitted to KDHE? ☐ Yes ■ No If yes, date sample was submitted:								
Water well disinfected? ☐ Yes ■ No								
8 TYPE OF CASING USED: ☐ Steel ■ PVC ☐ Other								
Casing diameter								
Casing height above land surface								
TYPE OF SCREEN OR PERFORATION MATERIAL:								
☐ Steel ☐ Stainless Steel ☐ Fiberglass ☐ PVC ☐ Other (Specify)								
SCREEN OR PERFORATION OPENINGS ARE:								
☐ Continuous Slot								
☐ Louvered Shutter ☐ Key Punched ☐ Wire Wrapped ☐ Saw Cut ☐ None (Open Hole)								
SCREEN-PERFORATED INTERVALS: From .28								
GRAVEL PACK INTERVALS: From								
9 GROUT MATERIAL: Neat cement Cement Bentonite Other Concrete								
Grout Intervals: From								
Nearest source of possible contamination:								
☐ Septic		☐ Lateral			Livestock Pens		cide Storage	
Sewer		Cess Po			Fuel Storage		oned Water Well	
		nes			Fertilizer Stora	ge ∐ Oil We	ll/Gas Well	
☐ Other (Specify)								
10 FROM	TO		LOGIC LOG	FROM			PLUGGING INTERVALS	
10 FROM		Grass, topsoil	LOUIC LOU	TROM	10 1	inio. Log (cont.) of	I LOUGING INTERVALS	
0.5		Clay, silty						
5		Silt, Beige Brown		— ——				
7.5		Sand, f, silty, Beige		 				
12.5		Clay, silty, Beige						
15		Sand, f, silty	Ciay Will. Glay	+			,	
17.5		Sand, i, silty Sand, m-c		Notes:	l			
38.5			V	- Notes.				
38.5 40 Shale, wthrd., Gray								
11 CONTRACTOR'S OR LANDOWNER'S CERTIFICATION: This water well was constructed, reconstructed, or plugged								
under my jurisdiction and was completed on (mo-day-year) 1/24/2018 and this record is true to the best of my knowledge and belief								
Kansas Water Well Contractor's License No. 527 This Water Well Record was completed on (mo-day-year) 1/29/2018								
under the business name of Geocore inc.								
Mail 1 white copy along with a fee of \$5.00 for each constructed well to: Kansas Department of Health and Environment, Bureau of Water, GWTS Section,								
1000 SW Jackson St., Suite 420, Topeka, Kansas 66612-1367. Mail one to Water Well Owner and retain one for your records. Telephone 785-296-5524.								
Visit us at http://www.kdheks.gov/waterwell/index.html KSA 82a-1212 Revised 7/10/2015								

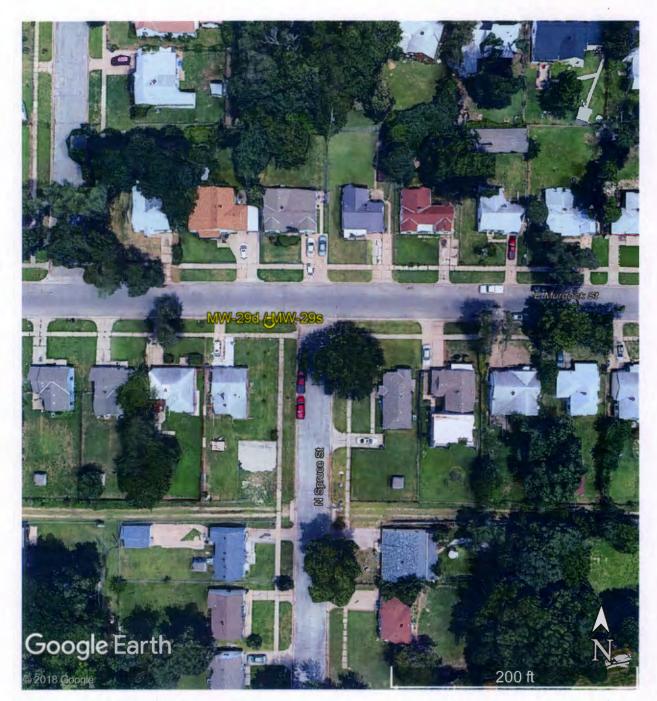

Project Name: 29th & Grove, Wichita (Arcadis)

For Union Pacific Railroad

Location: Murdock & Spruce, Wichita

GPS Coordinates:

MW-29d and MW-29s: 37.697660, -97.309454

RECEIVED

FEB 09 2018

BUREAU OF WATER