

		RECORD	Form '	WWC-5		Divis	sion of Water			MW-5		
				ge in Well Use			irces App. No		Well ID			
		WATER WEI	LL:	Fraction		Sect	ion Number 4			nge Number		
County: 1 de 7 de 7								T 26 S		8 me□w		
2 WELL OWNER: Last Name: First: Street or Rural Address where well is located (if unknown, distance and												
Business: Greenfield Environmental Multistate Trust LLC Address: 1400 Village Square Boulevard, Suite 3-144										спеск пете:		
Address: Former Kerr-McGee #6311												
City:	Tallahas	see	State: FL	ZIP: 32312	617 S. S	th S	treet, Humi	ooldt, KS 66748				
3 LOCATE WELL 4 DEPTH OF COMPLETED WELL:										(decimal degrage)		
With A III Doubles Consumbration Engagement 1) A T to 3 OF 42505										(decimal degrees)		
	ON BOX: N	2)!	VA ft.	3)N/A ft., or 4)	Dry We	:il	Horizon	ntal Datum: WGS 8	4 D NAD	83 D NAD 27		
WELL'S STATIC WATER LEVEL: ft. Source for Latitude/Longitude:												
	below land surface, measured on (mo-day-yr)											
NW	above land surface, measured on (mo-day-yr)						(111-111 111111111111111111111111111111					
	Pump test data: Well water was						☐ Land Survey ☐ Topographic Map Conline Mapper:					
W	I I I WEIWHEIWH INCLU							ime mapper:	• • • • • • • • • • • • • • • • • • • •			
sw	after N/A hours pumping N/A grom							067				
	N Estimated Yield: N/A onm						6 Elevation: 967 ft. ■ Ground Level □ TOC					
	S Bore Hole Diameter:6.0 in. to51.0 ft.						Source: Land Survey GPS Topographic Map					
1 mile												
7 WELL WATER TO BE USED AS:												
1. Domestic												
	Lawn & Garden 7. ☐ Aquifer Recharge: well ID Livestock 8. ■ Monitoring: well ID						12. Geothermal: how many bores?					
2. Irrigat							a) Closed Loop Horizontal Vertical					
	3. 🗌 Feedlot 🔲 Air Sparge 🔲 Soil Vapor Extracti						b) Open Loop Surface Discharge Inj. of Water					
4. 🔲 Indust	rial		Recovery	☐ Injection			13. 🔲 Oth	er (specify):				
Was a chemical/bacteriological sample submitted to KDHE? Tes No If yes, date sample was submitted:												
Water well disinfected? ☐ Yes ■ No												
8 TYPE OF CASING USED: Steel PVC Other CASING JOINTS: Glued Clamped Welded Threaded												
Casing diameter 2 in. to 51.0 ft., Diameter N/A in. to N/A ft., Diameter N/A in. to N/A ft. Casing height above land surface 0 in. Weight N/A lbs/ft. Wall thickness or gauge No. Sch. 40												
TYPE OF SCREEN OR PERFORATION MATERIAL:												
Steel ☐ Stainless Steel ☐ Fiberglass ■ PVC ☐ Other (Specify)												
☐ Brass ☐ Galvanized Steel ☐ Concrete tile ☐ None used (open hole)												
SCREEN OR PERFORATION OPENINGS ARE:												
☐ Continuous Slot												
☐ Louvered Shutter ☐ Key Punched ☐ Wire Wrapped ☐ Saw Cut ☐ None (Open Hole)												
SCREEN-PERFORATED INTERVALS: From 31.0 ft. to 51.0 ft., From NA ft. to N/A ft., From NA ft. to N/A ft.												
GRAVEL PACK INTERVALS: From 29.0. ft. to 51.0 ft., From N/A ft. to N/A ft., From N/A ft. to N/A ft.												
9 GROUT MATERIAL: ☐ Neat cement ☐ Cement grout ☐ Bentonite ☐ Other Concrete 0 to 2												
Grout Intervals: From												
				ec □ Dit Deiva		Пτ	ivestock Den	a 🗆 Insecti	ioida Storage	•		
□ Septic Tank □ Lateral Lines □ Pit Privy □ Livestock Pens □ Insecticide Storage □ Sewer Lines □ Cess Pool □ Sewage Lagoon ■ Fuel Storage □ Abandoned Water Well												
□ Watertight Sewer Lines □ Seepage Pit □ Feedyard □ Fertilizer Storage □ Oil Well/Gas.Well												
Other (Specify) Direction from well? .SW. Distance from well? .45. ft.												
Direction fr												
10 FROM	TO		LITHOLO		FRO	M	TO I	LITHO. LOG (cont.) o	r PLUGGIN	G INTERVALS		
7	7	Grass/Fill (h	ydro-vac)									
49	49 51	<u>Limestone</u>										
1-7-3	J 1	Shale										
				····				*				
					Notes	•	L					
												
11 CONTRACTOR'S OR LANDOWNER'S CERTIFICATION: This water well was constructed, reconstructed, or plugged												
under my j	urisdiction	and was comp	leted on (n	no-day-year) .9/28/2	2020	and tl	his record is	true to the best of n	ny knowled	lge and belief.		
Kansas Wa	ater Well Co	ontractor's Lic	ense No	759 This V	Vater Well	Reco	ord was com	bleted on (mo-day-y	/ear) .1Ω <i>l</i> 24	4/2020		
under the b	ousiness nar	ne of KAZEK	ZEDNIΩU	mental LLC		Sig	nature		Votes Citre	Castion		
Mail I white copy along with a fee of \$5.00 for each constructed well to: Kansas Department of Health and Environment, Bureau of Water, GWTS Section, 1000 SW Jackson St., Suite 420, Topeka, Kansas 66612-1367. Mail one to Water Well Owner and retain one for your records. Telephone 785-296-5524.												
1000 SW Jackson St., Suite 420, Topeka, Kansas 66612-1367. Mail one to Water Well Owner and retain one for your records. Telephone 763-290-3524. Visit us at http://www.kdheks.gov/waterwell/index.html KSA 82a-1212 Revised 7/10/2015												





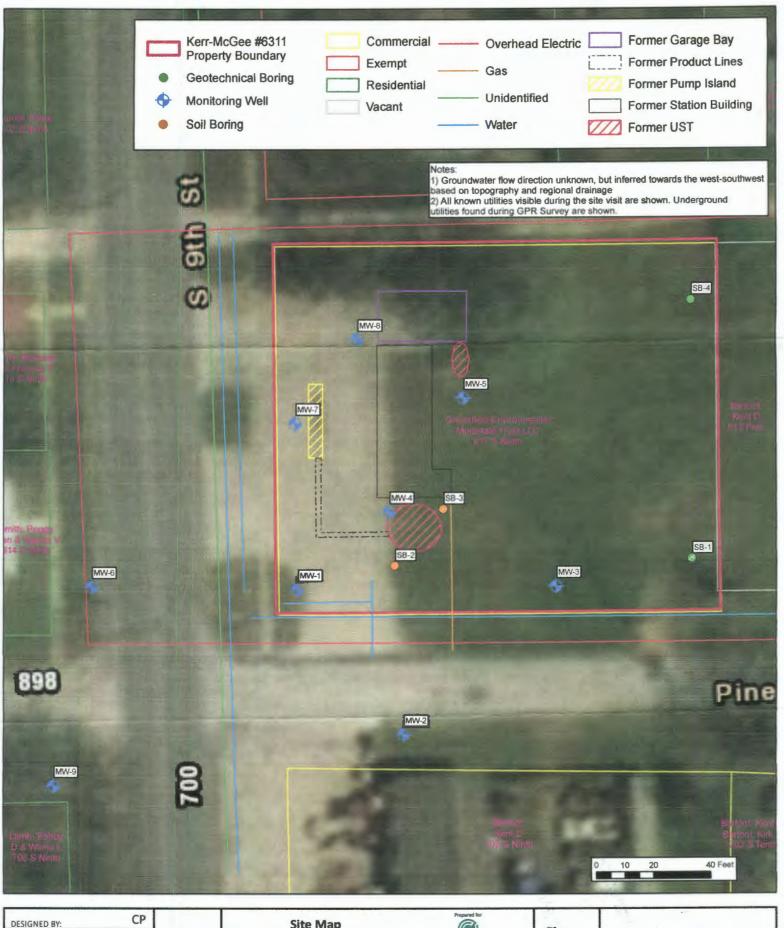

Site Map
Kerr-McGee #6311 - Humboldt

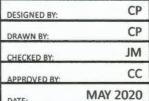



617 S. 9th Street Humboldt, Kansas U3-001-15159 **Figure**

2

Limited Site Assessment Work Plan