
LOCATION OF W				Form WWC-5	KSA 82				
		Fraction	NIE MI		tion Number	1 05		Range N	~~~
	gwick	SW 1/4	NE 1/4 NW	1/4	18	т 27	S	] R I	(E/V)
	n from nearest town o	-	ress of well if located	within city?					
	orial Park in								
WATER WELL O	WNER:	City of							
RR#, St. Address, B		455 N. M					•	Division of Wat	er Resources
city, State, ZIP Code			KS 67202	· = 05			n Number:		
LOCATE WELL'S AN "X" IN SECTION	N De	pth(s) Groundwa	iter Encountered 1.		ft.	2	ft. 3		
l x			ATER LEVEL 2.2 est data: Well water						
1		t. Yield	gpm: Well water	was	ft. a	ifter	. hours pu	mping	gpm
w <del>                                  </del>	<del></del>	re Hole Diamete ELL WATER <b>*(3</b> *	rin.to.			and			π.
	""	1 Domestic	S			9 Dewatering	•	•	h alaus)
SW	SE	2 Irrigation				10 Monitoring we			
1 !	1 1	•	cteriological sample si	-	-				
<u> </u>		ted	cteriological sample si	abilitied to De					ibie was sub
TYPE OF BLANK	X		Wrought iron	9 Canasa		ter Well Disinfect		No	
	3 RMP (SR)		3						
1 Steel 2 PVC	4 ABS		Asbestos-Cement		specify belo	•		ed	
	4 ABS er 24 in.		Fiberglass					aded	
	land surface 9 b								
			., weight						
	OR PERFORATION M		. =	7 PV(			bestos-ceme		
1 Steel	3 Stainless ste		Fiberglass		P (SR)				• • • • • • • • •
2 Brass	4 Galvanized		Concrete tile	9 ABS	5		ne used (op	•	
	DRATION OPENINGS			d wrapped		8 Saw cut		11 None (ope	en hole)
1 Continuous s			6 Wire w			9 Drilled holes			
2 Louvered shu	, ,		7 Torch			10 Other (speci	• /		
CREEN-PERFORA			ft. to						
		From	4 1-						
GRAVEL P			ft. to		ft., Fro				
GRAVEL P	ACK INTERVALS:				ft., Fro	m	ft. t	o <i></i>	
GROUT MATERIA	ACK INTERVALS:	From 2	ft. to  ft. to  Cement grout	3 Bentor	ft., Fro	m	ft. t	0	
GROUT MATERIA	ACK INTERVALS:  1 Neat cem 22.3	From 2 to 9.0	ft. to ft. to	3 Bentor	ft., Fro	m	ft. t	o	
GROUT MATERIA Grout Intervals: Frout Intervals: Frout Intervals: Frout Intervals: Frout Intervals In	ACK INTERVALS:  1 Neat cem om 22.3 ft.	From ent 2 to 9.0 tamination:	ft. to	3 Bentor	ft., Fro ft., Fro nite 4 o	m Otherft., From .tock pens	ft. t	oo  ft. to bandoned wate	ft
GROUT MATERIA Grout Intervals: Fr	ACK INTERVALS:  1 Neat cem 22.3	From ent 2 to 9.0 tamination:	ft. to  ft. to  Cement grout	3 Bentor	ft., Fro ft., Fro nite 4	m Other	ft. t	o	ftftft
GROUT MATERIA frout Intervals: From that is the nearest of 1 Septic tank 2 Sewer lines	ACK INTERVALS:  1 Neat cem 22.3 ft.  source of possible con 4 Lateral li 5 Cess poo	From 2 to 9.0 tamination: nes	ft. to	3 Bentor	ft., Fro ft., Fro nite 4 o 10 Lives 11 Fuel	m Other	14 Al	oft. tobandoned water il well/Gas well ther (specify be	ft. ft. ft. er well
GROUT MATERIA frout Intervals: Frout Intervals: Fro	ACK INTERVALS:  1 Neat cem 22.3 ft.  source of possible con 4 Lateral lie	From 2 to 9.0 tamination: nes	ft. to ft. to  Cement grout ft., From 7 Pit privy	3 Bentor	ft., Fro ft., Fro nite 4 o	m Other	14 A 15 O 16 O	oo  ft. to bandoned wate	ft. ft. ft. er well
GROUT MATERIA Grout Intervals: Frout Intervals: Fro	ACK INTERVALS:  1 Neat cem 22.3 ft.  source of possible con 4 Lateral lii 5 Cess poc wer lines 6 Seepage west	From.  From  ent 2 to 9.0  tamination: nes ol pit	Cement grout  ft. to  Cement grout  ft., From  7 Pit privy 8 Sewage lagor 9 Feedyard	3 Bentor ft. t	nite 4 o	m Other	14 A 15 O 16 O R	o	ft. ft. ft. er well
GROUT MATERIA Grout Intervals: Frout Intervals: Fro	ACK INTERVALS:  1 Neat cem 22.3 ft.  source of possible con 4 Lateral lii 5 Cess poc wer lines 6 Seepage west	From 2 to 9.0 tamination: nes	Cement grout  ft. to  Cement grout  ft., From  7 Pit privy 8 Sewage lagor 9 Feedyard	3 Bentor ft. t	ft., Fro ft., Fro ft., Fro nite 4 o	m Other	14 Al 15 O 16 O R	o	ft. ft. ft. er well
GROUT MATERIA Grout Intervals: Frout Intervals: Fro	ACK INTERVALS:  1 Neat cem 22.3 ft.  source of possible con 4 Lateral lii 5 Cess poc wer lines 6 Seepage west	From.  From  ent 2 to 9.0  tamination: nes ol pit	Cement grout  ft. to  Cement grout  ft., From  7 Pit privy 8 Sewage lagor 9 Feedyard	3 Bentor ft. t	nite 4 o	other	14 Al 15 O 16 O R LUGGING II	o	ft. ft. ft. er well
GROUT MATERIA Grout Intervals: Frout Intervals: Fro	ACK INTERVALS:  1 Neat cem 22.3 ft.  Source of possible con 4 Lateral lii 5 Cess poc wer lines 6 Seepage West	From. From ent 2 to 9.0 ttamination: nes of pit	ft. to ft. to ft. to Cement grout ft., From 7 Pit privy 8 Sewage lagor 9 Feedyard	3 Bentor ft. t	ft., Fro ft., Fro ft., Fro nite 4 o	m Other	14 Al 15 O 16 O R LUGGING II	o	ft. ft. ft. er well
GROUT MATERIA Grout Intervals: Frout Intervals: Fro	ACK INTERVALS:  1 Neat cem 22.3 ft.  Source of possible con 4 Lateral lii 5 Cess poo wer lines 6 Seepage West  *The abandon	From. From ent 2 to 9.0 ttamination: nes of pit  LITHOLOGIC LC	ft. to ft. to ft. to Cement grout ft., From 7 Pit privy 8 Sewage lagor 9 Feedyard	3 Bentor ft. t	nite 4 o	other	14 Al 15 O 16 O R LUGGING II	o	ft. ft. ft. er well
GROUT MATERIA Grout Intervals: Frout Intervals: Fro	ACK INTERVALS:  1 Neat cem 22.3 ft.  Source of possible con 4 Lateral lii 5 Cess poo wer lines 6 Seepage west  *The abandon demolished	From. From ent 2 to 9.0 Itamination: nes of pit  LITHOLOGIC LC ned well v by others	ft. to ft. to ft. to Cement grout ft., From 7 Pit privy 8 Sewage lagor 9 Feedyard G ault was The top of	3 Bentor ft. t	nite 4 o	other	14 Al 15 O 16 O R LUGGING II	o	ft. ft. ft. er well
GROUT MATERIA Grout Intervals: Frout Intervals: Fro	ACK INTERVALS:  1 Neat cem 22.3 ft.  Source of possible con 4 Lateral lii 5 Cess poo wer lines 6 Seepage west  *The abandor demolished casing was	From. From ent 2 to 9.0 tamination: nes of pit  LITHOLOGIC LC  ned well v by others 9.0 belo	ft. to ft. to ft. to Cement grout ft., From 7 Pit privy 8 Sewage lagor 9 Feedyard G ault was The top of wexisting	3 Bentor ft. t	nite 4 o	other	14 Al 15 O 16 O R LUGGING II	o	ft. ft. ft. er well
GROUT MATERIA frout Intervals: Fro /hat is the nearest so 1 Septic tank 2 Sewer lines 3 Watertight se	ACK INTERVALS:  1 Neat cem 22.3 ft.  Source of possible con 4 Lateral lii 5 Cess poo wer lines 6 Seepage west  *The abandor demolished casing was ground leve	From  From  ent 2 to 9.0 tamination: nes of pit  LITHOLOGIC LC  ned well v by others 9.0' belo el. All d	ft. to ft. to ft. to Cement grout ft., From 7 Pit privy 8 Sewage lagor 9 Feedyard G ault was The top of wexisting	3 Bentor ft. t	nite 4 o	other	14 Al 15 O 16 O R. LUGGING II	o	ft. ft. ft. er well
GROUT MATERIA frout Intervals: Fro /hat is the nearest so 1 Septic tank 2 Sewer lines 3 Watertight se irrection from well?	ACK INTERVALS:  1 Neat cem 22.3 ft.  Source of possible con 4 Lateral lii 5 Cess poo wer lines 6 Seepage west  *The abandor demolished casing was	From  From  ent 2 to 9.0 tamination: nes of pit  LITHOLOGIC LC  ned well v by others 9.0' belo el. All d	ft. to ft. to ft. to Cement grout ft., From 7 Pit privy 8 Sewage lagor 9 Feedyard G ault was The top of wexisting	3 Bentor ft. t	nite 4 o	other	14 Al 15 O 16 O R. LUGGING II	o	ft. ft. ft. er well
GROUT MATERIA frout Intervals: Fro /hat is the nearest so 1 Septic tank 2 Sewer lines 3 Watertight se irrection from well?	ACK INTERVALS:  1 Neat cem 22.3 ft.  Source of possible con 4 Lateral lii 5 Cess poo wer lines 6 Seepage west  *The abandor demolished casing was ground leve	From  From  ent 2 to 9.0 tamination: nes of pit  LITHOLOGIC LC  ned well v by others 9.0' belo el. All d	ft. to ft. to ft. to Cement grout ft., From 7 Pit privy 8 Sewage lagor 9 Feedyard G ault was The top of wexisting	3 Bentor ft. t	nite 4 o	other	14 Al 15 O 16 O R. LUGGING II	o	ft. ft. ft. er well
GROUT MATERIA frout Intervals: Fro /hat is the nearest so 1 Septic tank 2 Sewer lines 3 Watertight se	ACK INTERVALS:  1 Neat cem 22.3 ft.  Source of possible con 4 Lateral lii 5 Cess poo wer lines 6 Seepage west  *The abandor demolished casing was ground leve	From  From  ent 2 to 9.0 tamination: nes of pit  LITHOLOGIC LC  ned well v by others 9.0' belo el. All d	ft. to ft. to ft. to Cement grout ft., From 7 Pit privy 8 Sewage lagor 9 Feedyard G ault was The top of wexisting	3 Bentor ft. t	nite 4 o	other	14 Al 15 O 16 O R. LUGGING II	o	ft. ft. ft. er well
GROUT MATERIA frout Intervals: Fro /hat is the nearest so 1 Septic tank 2 Sewer lines 3 Watertight se	ACK INTERVALS:  1 Neat cem 22.3 ft.  Source of possible con 4 Lateral lii 5 Cess poo wer lines 6 Seepage west  *The abandor demolished casing was ground leve	From  From  ent 2 to 9.0 tamination: nes of pit  LITHOLOGIC LC  ned well v by others 9.0' belo el. All d	ft. to ft. to ft. to Cement grout ft., From 7 Pit privy 8 Sewage lagor 9 Feedyard G ault was The top of wexisting	3 Bentor ft. t	nite 4 o	other	14 Al 15 O 16 O R. LUGGING II	o	ft. ft. ft. er well
GROUT MATERIA rout Intervals: Fro that is the nearest: 1 Septic tank 2 Sewer lines 3 Watertight se irection from well?	ACK INTERVALS:  1 Neat cem 22.3 ft.  Source of possible con 4 Lateral lii 5 Cess poo wer lines 6 Seepage west  *The abandor demolished casing was ground leve	From  From  ent 2 to 9.0 tamination: nes of pit  LITHOLOGIC LC  ned well v by others 9.0' belo el. All d	ft. to ft. to ft. to Cement grout ft., From 7 Pit privy 8 Sewage lagor 9 Feedyard G ault was The top of wexisting	3 Bentor ft. t	nite 4 o	other	14 Al 15 O 16 O R. LUGGING II	o	ft. ft. ft. er well
GROUT MATERIA rout Intervals: Fr /hat is the nearest: 1 Septic tank 2 Sewer lines 3 Watertight se irection from well?	ACK INTERVALS:  1 Neat cem 22.3 ft.  Source of possible con 4 Lateral lii 5 Cess poo wer lines 6 Seepage west  *The abandor demolished casing was ground leve	From  From  ent 2 to 9.0 tamination: nes of pit  LITHOLOGIC LC  ned well v by others 9.0' belo el. All d	ft. to ft. to ft. to Cement grout ft., From 7 Pit privy 8 Sewage lagor 9 Feedyard G ault was The top of wexisting	3 Bentor ft. t	nite 4 o	other	14 Al 15 O 16 O R. LUGGING II	o	ft. ft. ft. er well
GROUT MATERIA frout Intervals: Fro /hat is the nearest so 1 Septic tank 2 Sewer lines 3 Watertight se irrection from well?	ACK INTERVALS:  1 Neat cem 22.3 ft.  Source of possible con 4 Lateral lii 5 Cess poo wer lines 6 Seepage west  *The abandor demolished casing was ground leve	From  From  ent 2 to 9.0 tamination: nes of pit  LITHOLOGIC LC  ned well v by others 9.0' belo el. All d	ft. to ft. to ft. to Cement grout ft., From 7 Pit privy 8 Sewage lagor 9 Feedyard G ault was The top of wexisting	3 Bentor ft. t	nite 4 o	other	14 Al 15 O 16 O R. LUGGING II	o	ft. ft. ft. er well
GROUT MATERIA Grout Intervals: Frout Intervals: Fro	ACK INTERVALS:  1 Neat cem 22.3 ft.  Source of possible con 4 Lateral lii 5 Cess poo wer lines 6 Seepage west  *The abandor demolished casing was ground leve	From  From  ent 2 to 9.0 tamination: nes of pit  LITHOLOGIC LC  ned well v by others 9.0' belo el. All d	ft. to ft. to ft. to Cement grout ft., From 7 Pit privy 8 Sewage lagor 9 Feedyard G ault was The top of wexisting	3 Bentor ft. t	nite 4 o	other	14 Al 15 O 16 O R. LUGGING II	o	ft. ft. ft. er well
GROUT MATERIA Grout Intervals: Fro What is the nearest: 1 Septic tank 2 Sewer lines 3 Watertight se Direction from well?	ACK INTERVALS:  1 Neat cem 22.3 ft.  Source of possible con 4 Lateral lii 5 Cess poo wer lines 6 Seepage west  *The abandor demolished casing was ground leve	From  From  ent 2 to 9.0 tamination: nes of pit  LITHOLOGIC LC  ned well v by others 9.0' belo el. All d	ft. to ft. to ft. to Cement grout ft., From 7 Pit privy 8 Sewage lagor 9 Feedyard G ault was The top of wexisting	3 Bentor ft. t	nite 4 o	other	14 Al 15 O 16 O R. LUGGING II	o	ft. ft. ft. er well
GROUT MATERIA  Grout Intervals: From the second of the sec	*The abandor demolished casing was ground level from ground	From  From  ent 2 to 9.0  ttamination: nes bl pit  LITHOLOGIC LC  ned well v by others 9.0' belo el. All d d level.	ft. to ft. to ft. to  Cement grout ft., From  7 Pit privy 8 Sewage lagor 9 Feedyard  G  ault was The top or w existing epths are	3 Benton ft. t	ft., Fro ft.	m Other	14 Al 15 O 16 O R LUGGING II d grave	o	ft. ftftft.
GROUT MATERIA Grout Intervals: Fr What is the nearest s 1 Septic tank 2 Sewer lines 3 Watertight se Direction from well? FROM TO	*The abandor demolished casing was ground level from ground	From From ent 2 to 9.0 Itamination: nes of pit LITHOLOGIC LC ned well v by others 9.0' belo el. All d d level.	ft. to ft. to ft. to  Cement grout ft., From  7 Pit privy 8 Sewage lagor 9 Feedyard  G  ault was The top or w existing epths are	3 Benton ft. t	10 Lives 11 Fuel 12 Fertil 13 Insect How ma TO 22.3 9.0	other	14 Al 15 O 16 O R UUGGING II d grave rout	o	ft. ftft. er well lelow) on and was
GROUT MATERIA Grout Intervals: Fr What is the nearest s 1 Septic tank 2 Sewer lines 3 Watertight se Direction from well? FROM TO	*The abandor demolished casing was ground leve from ground  OR LANDOWNER'S gyyear)  3 -6 -9	From From ent 2 to 9.0 tamination: nes of pit LITHOLOGIC LC ned well v by others 9.0' beloel. All d d level.  CERTIFICATION 97	ft. to ft. to ft. to  Cement grout ft., From  7 Pit privy 8 Sewage lagor 9 Feedyard  G  ault was The top of wexisting epths are	3 Benton ft. t  FROM 47.25 22.3  F  (1) construct	ted, (2) reco	other	14 Al 15 O 16 O R UUGGING II d grave rout	o	on and was
GROUT MATERIA  Grout Intervals: From the second sec	*The abandor demolished casing was ground level from ground	From. From ent 2 to 9.0 Itamination: nes of pit  LITHOLOGIC LC  ned well v by others 9.0' belo el. All d d level.  CERTIFICATION 97 185	ft. to ft. to  Cement grout  ft., From  7 Pit privy 8 Sewage lagor 9 Feedyard  G  ault was The top or w existing epths are	3 Benton ft. t  FROM 47.25 22.3  F  (1) construct	ted, (2) reco	other	14 Al 15 O 16 O R UUGGING II d grave rout	o	ft. ftft. er well lelow) on and was

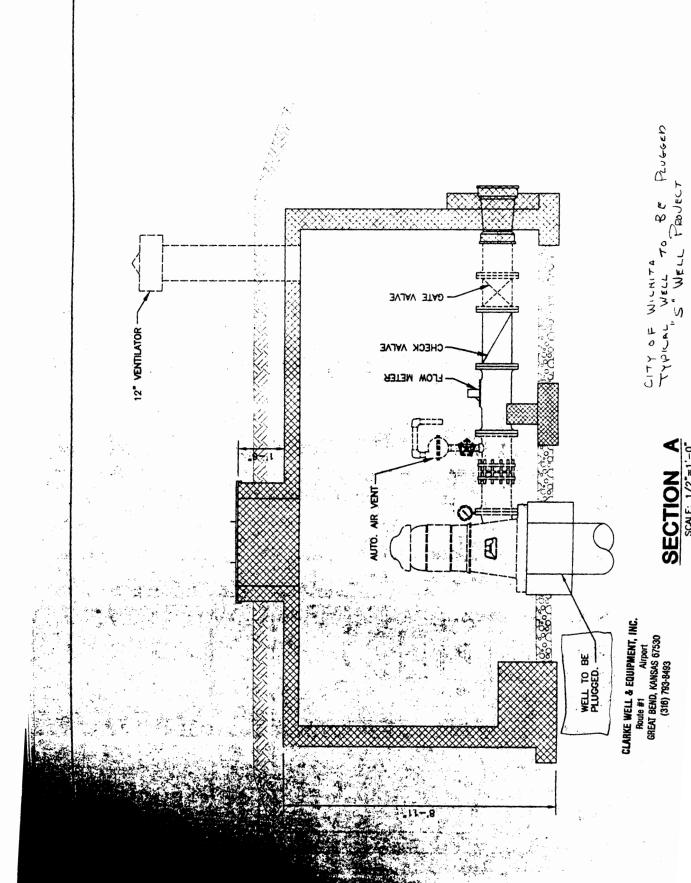

SCALE: 1/2"=1'-0"