

WATER WELL RECORD Form WWC-5

Original Record Correction Change in Well Use

MW-1R

Division of Water Resources App. No.

Well ID

Well ID

1 LOCATION OF WATER WELL: County: Sedgewick Fraction NW 1/4 NW 1/4 NW 1/4 NE 1/4 Section Number 7 Township Number T 27 S Range Number R 1 E W

2 WELL OWNER: Last Name: Phillips 66 Business: Phillips 66 Address: 15604-02 Phillips Bldg. City: Bartlesville State: OK ZIP: 74003 Street or Rural Address where well is located: 1981 W. 21st Street; Wichita, KS

3 LOCATE WELL WITH "X" IN SECTION BOX: N W E S 1 mile

4 DEPTH OF COMPLETED WELL: 28 ft. Depth(s) Groundwater Encountered: 1) ... ft. 2) ... ft. 3) ... ft. or 4) Dry Well WELL'S STATIC WATER LEVEL: Not Taken

5 Latitude: 37.722507 (decimal degrees) Longitude: 97.362688 (decimal degrees) Horizontal Datum: WGS 84

6 Elevation: ... ft. Ground Level TOC Source: GPS Land Survey Topographic Map

7 WELL WATER TO BE USED AS: 1. Domestic 2. Irrigation 3. Feedlot 4. Industrial 5. Public Water Supply 6. Dewatering 7. Aquifer Recharge 8. Monitoring 9. Environmental Remediation 10. Oil Field Water Supply 11. Test Hole 12. Geothermal 13. Other

Was a chemical/bacteriological sample submitted to KDHE? Yes No If yes, date sample was submitted: Water well disinfected? Yes No

8 TYPE OF CASING USED: Steel PVC Other CASING JOINTS: Glued Clamped Welded Threaded Casing diameter 2 in. to 28 ft. Diameter in. to ft. Casing height above land surface 6 in. Weight lbs./ft. Wall thickness or gauge No. Sch. 40

TYPE OF SCREEN OR PERFORATION MATERIAL: Steel Stainless Steel Fiberglass PVC Brass Galvanized Steel Concrete tile None used (open hole) SCREEN OR PERFORATION OPENINGS ARE: Continuous Slot Mill Slot Gauze Wrapped Torch Cut Drilled Holes Other Louvered Shutter Key Punched Wire Wrapped Saw Cut None (Open Hole) SCREEN-PERFORATED INTERVALS: From 13 ft. to 28 ft. GRAVEL PACK INTERVALS: From 11 ft. to 28 ft.


9 GROUT MATERIAL: Neat cement Cement grout Bentonite Other Grout Intervals: From 3 ft. to 11 ft. From ft. to ft.

Nearest source of possible contamination: Septic Tank Lateral Lines Pit Privy Livestock Pens Insecticide Storage Sewer Lines Cess Pool Sewage Lagoon Fuel Storage Abandoned Water Well Watertight Sewer Lines Seepage Pit Feedyard Fertilizer Storage Oil Well/Gas Well Other (Specify) Direction from well? Distance from well? ft.

Table with columns: FROM TO LITHOLOGIC LOG FROM TO LITHO. LOG (cont.) or PLUGGING INTERVALS

Original Returned to Sender for Correction Date:

11 CONTRACTOR'S OR LANDOWNER'S CERTIFICATION: This water well was constructed, reconstructed, or plugged under my jurisdiction and was completed on (mo-day-year) 04/09/2015 and this record is true to the best of my knowledge and belief. Kansas Water Well Contractor's License No. 710 This Water Well Record was completed on (mo-day-year) 5/04/2015 under the business name of Below Ground Surface, Inc.

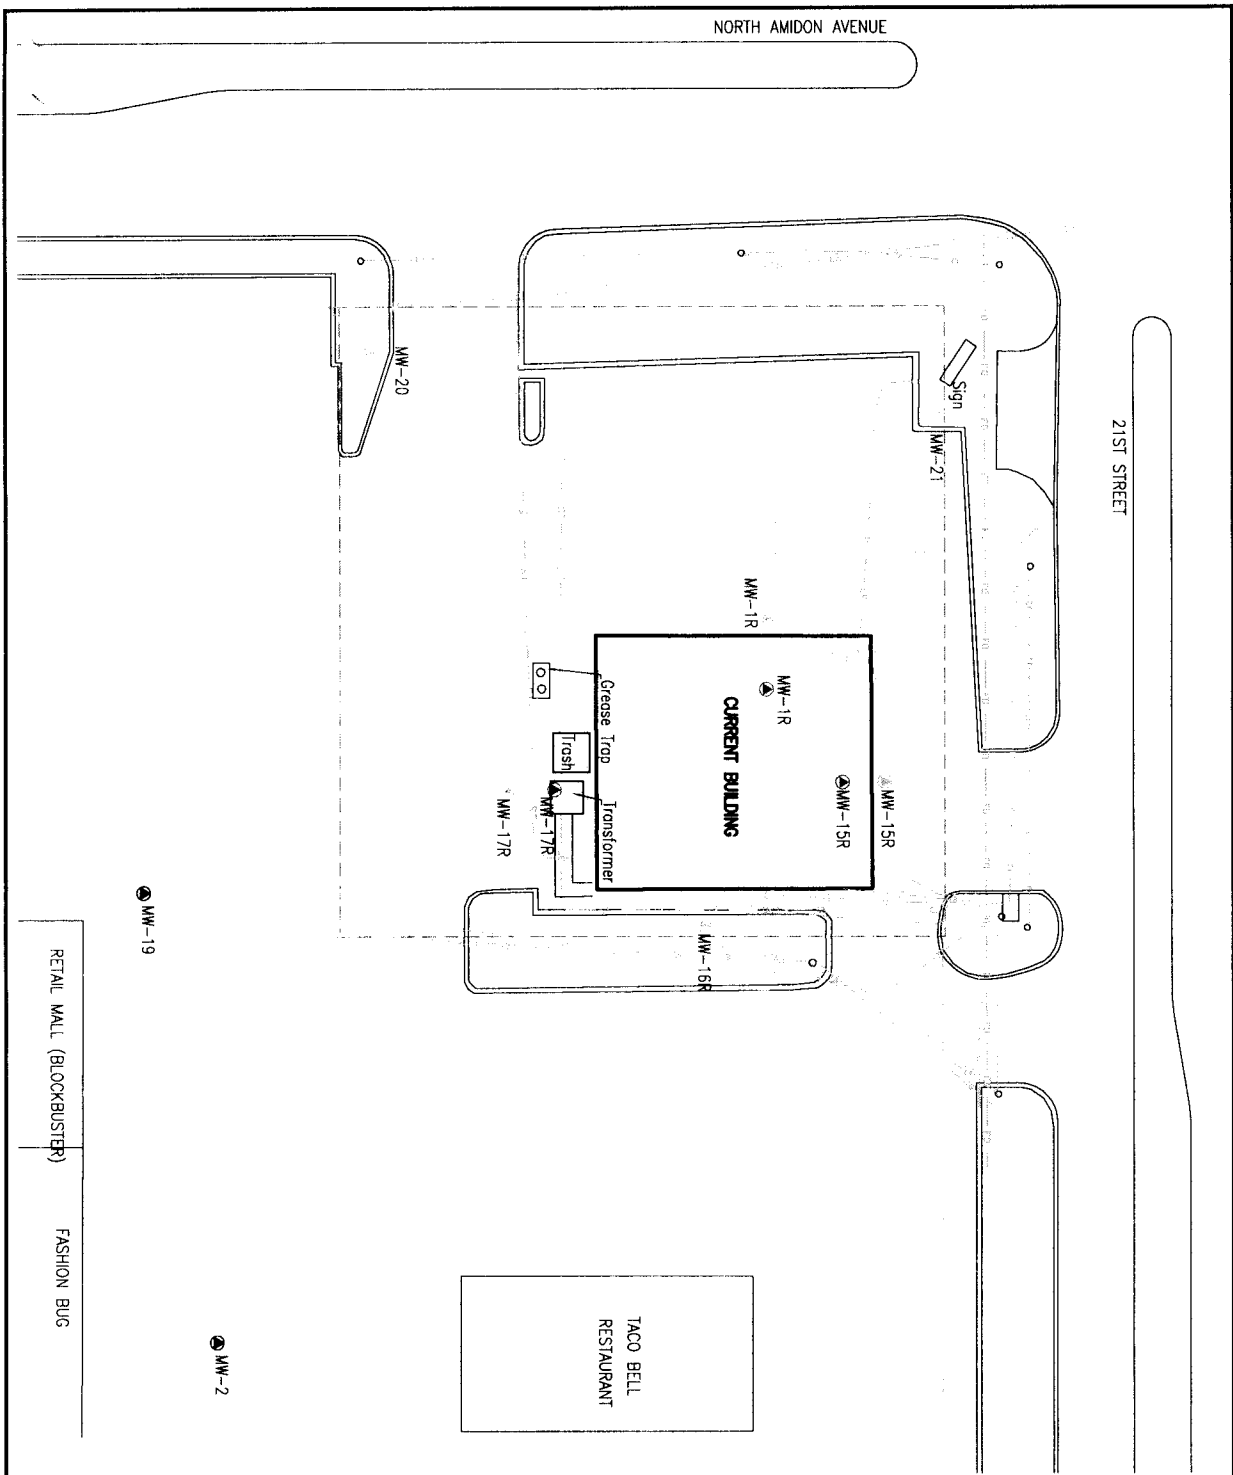

21ST STREET

NORTH AMIDON AVENUE

**LEGEND**

- MODIFIED REPLACEMENT MONITORING WELL LOCATIONS
- ORIGINAL REPLACEMENT MONITORING WELL LOCATIONS
- MONITORING WELL
- ⊕ ABANDONED/DESTROYED MONITORING WELL
- ▨ UST REMOVED (CORROSION)
- ▩ UST REMOVED (NO CORROSION)
- SITE BOUNDARY
- PROPERTY BOUNDARIES
- NATURAL GAS
- STORM DRAIN / SEWER
- OVERHEAD ELECTRIC
- WATER
- FIBER OPTICS
- UNDERGROUND ELECTRIC
- TELEPHONE
- PROPERTY LINE



North

# 1.0

**Cardno**  
ATC

Shaping the future

PROPOSED REPLACEMENT WELL LOCATIONS

FOUNDER, COASTAL MART #9157  
1825 WEST 21ST STREET NORTH  
WICHITA, KANSAS

PROJECT NUMBER: 177500025956	DOCUMENT: MONITORING REPORT	DRAWN BY: MW 12/18/14
FILE PATH: 358-F1.DWG		CHECKED BY: MW 12/18/14