
WATER WELL RI	CORD	Form V	VWC-5		vision of Water		Well ID 723F	<u>`</u>	
Original Record	Correction		e in Well Use		ources App. No.			er	
1 LOCATION OF WA	TER WEL		Fraction		ction Number	Township Number	R 1 E E		
County: Sedgwick			SW 1/4 NE 1/4 NW 1/	4 NE 1/4	28	T 27 S			
2 WELL OWNER: Las	st Name:		First:	Street or Ri	ural Address w	here well is located	(if unknown, distance and	a . —	
Business: City of Wic				direction from	nearest town or in	ntersection): If at owner	's address, check here:	·	
Address: 1900 E. 9tl		NEC of Laura Ave. and Orme St., Wichita							
Address.					IAPA OF PRINTED AND AND AND AND AND AND AND AND AND AN				
City: Wichita		State: KS	ZIP: 67214	L			10		
3 LOCATE WELL	4 DEPTE	OF COM	IPLETED WELL:	23.50	ft. 5 Latitud	le: N 37.6776	10(decimal deg	grees)	
WITH "X" IN	Denth(s) G	roundwater	Encountered: 1)	ft.	Longity	ude: W 97.323	1780 (decimal de	grees)	
SECTION BOX:	2)	ft.	3) ft., or 4)	Dry Well	Horizon	Horizontal Datum: WGS 84 NAD 83 NAD 27			
N	WELL'S S	TATIC WA	TER LEVEL:	ft.		Source for Latitude/Longitude:			
	☐ below	land surface	, measured on (mo-day	/-yr)		GPS (unit make/model:)			
NW NE	above i	land surface	, measured on (mo-day	/-yr)		(WAAS enabled? ☐ Yes ☐ No)			
	Pump test of	lata: Well v	vater was	ft.	☐ Lar	☐ Land Survey ☐ Topographic Map			
w E	after		s pumping		☐ On!	Online Mapper:			
SW SE			vater was						
			s pumping	gpm	6 Elevation: 1296.30 ft. Ground Level TOC				
	Estimated	Yield:	3.6 in to 23.5	O A and	Source:	Source: Land Survey GPS Topographic Map			
S	Bore Hole	Diameter:		A II. aliu		Other			
1 mile	DE LICER		in. to	14.					
7 WELL WATER TO			otor Cumply: 12/011 ID		10 🗀 🖼	Field Water Supply: le	ease		
1. Domestic:			ater Supply: well ID ng: how many wells? .			ole: well ID			
☐ Household☐ Lawn & Garden						ed Uncased 0	Geotechnical		
Lawn & Garden	/. L R ■	☐ Monitoria ☐ Monitoria	echarge: well ID g: well ID	23R	12. Geothe	rmal: how many bores	s?		
2. Irrigation			al Remediation: well			sed Loop Horizont	al 🔲 Vertical		
3. Feedlot		Air Sparg			b) Ope	en Loop Surface Di	scharge 🔲 Inj. of Wa	ater	
4. ☐ Industrial	_	Recovery			13. 🗍 Oth	er (specify):			
Water well disinfected? No CASNIC IONITS: Church Colombia Welded Threaded									
8 TYPE OF CASING USED: Steel PVC Other CASING JOINTS: Glued Clamped Welded Threaded Casing diameter 1 in. to 23.5 ft., Diameter 2 in. to 3 ft., Diameter in. to 5 ft.									
Casing height above land surface 0 in. Weight lbs./ft. Wall thickness or gauge No. 40									
TYPE OF SCREEN OR PERFORATION MATERIAL:									
Steel Stainless Steel Fiberglass ■ PVC Other (Specify)									
☐ Brass ☐ Galvanized Steel ☐ Concrete tile ☐ None used (open hole)									
SCREEN OR PERFORATION OPENINGS ARE:									
☐ Continuous Slot ■ Mill Slot ☐ Gauze Wrapped ☐ Torch Cut ☐ Drilled Holes ☐ Other (Specify)									
Louvered Shutter Key Punched Wire Wrapped Saw Cut None (Open Hole)									
SCREEN-PERFORATED INTERVALS: From .13.5 ft. to .23.5 ft., From ft., From ft., From ft. to ft.									
GRAVEL PACK INTERVALS: From									
9 GROUT MATERIAL: Neat cement Cement grout Bentonite Other.									
Grout Intervals: From									
Nearest source of possible contamination:									
☐ Septic Tank		Lateral Line	es 🔲 Pit Privy	Ε	Livestock Pens	Insectio	ide Storage		
☐ Sewer Lines	_	Cess Pool	☐ Sewage L		Fuel Storage		oned Water Well		
☐ Watertight Sewer Line		Seepage Pit] Fertilizer Stora	ge 🔲 Oil Wel	ll/Gas Well		
Other (Specify)									
Direction from well?			Distance from v						
10 FROM TO		LITHOLOG	SIC LOG	FROM	TO L	ITHO. LOG (cont.) or	PLUGGING INTERV	ALS	
0 23.5 L	ithology no	t logged							
				<u> </u>					
				Notes:	Annular space be	etween 1" and 2" casing	(from 0'-3' bg) sealed	with	
				concrete.					
				- CONCIDER.					
11 CONTRACTOR'S OR LANDOWNER'S CERTIFICATION: This water well was constructed, reconstructed, or plugged									
under my jurisdiction and	d was compl	leted on (m	o-day-year) .0.3/24/	20.16 and	this record is	true to the best of my	knowledge and beli	ief.	
under my jurisdiction and was completed on (mo-day-year) .03/24/20.16 and this record is true to the best of my knowledge and belief. Kansas Water Well Contractor's License No. 531 This Water Well Record was completed for (mo-day-year) .06/02/20.16									
under the business name of GSI Engineering, LLC Signature 44.4.									
Mail 1 white copy along with a fee of \$5.00 for each constructed well to: Kansas Department of Health and Environment, Bureau of Water, GWTS Section,									
1000 SW Jackson St., Suite 420, Topeka, Kansas 66612-1367. Mail one to Water Well Owner and retain one for your records. Telephone 785-296-5524.									
Visit us at http://www.kdheks.s	gov/waterwell/i	ndex.html		KSA 82a-1	212		Revised 7/10/2015	5	

GILMO Proposed Replacement Well - 723 R





This information is not an official record, and cannot be used as such. The user should rely only upon official records available from the custodian of records in the appropriate City and/or County department. Some data provided here and used for the preparation of these maps has been obtained from public records not created or maintained by the City of Wichita.

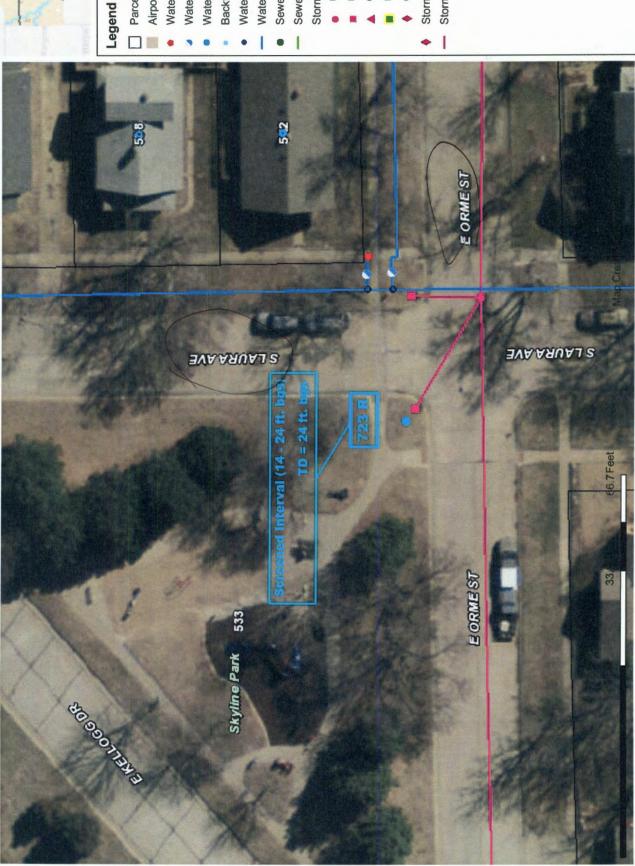

Parcels

Water Hydrants Airport Runway

Water Valves

Water Service Taps Backflow Devices

Water Nodes

Water Mains

Sewer Manholes

Sewer Mains

Storm Structures

Storm Headwalls Storm Conduit



1:400