
WATER WELL RECORD Form WWC-5				Division of Water 271R						
Original Record			Resources App. No.			Well ID				
1 LOCATION OF WA	ATER WELL:	Fraction		Section Number	er	Township Numbe		ge Number		
County: Sedgwick		1/4 SE 1/4 NE 1/4		32		T 27 S		ØE ■/W		
2 WELL OWNER: Last Name: First: Street or Rural Address where well is located (if unknown, distance and										
Business: City of Wichita direction from nearest town or intersection): If at owner's address, check here:										
Address: 1900 E. 9th Address: EAST								AST		
City: Wichita State: KS ZIP: 67214										
3 LOCATE WELL				1						
WITH "X" IN	4 DEPTH OF COMPLETED WELL:26.00 ft. 5 Latitude: N 37.663669 (dec									
SECTION BOX:	Depth(s) Groundwater Encountered: 1) ft.				Longitude: W 97.345560 (decimal degrees)					
N N	2) ft. 3	l <u>Horiz</u>	Horizontal Datum: ☐ WGS 84 ■ NAD 83 ☐ NAD 27							
	WELL'S STATIC WA		Source for Latitude/Longitude:							
	below land surface		— • • • • • • • • • • • • • • • • • • •							
NW NE	above land surface,									
	Pump test data: Well w		☐ Land Survey ☐ Topographic Map							
WE	after hours		Online Mapper:							
SW SE	Well w									
92	after hours	6 Eleva	6 Elevation: 1292.75ft. Ground Level TOC							
	Estimated Yield:gpm Bore Hole Diameter:3.6 in. to26.00. ft. and			Source	Source: Land Survey GPS Topographic Map					
S	Bore Hole Diameter:	Source Source	Other							
1 mile III. W III.										
7 WELL WATER TO BE USED AS: 1. Domestic: 5. □ Public Water Supply: well ID										
1. Domestic:										
Household		g: how many wells?				well ID				
, —	□ Lawn & Garden 7. □ Aquifer Recharge: well ID □ Livestock 8. ■ Monitoring: well ID					☐ Cased ☐ Uncased ☐ Geotechnical				
Livestock						12. Geothermal: how many bores?				
2. Irrigation						a) Closed Loop ☐ Horizontal ☐ Vertical b) Open Loop ☐ Surface Discharge ☐ Inj. of Water				
3. Feedlot	☐ Air Sparge		Extraction							
4. Industrial Recovery Injection 13. Other (specify):										
Was a chemical/bacteriological sample submitted to KDHE? Yes No If yes, date sample was submitted:										
Water well disinfected? ☐ Yes ■ No										
8 TYPE OF CASING USED: Steel PVC Other CASING JOINTS: Glued Clamped Welded Threaded										
Casing diameter										
Casing height above land surface										
TYPE OF SCREEN OR PERFORATION MATERIAL:										
☐ Steel ☐ Stainless Steel ☐ Fiberglass ☐ PVC ☐ Other (Specify)										
☐ Brass ☐ Galvanized Steel ☐ Concrete tile ☐ None used (open hole)										
SCREEN OR PERFORATION OPENINGS ARE:										
☐ Continuous Slot ■ Mill Slot ☐ Gauze Wrapped ☐ Torch Cut ☐ Drilled Holes ☐ Other (Specify)										
□ Louvered Shutter □ Key Punched □ Wire Wrapped □ Saw Cut □ None (Open Hole)										
SCREEN-PERFORATED INTERVALS: From .16 ft. to .26 ft., From ft. to ft., From ft. to ft.										
GRAVEL PACK INTERVALS: From14.5. ft. to26 ft., From ft. to ft., From ft., From ft.										
9 GROUT MATERIAL: Neat cement Cement grout Bentonite Other										
Grout Intervals: From										
Nearest source of possible contamination:										
☐ Septic Tank ☐ Lateral Lines ☐ Pit Privy ☐ Livestock Pens ☐ Insecticide Storage										
□ Sewer Lines □ Cess Pool □ Sewage Lagoon □ Fuel Storage □ Abandoned Water Well										
☐ Watertight Sewer Lines ☐ Seepage Pit ☐ Feedyard ☐ Fertilizer Storage ☐ Oil Well/Gas Well										
☐ Other (Specify) Direction from well? Distance from well? ft.										
							LICORY	C DITERMAL C		
10 FROM TO	LITHOLOG	aic LUG	FROM	TO	LITH	IO. LOG (cont.) or I	LUGGIN	JINIEKVALS		
0 26 L	ithology not logged									
			-							
					_					
			Notes:	Annular space	betwe	en 1" and 2" casing	(from 0'-3'	bg) sealed with		
concrete.										
				••						
11 CONTRACTOR'S OR LANDOWNER'S CERTIFICATION: This water well was constructed, reconstructed, or plugged										
under my jurisdiction and was completed on (mo-day-year) .03/25/20.16 and this record is true to the best of my knowledge and belief.										
Kansas Water Well Contractor's License No. 531 This Water Well Record was completed on Inno-day-year) 06/02/2016										
under the business name of GSI Engineering, LLC										
Mail 1 white copy along with a fee of \$5.00 for each constructed well to: Kansas Department of Health and Environment, Bureau of Water, GWTS Section,										
1000 SW Jackson St., Suite 420, Topeka, Kansas 66612-1367. Mail one to Water Well Owner and retain one for your records. Telephone 785-296-5524.										
Visit us at http://www.kdheks.gov/waterwell/index.html KSA 82a-1212 Revised 7/10/2015										



GILMO Proposed Replacement Well - 271 R





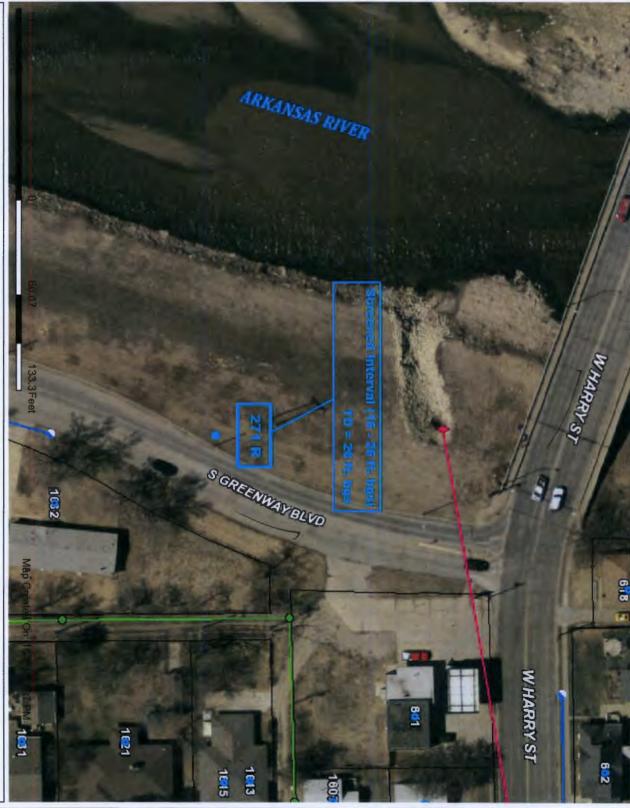

Legend

- **Parcels**
- Airport Runway
- Water Hydrants Water Valves
- **Backflow Devices** Water Service Taps

Water Nodes

- Sewer Mains Sewer Manholes Water Mains
- Storm Structures Manhole

Outfall

Storm Headwalls Storm Conduit

Other BMP



This information is not an official record, and cannot be used as such. The user should rely only upon official records available from the custodian of records in the appropriate City and/or County department. Some data provided here and used for the preparation of these maps has been obtained from public records not created or maintained by the City of Wichita.



