
	R WELL I		rm WWC-5		Division of Water	1		AMW-1	
			Change in Well Use		esources App. N		Well ID		
1 LOCATION OF WATER WELL: Fraction SE 1/4 SW 1/2					Section Number Township Number Range Number T 27 S R 1 E				
	-		SE 1/4 SW 1/4 SE 1						
2 WELL OWNER: Last Name: First: Street or Rural Address where well is located (if unknown, distance and direction from nearest town or intersection): If at owner's address, check here:									
Address		Parkway, Suite 2		!					
Address: 750 E 21st Street N, Wichita									
City:	Wilmingto	on State:	DE ZIP: 19803						
3 LOCAT		4 DEPTH OF C	COMPLETED WELL:	23	ft. 5 Latitu	de: 37.7227	15	(decimal degrees)	
Donth(s) Groundwater Encountered: 1)						Longitude: -97.329124 (decimal degrees)			
SECTION BOX: 2) ft. 3) ft., or 4) [Dry Well	Well Horizontal Datum: WGS 84 NAD 83 NAD 27				
, , , , , , , , , , , , , , , , , , ,	· ·	WELL'S STATIC	WATER LEVEL:1	1.4 ft.		for Latitude/Longitude			
] '	below land surface, measured on (mo-c								
NW	above land surface, measured on (mo-day-					(WAAS enabled? ☐ Yes ☐ No) ☐ Land Survey ☐ Topographic Map			
Fullipliest data. Well water was						☐ Cand Survey ☐ Topographic Map Colline Mapper: Google Earth			
1 1 '	1 '		Vell water was		_ OI	inic Mapper			
after hours pumping.				. gpm	(E)			и пос	
L X		Estimated Yield: .	gpm			6 Elevation:ft. ☐ Ground Level ☐ TOC Source: ☐ Land Survey ☐ GPS ☐ Topographic Map			
S Bore Hole Diameter:			er: 8.25 in to 25	ft. and	Source		Other		
mile in. to									
7 WELL 1. Domestic			o Woter Supply: well ID		10 🗆 00	Field Water Supply: 1	9959		
	Domestic: 5. ☐ Public Water Supply: well ID ☐ Household 6. ☐ Dewatering: how many wells?					10. Oil Field Water Supply: lease			
	☐ Lawn & Garden 7. ☐ Aquifer Recharge: well ID				🔲 Cas	☐ Cased ☐ Uncased ☐ Geotechnical			
☐ Livest	☐ Livestock 8. ■ Monitoring: well IDAM\				12. Geothe	12. Geothermal: how many bores?			
2. Irrigation 9. Environmental Remediation: well ID						a) Closed Loop _ Horizontal U Vertical			
3. ☐ Feedlot ☐ Air Sparge ☐ Soil Vapor E						b) Open Loop Surface Discharge Inj. of Water 13. Other (specify):			
4. Indust		☐ Reco							
Was a chemical/bacteriological sample submitted to KDHE? ☐ Yes ■ No If yes, date sample was submitted:									
Water well disinfected? Yes ■ No									
8 TYPE OF CASING USED: ☐ Steel ■ PVC ☐ Other									
Casing diameter 2 in. to 8 ft., Diameter in. to									
Casing height above land surface									
Steel ☐ Stainless Steel ☐ Fiberglass ■ PVC ☐ Other (Specify)									
☐ Brass ☐ Galvanized Steel ☐ Concrete tile ☐ None used (open hole)									
SCREEN OR PERFORATION OPENINGS ARE:									
☐ Continuous Slot ☐ Mill Slot ☐ Gauze Wrapped ☐ Torch Cut ☐ Drilled Holes ☐ Other (Specify)									
☐ Louvered Shutter ☐ Key Punched ☐ Wire Wrapped ☐ Saw Cut ☐ None (Open Hole)									
SCREEN-PERFORATED INTERVALS: From .8									
GRAVEL PACK INTERVALS: From 6 ft. to 25 ft., From ft. to ft., From ft. to ft.									
9 GROUT MATERIAL: Neat cement Cement grout Bentonite Other Concrete Grout Intervals: From									
Nearest source of possible contamination:									
Septic		Lateral	Lines	1	Livestock Pen	s 🗆 Insectio	cide Storage		
Sewer		Cess Po	,		☐ Fuel Storage		oned Water		
☐ Watertight Sewer Lines ☐ Seepage Pit ☐ Feedyard ☐ Fertilizer Storage ☐ Oil Well/Gas Well									
Other	(Specify) .Co	ontaminated site (f	ormer refinery)						
			Distance from v					C D ITTO VIA I	
10 FROM	TO		LOGIC LOG	FROM	TO I	ITHO. LOG (cont.) or	PLUGGING	JINTERVALS	
0.5		Concrete (sidewal	ik)		+				
2		Fill sand Clay, Reddish Bla	ماد		+				
4		Sand w/Clay, Wea							
6.5		Sand, clayey, Red			 				
12.5		Clay, Dusky Red							
13		Sand, Weak Red		Notes:					
10		Cana, Woak Roa							
11 CONTRACTOR'S OR LANDOWNER'S CERTIFICATION: This water well was constructed, reconstructed, or plugged									
under my jurisdiction and was completed on (mo-day-year) 9/19/2016 and this record is true to the best of my knowledge and belief									
Kansas Water Well Contractor's License No. 527 This Water Well Record was completed on (mordey-year) 10/17/2016									
under the business name of GeoCore Inc. Signature Life Court of C									
Mail 1 white copy along with a fee of \$5.00 for each constructed well to: Kansas Department of Health and Environment, Bufeau of Water, GWTS Section, 1000 SW Jackson St., Suite 420, Topeka, Kansas 66612-1367. Mail one to Water Well Owner and retain one for your records. Telephone 785-296-5524.									
		t Suite 420 Toneka Ka	nsas 66612-1367 Mail one to	Water Well O	wner and retain on	for your records Talanh	one 785, 206	5524	



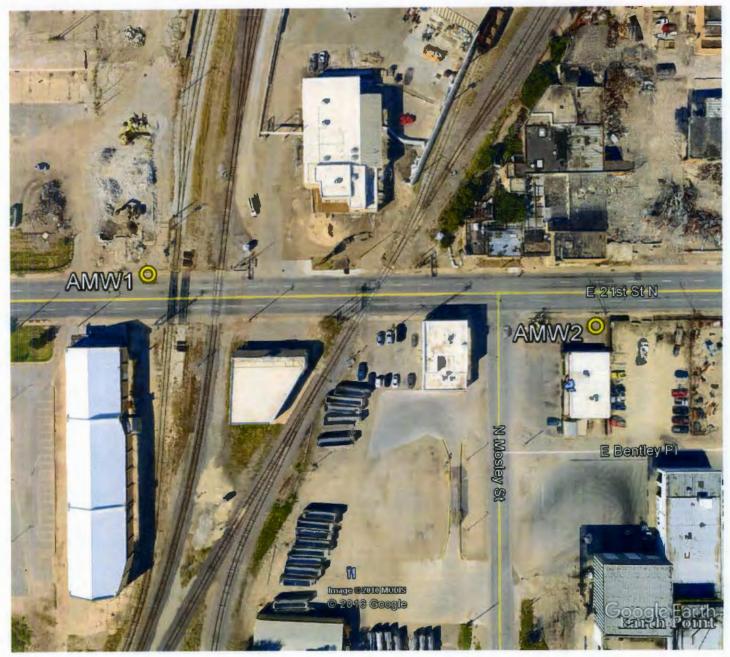

feet 400 meters 100

A

Former Barnsdall Refinery, currently owned by Evergreen Resources Management Operations Facility address:

Between E 25th & E 29th Streets and N Broadway & Mead Streets, Wichita

GPS Coordinates:

AMW-1: 37.722715, -97.329124 AMW-2: 37.722540, -97.327303