

WATER WELL RECORD Form WWC-5

Division of Water Resources App. No.


Well ID MW 3

Original Record Correction Change in Well Use

1 LOCATION OF WATER WELL: County: <u>Sedgewick</u>	Fraction <u>¼ SE ¼ SE ¼ SE ¼</u>	Section Number <u>1</u>	Township Number <u>T 27 S</u>	Range Number <u>R 1 E W</u>
--	-------------------------------------	----------------------------	----------------------------------	--------------------------------

2 WELL OWNER: Last Name: _____ First: _____ Business: <u>American Eagle</u> Address: _____ Address: <u>6330 East 21st Street</u> City: <u>Wichita</u> State: <u>KS</u> ZIP: <u>67208</u>	Street or Rural Address where well is located (if unknown, distance and direction from nearest town or intersection): If at owner's address, check here: <input type="checkbox"/> <u>Former Kum & Go #328</u> <u>6330 East 21st Street, Wichita, KS 67208</u>
---	---

3 LOCATE WELL WITH "X" IN SECTION BOX:
N

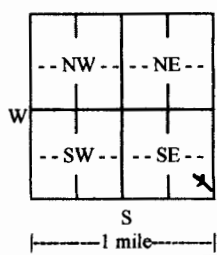

4 DEPTH OF COMPLETED WELL: 15 ft.
 Depth(s) Groundwater Encountered: 1) ft.
 2) ft. 3) ft., or 4) Dry Well
WELL'S STATIC WATER LEVEL: ft.
 below land surface, measured on (mo-day-yr)
 above land surface, measured on (mo-day-yr)
 Pump test data: Well water was N/A ft.
 after N/A hours pumping N/A gpm
 Well water was N/A ft.
 after N/A hours pumping N/A gpm
 Estimated Yield: N/A gpm
 Bore Hole Diameter: 8.25 in. to 15 ft. and
 N/A in. to N/A ft.

5 Latitude: 37.723222 (decimal degrees)
Longitude: -97.26285 (decimal degrees)
Horizontal Datum: WGS 84 NAD 83 NAD 27
Source for Latitude/Longitude:
 GPS (unit make/model:)
 (WAAS enabled? Yes No)
 Land Survey Topographic Map
 Online Mapper: Google Earth

6 Elevation: 1391 ft. Ground Level TOC
Source: Land Survey GPS Topographic Map
 Other

7 WELL WATER TO BE USED AS:

1. Domestic: <input type="checkbox"/> Household <input type="checkbox"/> Lawn & Garden <input type="checkbox"/> Livestock	5. <input type="checkbox"/> Public Water Supply: well ID 6. <input type="checkbox"/> Dewatering: how many wells? 7. <input type="checkbox"/> Aquifer Recharge: well ID 8. <input checked="" type="checkbox"/> Monitoring: well ID <u>MW-3</u>	10. <input type="checkbox"/> Oil Field Water Supply: lease 11. Test Hole: well ID <input type="checkbox"/> Cased <input type="checkbox"/> Uncased <input type="checkbox"/> Geotechnical
2. <input type="checkbox"/> Irrigation	9. Environmental Remediation: well ID <input type="checkbox"/> Air Sparge <input type="checkbox"/> Soil Vapor Extraction <input type="checkbox"/> Recovery <input type="checkbox"/> Injection	12. Geothermal: how many bores? a) Closed Loop <input type="checkbox"/> Horizontal <input type="checkbox"/> Vertical b) Open Loop <input type="checkbox"/> Surface Discharge <input type="checkbox"/> Inj. of Water
3. <input type="checkbox"/> Feedlot	4. <input type="checkbox"/> Industrial	13. <input type="checkbox"/> Other (specify):

Was a chemical/bacteriological sample submitted to KDHE? Yes No If yes, date sample was submitted:
 Water well disinfected? Yes No

8 TYPE OF CASING USED: Steel PVC Other **CASING JOINTS:** Glued Clamped Welded Threaded
 Casing diameter 2 in. to 5 ft., Diameter N/A in. to N/A ft., Diameter N/A in. to N/A ft.
 Casing height above land surface 0 in. Weight N/A lbs./ft. Wall thickness or gauge No. Sch 40

TYPE OF SCREEN OR PERFORATION MATERIAL:
 Steel Stainless Steel Fiberglass PVC Other (Specify)
 Brass Galvanized Steel Concrete tile None used (open hole)

SCREEN OR PERFORATION OPENINGS ARE:
 Continuous Slot Mill Slot Gauze Wrapped Torch Cut Drilled Holes Other (Specify)
 Louvered Shutter Key Punched Wire Wrapped Saw Cut None (Open Hole)

SCREEN-PERFORATED INTERVALS: From 5 ft. to 15 ft., From N/A ft. to N/A ft., From N/A ft. to N/A ft.
GRAVEL PACK INTERVALS: From 3 ft. to 15 ft., From N/A ft. to N/A ft., From N/A ft. to N/A ft.

9 GROUT MATERIAL: Neat cement Cement grout Bentonite Other 0 to 1 Concrete
 Grout Intervals: From 1 ft. to 3 ft., From N/A ft. to N/A ft., From N/A ft. to N/A ft.

Nearest source of possible contamination:
 Septic Tank Lateral Lines Pit Privy Livestock Pens Insecticide Storage
 Sewer Lines Cess Pool Sewage Lagoon Fuel Storage Abandoned Water Well
 Watertight Sewer Lines Seepage Pit Feedyard Fertilizer Storage Oil Well/Gas Well
 Other (Specify)

Direction from well? NE Distance from well? 75 ft.

10 FROM	TO	LITHOLOGIC LOG	FROM	TO	LITHO. LOG (cont.) or PLUGGING INTERVALS
0	6"	Concrete			
6"	15	Clay			

Notes:

11 CONTRACTOR'S OR LANDOWNER'S CERTIFICATION: This water well was constructed, reconstructed, or plugged under my jurisdiction and was completed on (mo-day-year) 10-16-17 and this record is true to the best of my knowledge and belief. Kansas Water Well Contractor's License No. 759 This Water Well Record was completed on (mo-day-year) 11-5-17 under the business name of RAZEK Environmental, LLC Signature [Signature]

Mail 1 white copy along with a fee of \$5.00 for each constructed well to: Kansas Department of Health and Environment, Bureau of Water, GWTS Section, 1000 SW Jackson St., Suite 420, Topeka, Kansas 66612-1367. Mail one to Water Well Owner and retain one for your records. Telephone 785-296-5524.

DENNIS L HANDKE

1820 NW 59th Terrace
TOPEKA, KANSAS 66618
785-286-4047 Home
785-217-5864 Cell

Meredith Watson
TerraNext, LLC
11904 Grandview Ave.
Grandview, Missouri, 64030

November 3, 2017

RE: Monitor Well Elevation Survey
6330 E. 21th Street, Wichita, Kansas

Proj. 17-00GG
Kum & Go #328

Bench Mark: Chisled X on the top NW bolt of NW concrete signal light base near SE corner of property.
Elev: 1389.49 North 45.10 West 55.41 (from SE Cor. Sec.1-27-1E)

MW-1R	rim	1390.43	North	61.23	West	109.41	SE1/4,SE1/4,SE1/4,SE1/4
	top pipe	1390.18					Lat= 37.72318 Long = 97.26267
MW-2R	rim	1389.87	North	95.51	West	85.90	SE1/4,SE1/4,SE1/4,SE1/4
	top pipe	1389.63					Lat= 37.72328 Long = 97.26259
MW-3R	rim	1390.55	North	60.79	West	175.27	SE1/4,SE1/4,SE1/4,SE1/4
	top pipe	1390.31					Lat= 37.72318 Long = 97.26290
MW-4R	rim	1391.13	North	131.69	West	179.37	SE1/4,SE1/4,SE1/4,SE1/4
	top pipe	1390.85					Lat= 37.72338 Long = 97.26292
MW-5R	rim	1389.92	North	56.29	West	66.79	SE1/4,SE1/4,SE1/4,SE1/4
	top pipe	1389.65					Lat= 37.72317 Long = 97.26253
MW-8R	rim	1387.84	North	152.66	East	79.36	SW1/4,SW1/4,SW1/4,SW1/4 (Sec. 6-27-2)
	top pipe	1387.48					Lat= 37.72344 Long = 97.26202



Elevation derived from City of Wichita Bench Mark.NAVD88

Lat & Long derived from Wichita East 7.5 minute Quad Map WGS84.

If you have any questions, please feel free to call me. Thank you for the opportunity to be of service to you.

November 3, 2017
Dennis L. Handke RS

Dennis L Handke

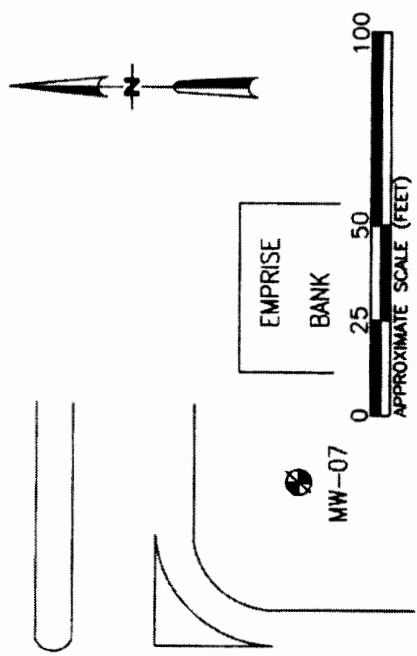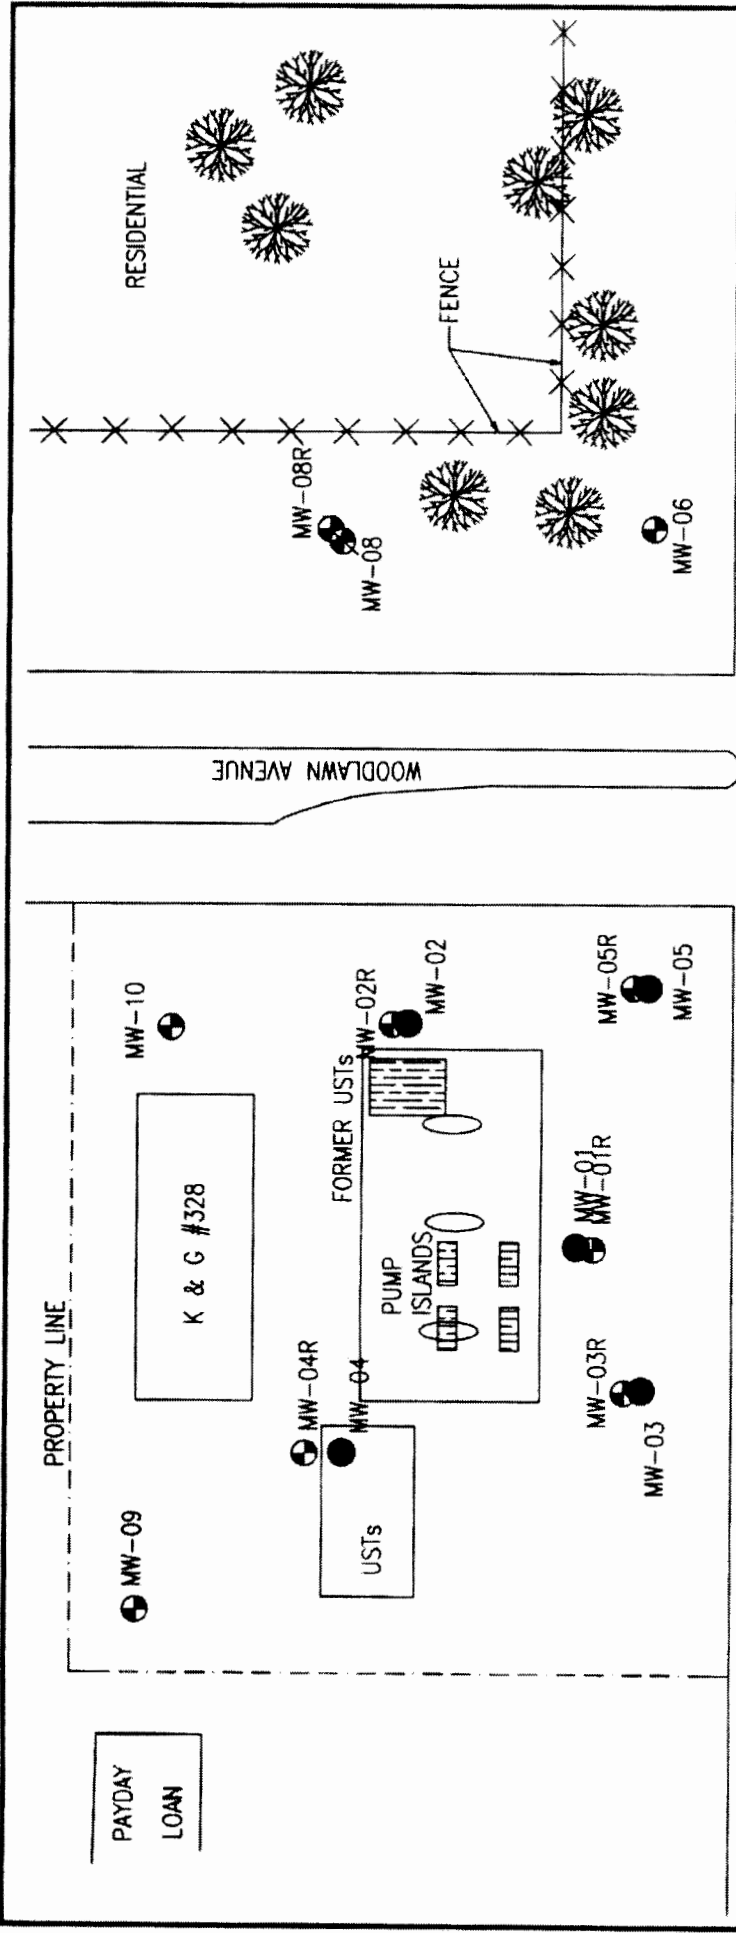

LEGEND

- MONITORING WELL
- ⊗ DESTROYED MONITORING WELL
- - - PROPERTY LINE
- 415 TOTAL BTEX CONC. IN ug/l
- 100- TOTAL BTEX ISOCONC. LINE
- ND NOT DETECTED
- NS NOT SAMPLED
- BENCHMARK LOCATION UNKNOWN

PROJ.# 17102233	PAGE#
SCALE: AS SHOWN	DRAWN BY:
FILE NO. 2233-F2	DESIGNED BY:
DATE:	APPROVED BY:



FIGURE 1
SITE MAP
 OCTOBER 17, 2017
 KUM & GO #328
 6330 EAST 21ST STREET
 WICHITA, KANSAS