
## KOLAR Document ID: 1493996

	WELL R			WWC-5			ion of Wate							
		Correction		e in Well Use			rces App. N		T 1' 1 1	Well ID				
1 LOCATION OF WATER WELL:			Fraction         S $\frac{1}{4}$ $\frac{1}{4}$ $\frac{1}{4}$			Section Number Township Num T S				nge Number				
County	<u>y:</u> OWNER: La			1/4         T         S         R           Street or Rural Address where well is located (if unknown, d										
2 WELL Business:		ist Name:		First:		irection from nearest town or intersection): If at owner's address, check here:								
Address:					unection	ection from nearest town or intersection). If at owner's address, check here.								
Address:														
City:		I	State:	ZIP:										
3 LOCAT		4 DEPTH	OF COM	<b>IPLETED WELL:</b>		ft.	5 Latiti	ıde.			(decimal degrees)			
	WITH "A" IN Donth(c) Croundwater Encountered: 1)													
<b>SECTION BOX:</b> 2) ft. 3) ft., or 4) $\Box$ 1						Dry Well Datum: WGS 84 NAD 83 NAD 27								
WELL'S STATIC WATER LEVEL:						Source for Eathade, Eoligitade.								
				, measured on (mo-day-yr)										
NW	NE			vater was ft.										
			s pumping gpm			□ Land Survey □ Topographic Map □ Online Mapper:								
Well w			vater was ft.											
			pumping gpm			6 Elevation:ft. Ground Level TOC								
		Estimated Y							Land Survey $\Box$					
			in. to ft. and ft. in. to ft.			Source		Other						
		BE USED A		III. 10	11.									
7 WELL WATER TO BE USED AS:         1. Domestic:       5. <ul> <li>Public Water Supply: well ID</li> <li>10.              <li>Oil Field Water Supply: lease</li> </li></ul>														
				g: how many wells?			11. Test Hole: well ID							
	□ Lawn & Garden 7. □ Aquifer R			echarge: well ID			Cased Uncased Geotechnical				ıl			
				g: well ID				al: how many bores						
2. 🗌 Irrigati				al Remediation: well I					Loop 🗌 Horizont					
3. ☐ Feedlo 4. ☐ Industi			Air Sparge Recovery		Extraction	1			Loop 🗌 Surface Di (specify):					
			,	5										
				itted to KDHE?	Yes 🗋	No I	If yes, date	e sar	nple was submitte	d:				
	disinfected?			C 🗌 Other	C	ACINI	C IOINTS	· 🗖			d 🗖 Threadad			
				Diameter										
				Weight					s or gauge No.					
	SCREEN OR													
□ Steel		less Steel		$\square$ PVC			🗌 Oth	ner (S	Specify)					
□ Brass		anized Steel			used (oper	n hole)								
	OR PERFOR							_						
	nuous Slot	☐ Mill Slot					lled Holes ne (Open H		Other (Specify)					
		C Key Punch		$\square$ s $\square$ s						ft to	ft			
				n ft. to	,				,					
				Cement grout B										
				ft., From							••••			
	rce of possible		on: No	potential source of co	ntaminatio	n withi	in 200 ft.							
			Lateral Line				ivestock Pe			cide Storage				
Sewer			Cess Pool	Sewage L			uel Storage			oned Water				
	ight Sewer Lin			☐ Feedyard		$\Box$ F	ertilizer Sto	rage		ll/Gas Well				
Direction from well? ft.														
10 FROM	TO		ITHOLOG		FRO		ТО	LIT	HO. LOG (cont.) or	PLUGGIN	G INTERVALS			
					Nata									
					Notes									
11 CONTRACTOR'S OR LANDOWNER'S CERTIFICATION: This water well was constructed, reconstructed, or plugged														
under my j	urisdiction an	d was compl	eted on (n	no-day-year)		and th	nis record i	is tru	ie to the best of m	y knowled	ge and belief.			
Kansas Wa	ter Well Con	tractor's Lice	ense No	This W	ater Well	Reco	rd was cor	nple	ted on (mo-day-ye	ear)	-			
under the b	usiness name	of	WATED	ELL OWNER and retain	one for ve-		de Foo of ¢f		or each constructed					
KS Departr											e 785-296-3565.			
	KS Department of Health and Environment, Bureau of Water, Geology Section, 1000 SW Jackson St., Suite 420, Topeka, Kansas 66612-1367. Telephone 785-296-3565. Visit us at http://www.kdheks.gov/waterwell/index.html KSA 82a-1212													

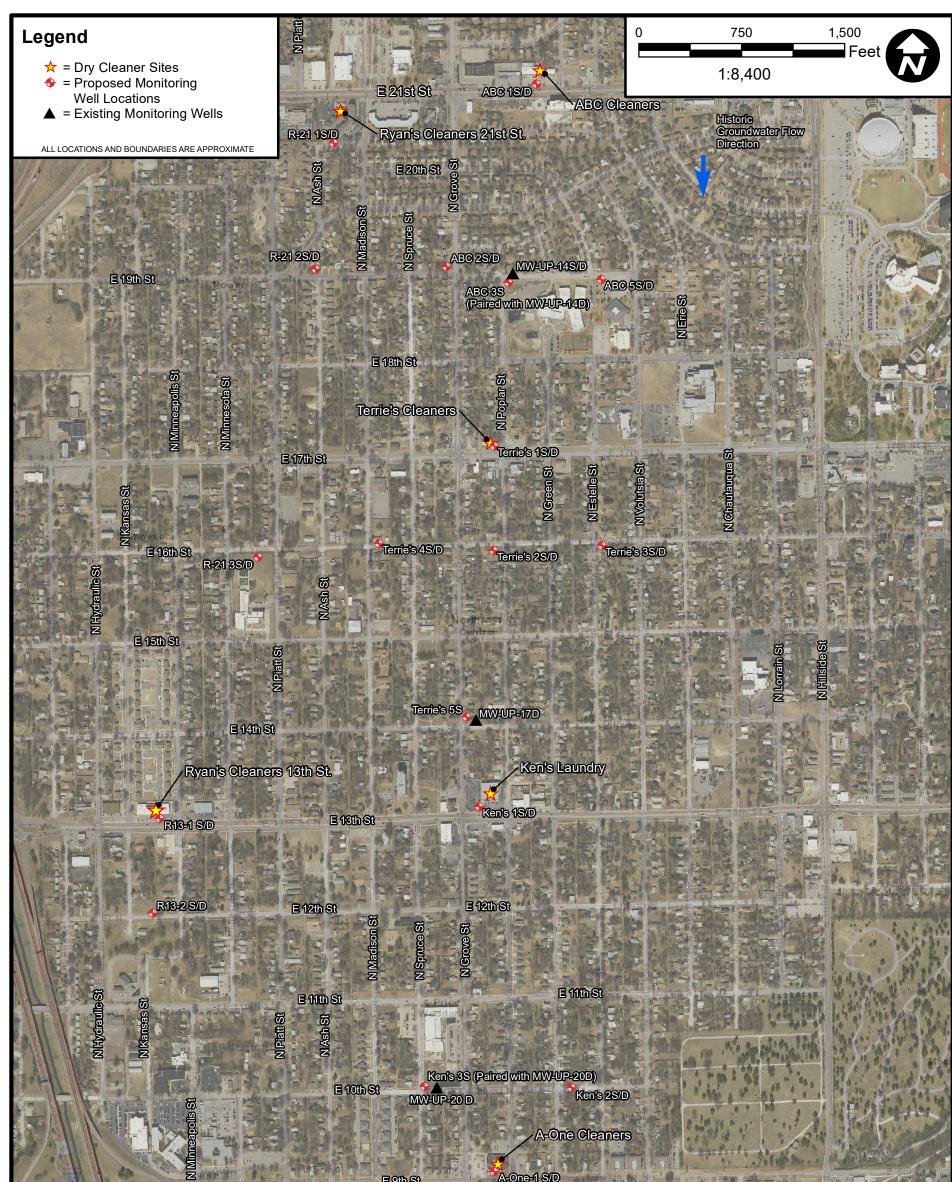

But I	E 9th St	A-One-1 S/D		T- LUMA	
		E 8th St A-One-2 S/D			
	Murdock St	A-One-3 S/D			
	e-4 S/D One-5 S/D A-One-6 S/D	Elm St	G	4503 East 4 Wichita, KS 316-554-072	67210
SITE BASE MAP WITH PROPOSED MONITORING WELL LOCATIONS	19th & Grove Dry ( Wichita, K	PROJECT #: 1874235 DATE: 2019-01-10	DRAWN BY: CD PROJ. MNGR: KW	figure	